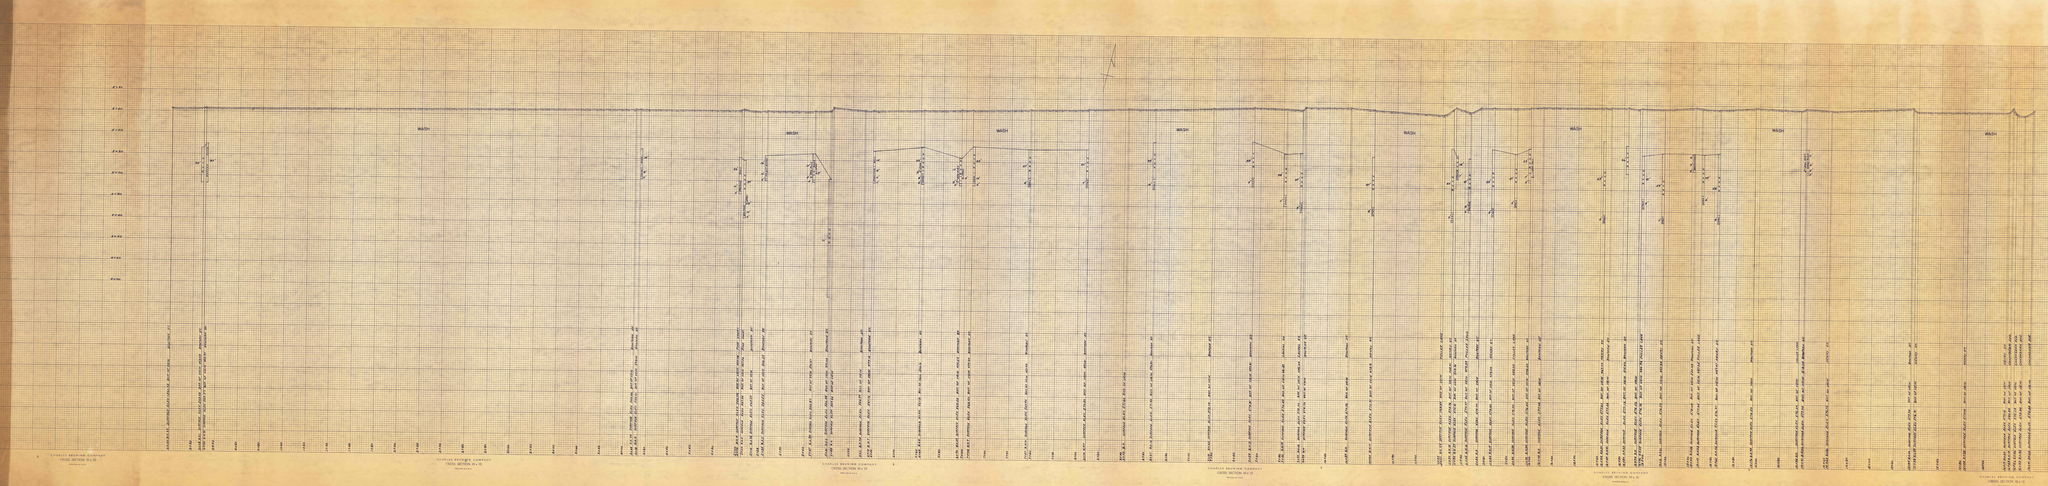

BOREHOLES FOR FLUSHING PROJECT FE405-2
IN
HILLMAN VEIN
OF THE
ABANDONED BALTIMORE COLLIERY
BOWMAN STREET AND ADJACENT AREA
WILKES-BARRE, LUZERNE COUNTY, PENNA.
SCALE
1"=20' HOR. & 1"=20' VERT.