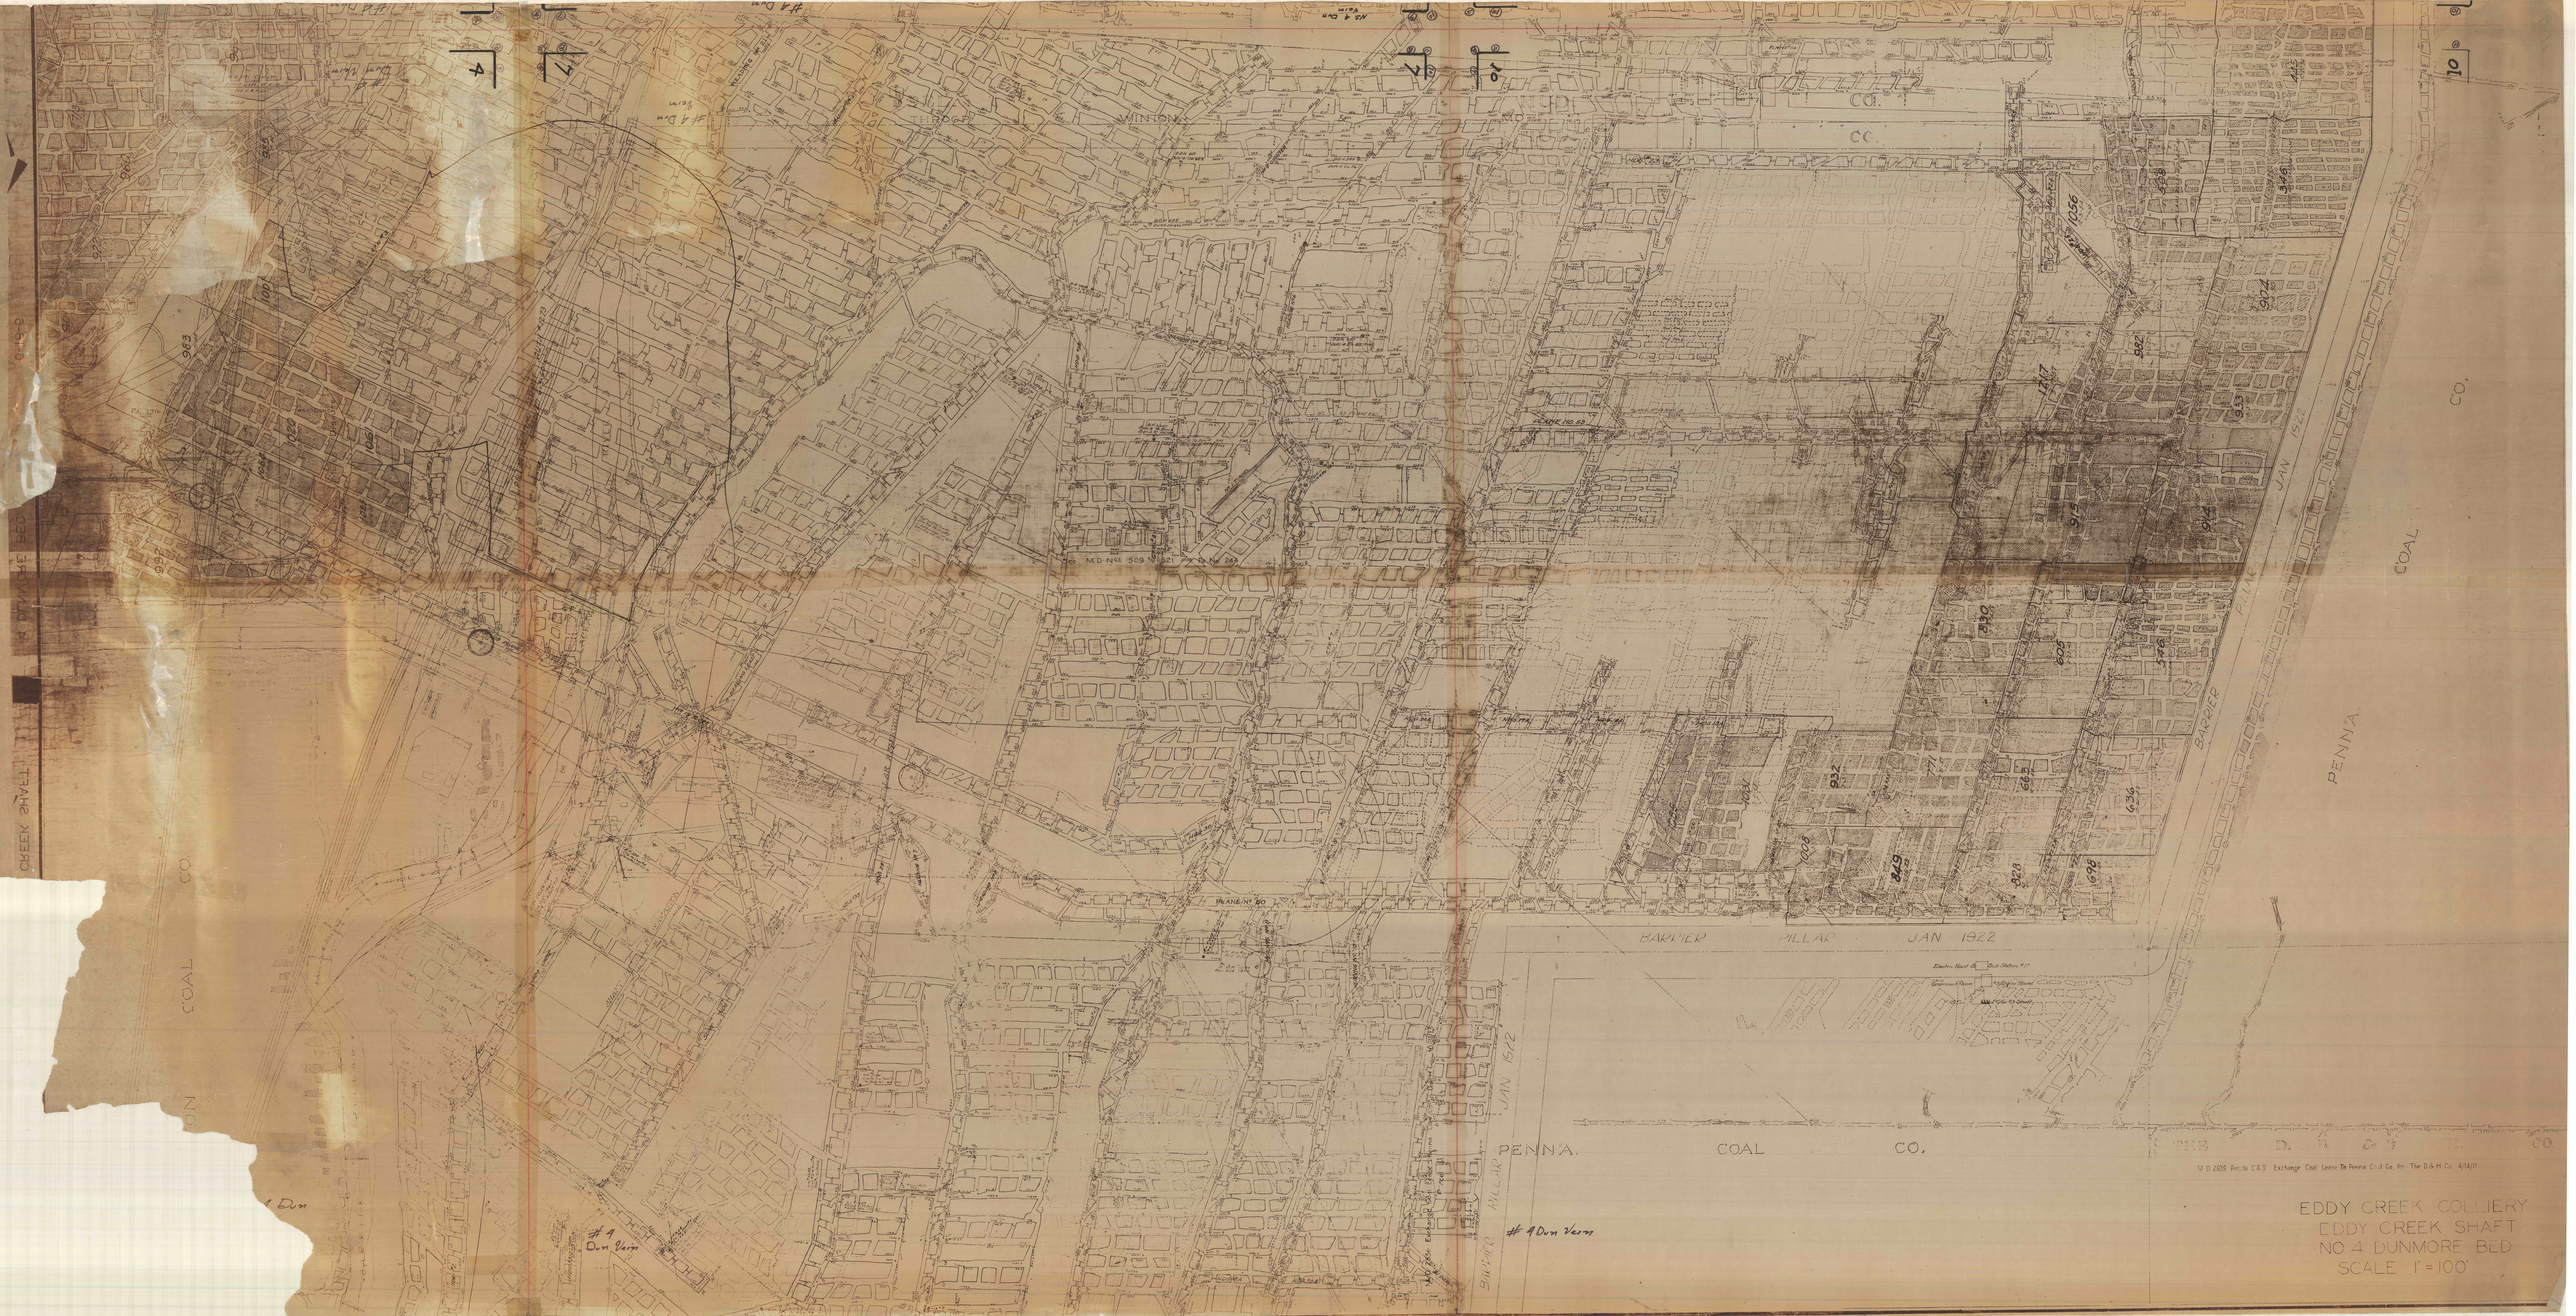

EDDY CREEK COLLIERY
EDDY CREEK SHAFT
NO 4 DUNMORE BED
SCALE 1"=100'
BARRIER
PILLAR
JAN 1922
PENNA. COAL CO.
THE D. & H. CO.
WINTON
MD No 509
PLANE No 80
#4 Dun Vein
#9 Dun Vein
M.D. 2305 Recds. D & H Exchange Coal Lease To Penna Coal Co. fm. The D & H Co. 4/14/11