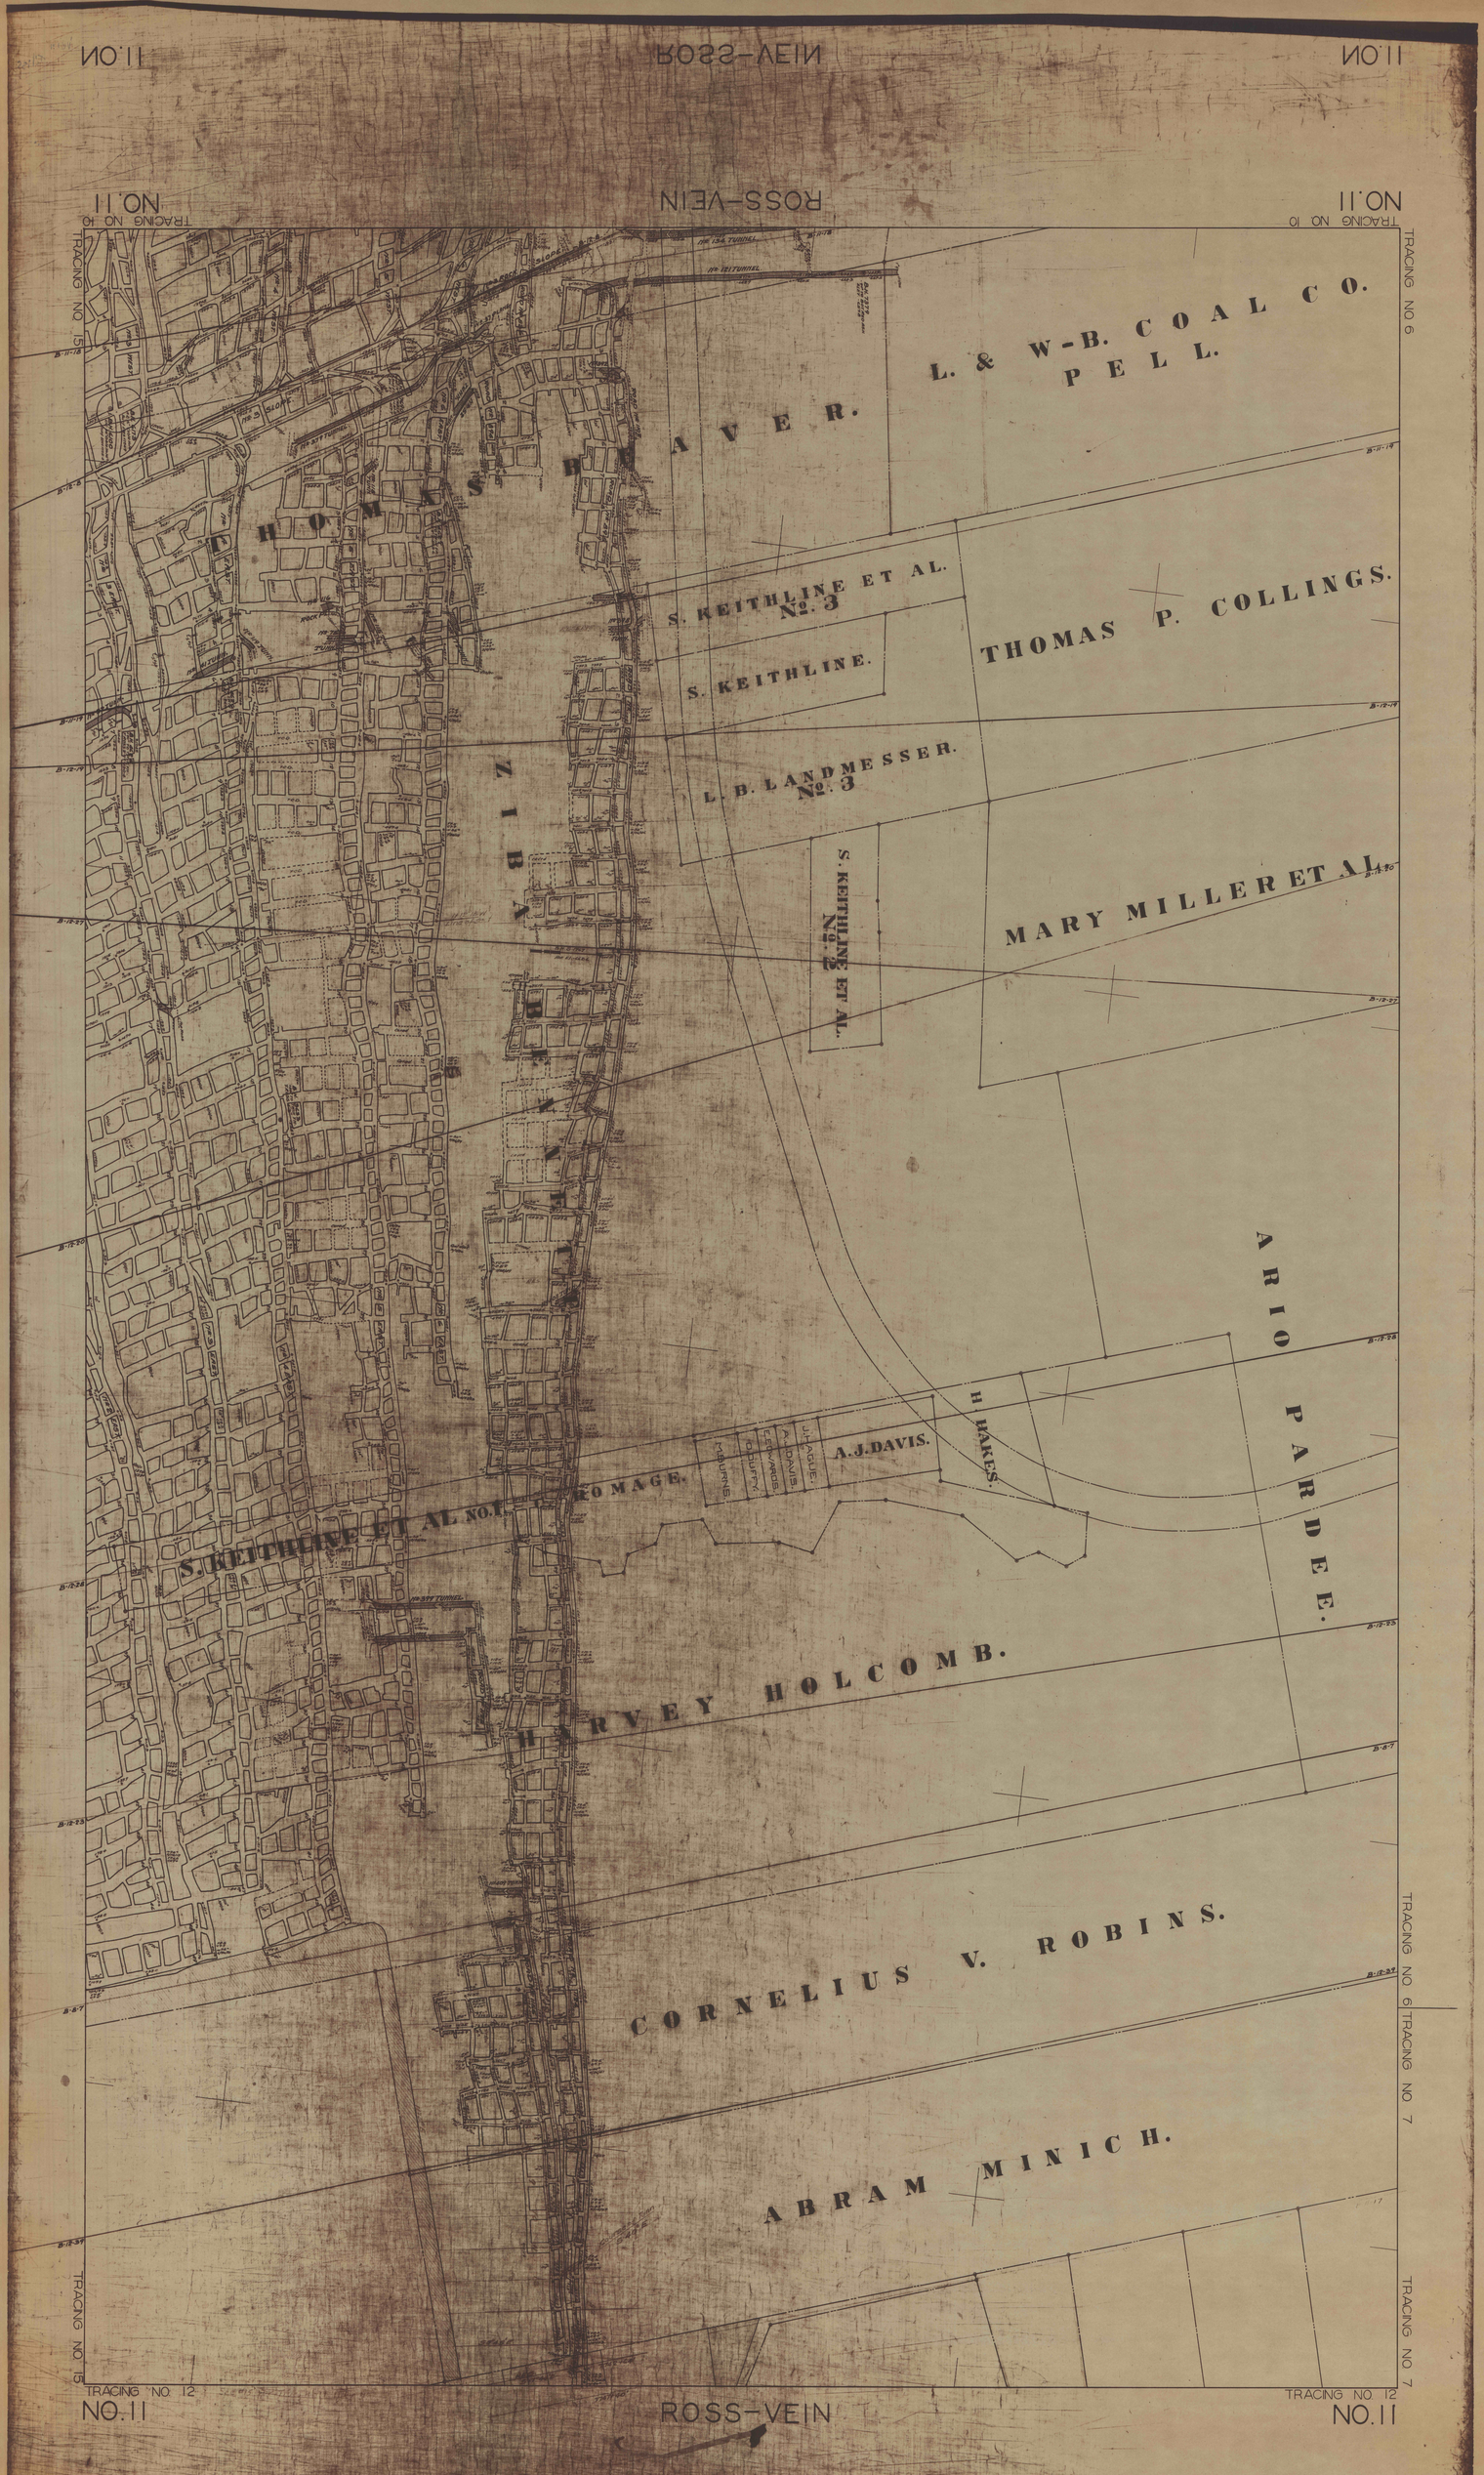

NO.11
ROSS-VEIN
TRACING NO 10
TRACING NO 15
TRACING NO 6
TRACING NO 7
TRACING NO 12
L. & W-B. COAL CO.
PELL.
THOMAS BEAVER.
S. KEITHLINE ET AL.
No. 3
S. KEITHLINE.
THOMAS P. COLLINGS.
L. B. LANDMESSER.
No. 3
S. KEITHLINE ET AL.
No. 2
MARY MILLER ET AL.
ZIBA BENNETT
ARIO PARDEE.
H. HAKES.
A. J. DAVIS.
S. KEITHLINE ET AL NO. 1
HARVEY HOLCOMB.
CORNELIUS V. ROBINS.
ABRAM MINICH.