



FLOOR PLAN
Scale: 1" = 4ft.

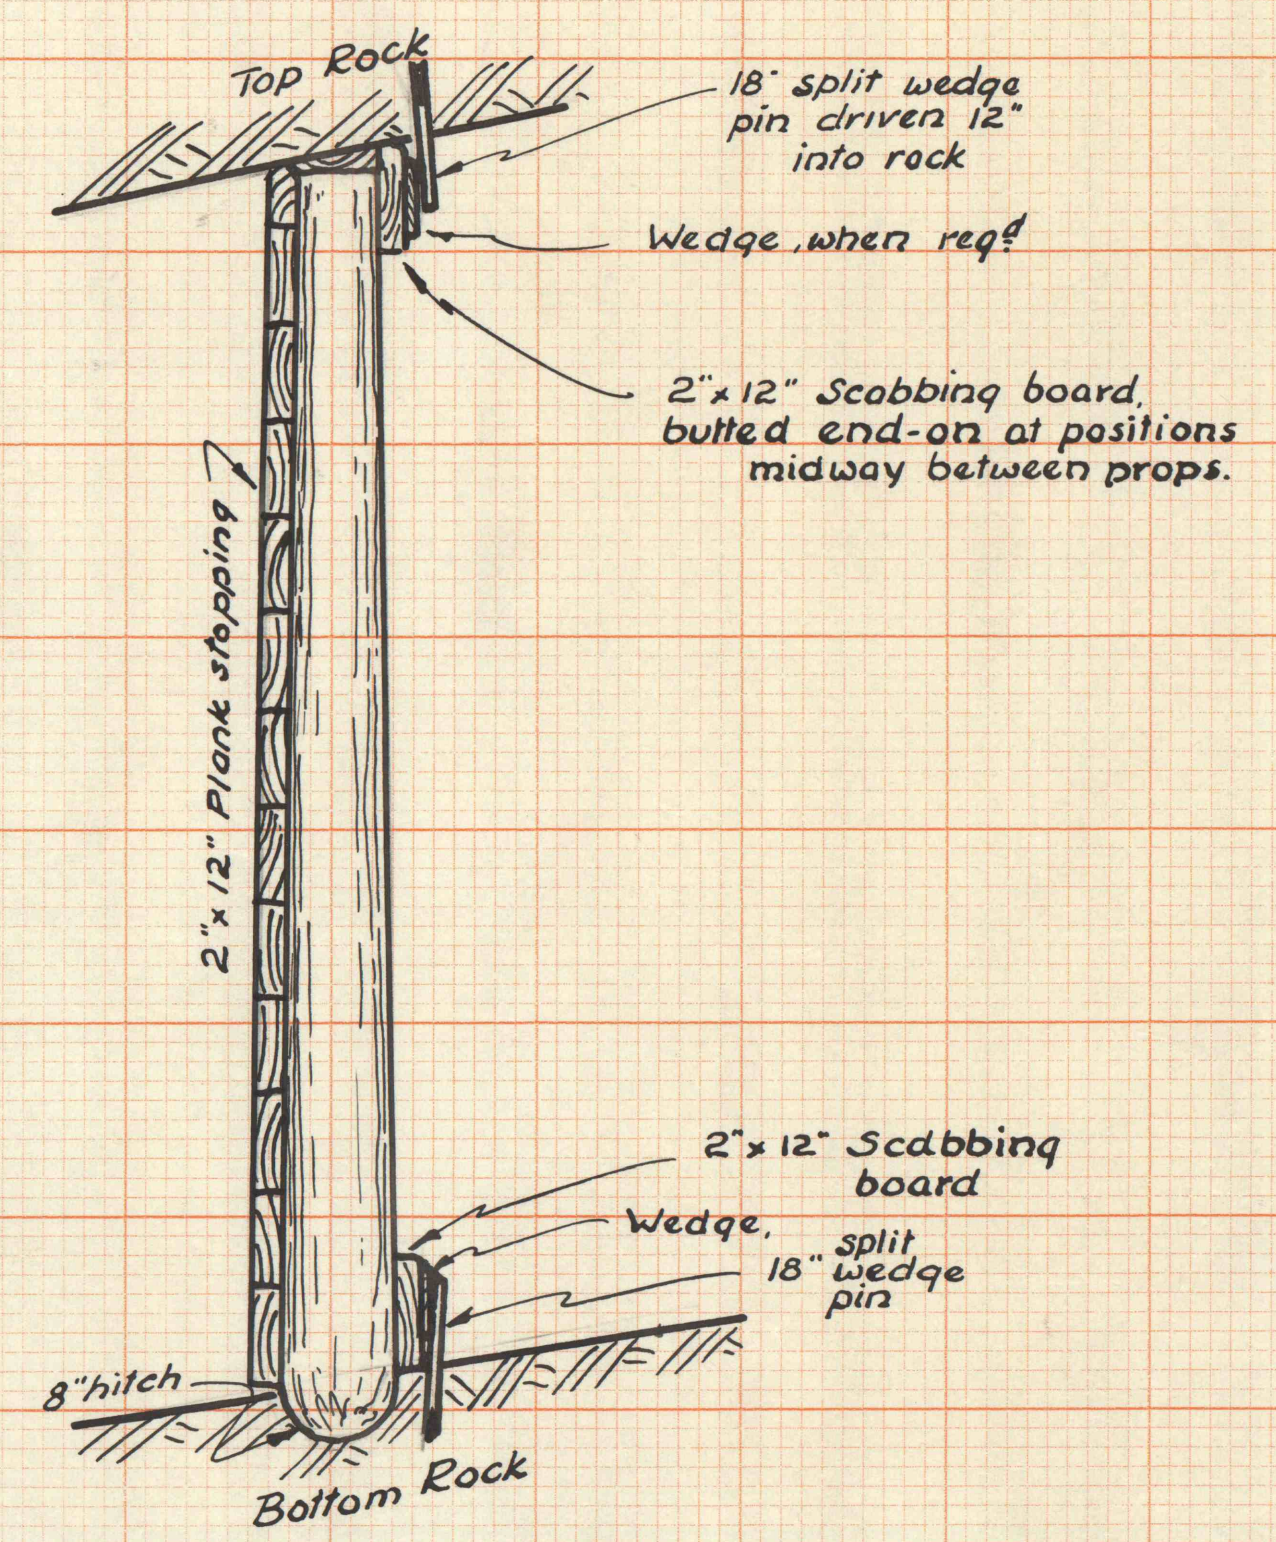

SECTION B-B
Scale: 1" = 2ft.

Note: Reinforcing bars will be interlaced with and securely fastened to 1/2" steel rope
Split wedge pins to be placed as near opposite center of props as possible
ESTIMATED CONC. REQ'D = 408 yds.
(AMOUNT CONC. USED: 415 cu. yds)

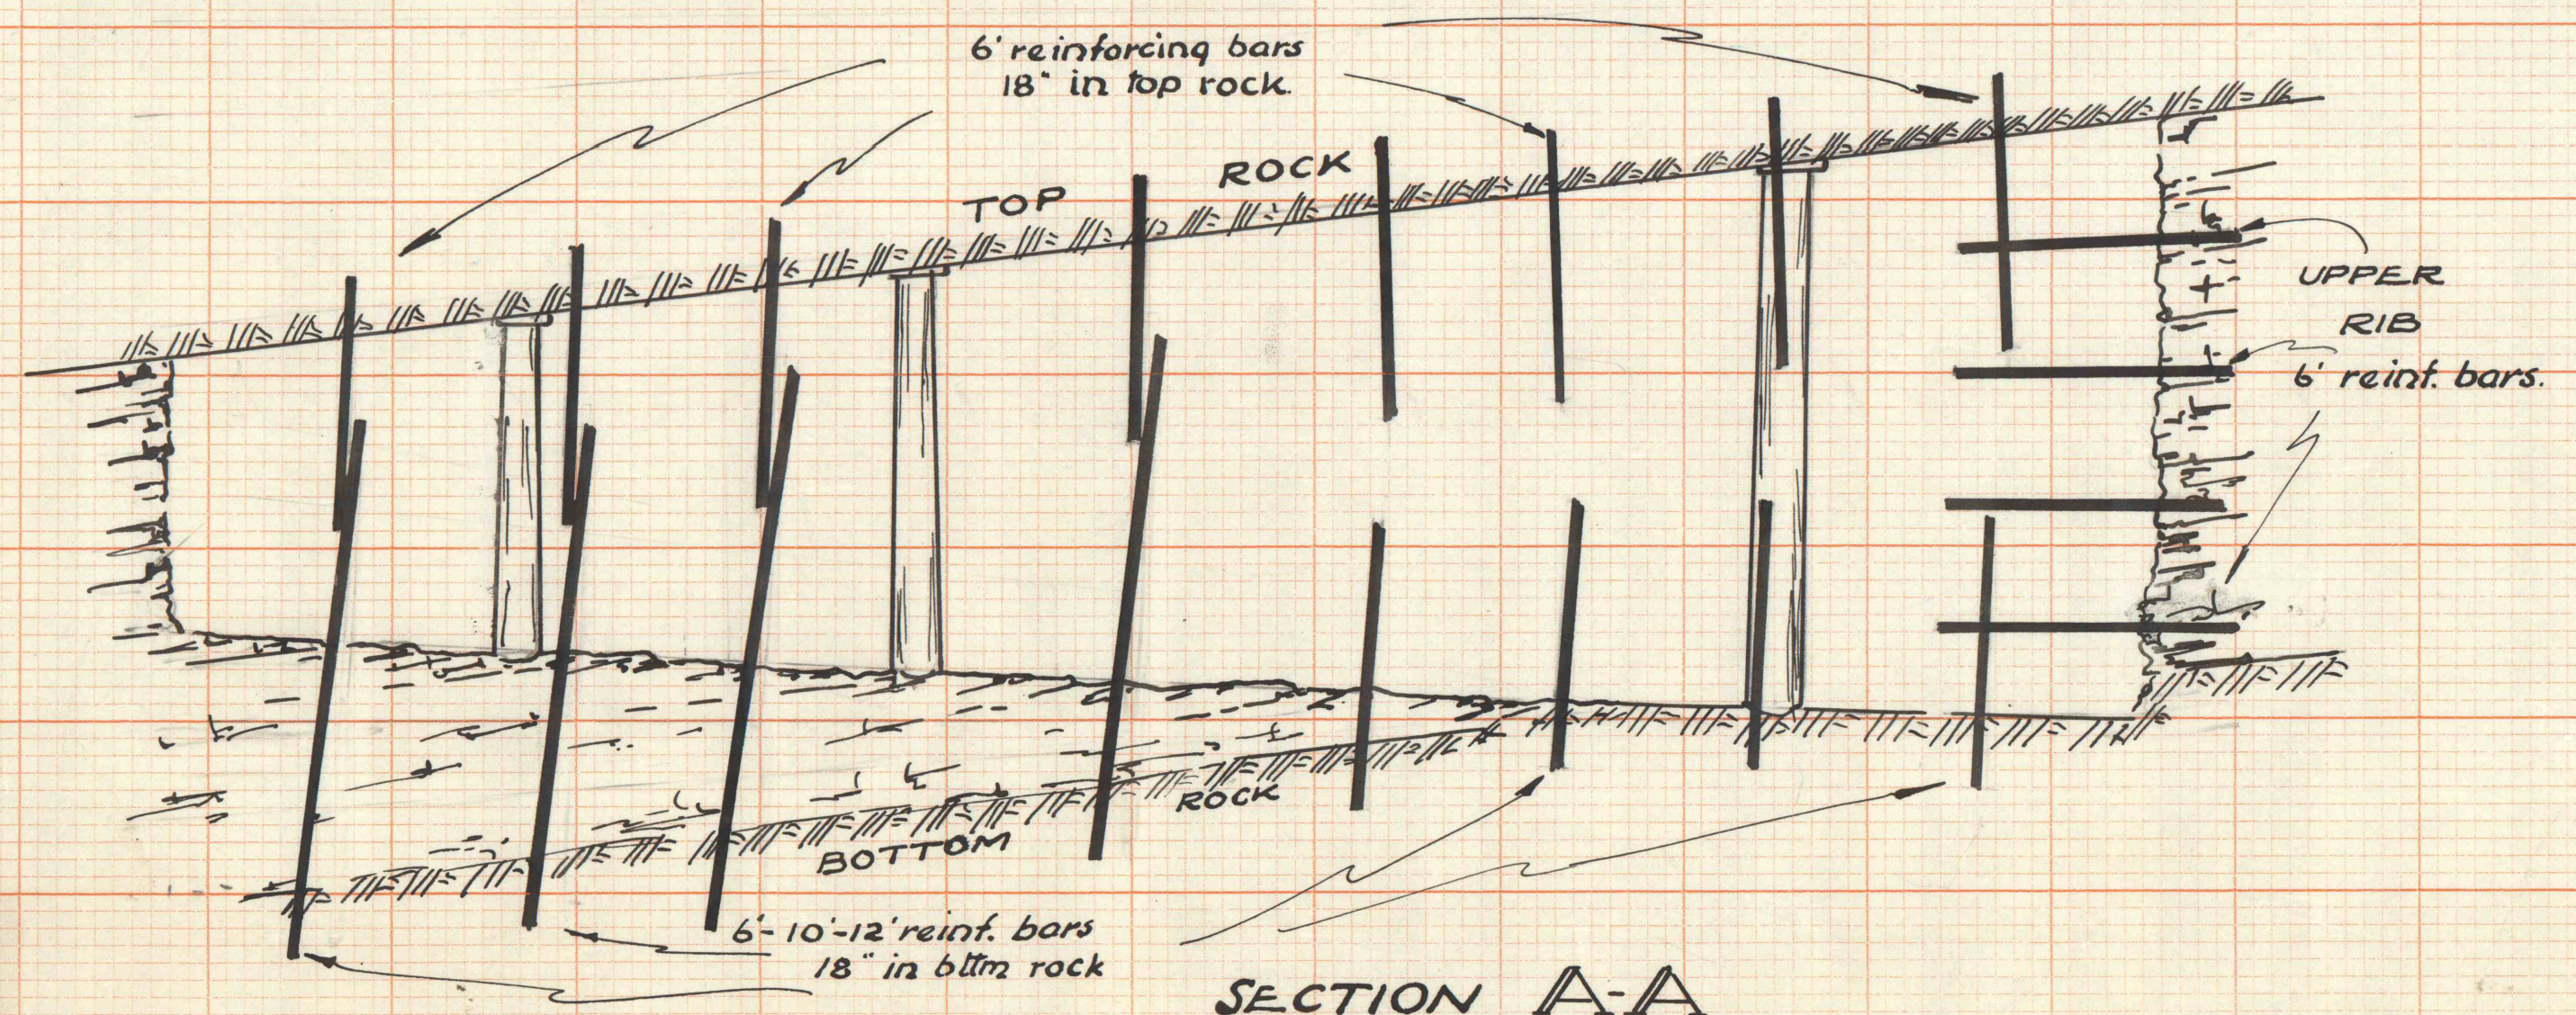

SECTION A-A
Scale: 1" = 4ft.

PENNSYLVANIA DEPT OF MINES
AND MINERAL INDS.
**DETAILS OF REINFORCED
CONCRETE DAM.**
No. 3 CROSSCUT LEFT, RIVER SLOPE
PITTSBURGH V. PORT GRIFFITH, PA.
PENNSYLVANIA COAL CO.
8-13-59
Dr. V.U.
Scale: as noted.