


Note :- Reinforcing bars will be interlaced with and securely fastened to 1/2" steel rope

Split wedge pins to be placed as near opposite center of props as possible.

**ESTMATED CONCRETE REQ'D - 100 cu.yds**

(AMOUNT CONC. USED 105 cu.yds.)

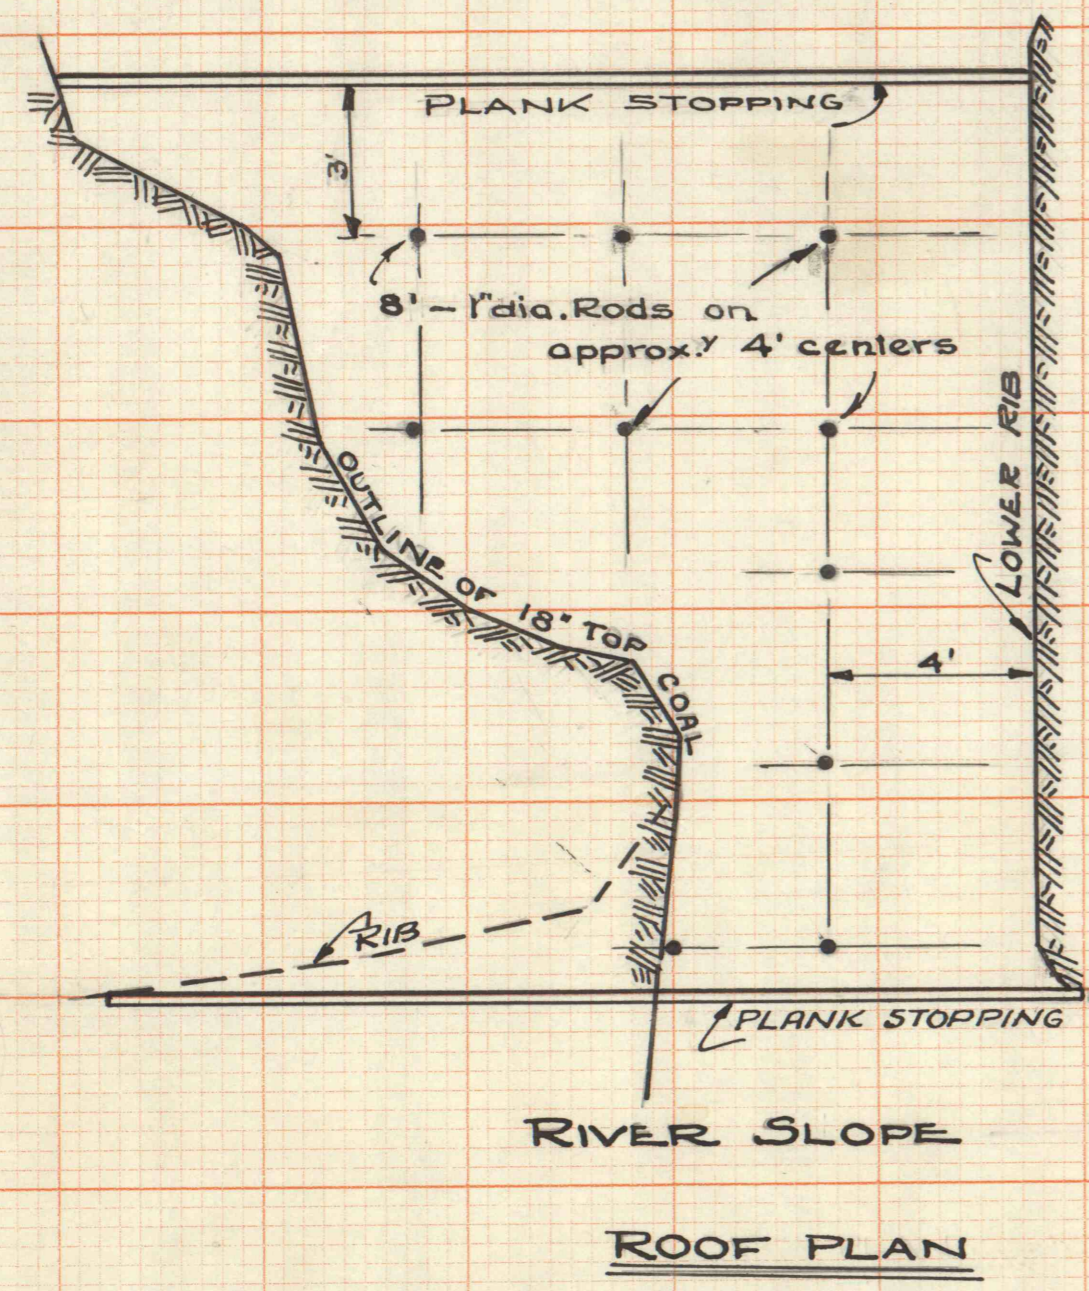

PENNSYLVANIA DEPT. OF MINES AND MINERAL INDS.

DETAILS OF REINFORCED CONCRETE DAM.

No 2 CROSSCUT, LEFT, RIVER SLOPE, PITTSTON VN. PORT GRIFFITH PA

PENNSYLVANIA COAL CO.

6-23-59

DR. V.U.

Scale 1" = 4 ft