

FORTY-FORT COAL CO.
SURFACE BY COAL LEASE
42.40 ACRES

FORTY-FORT COAL CO.
SURFACE BY COAL LEASE
31.20 ACRES


FORTY-FORT COAL CO. SURFACE BY COAL LEASE - 413 ACRES

FORTY-FORT COAL CO.
SURFACE - BY COAL LEASE
31.50 ACRES

200 ACRES - RESERVED

PLAYGROUND
244 AC.

113 ACRES - RIGHT OF WAY

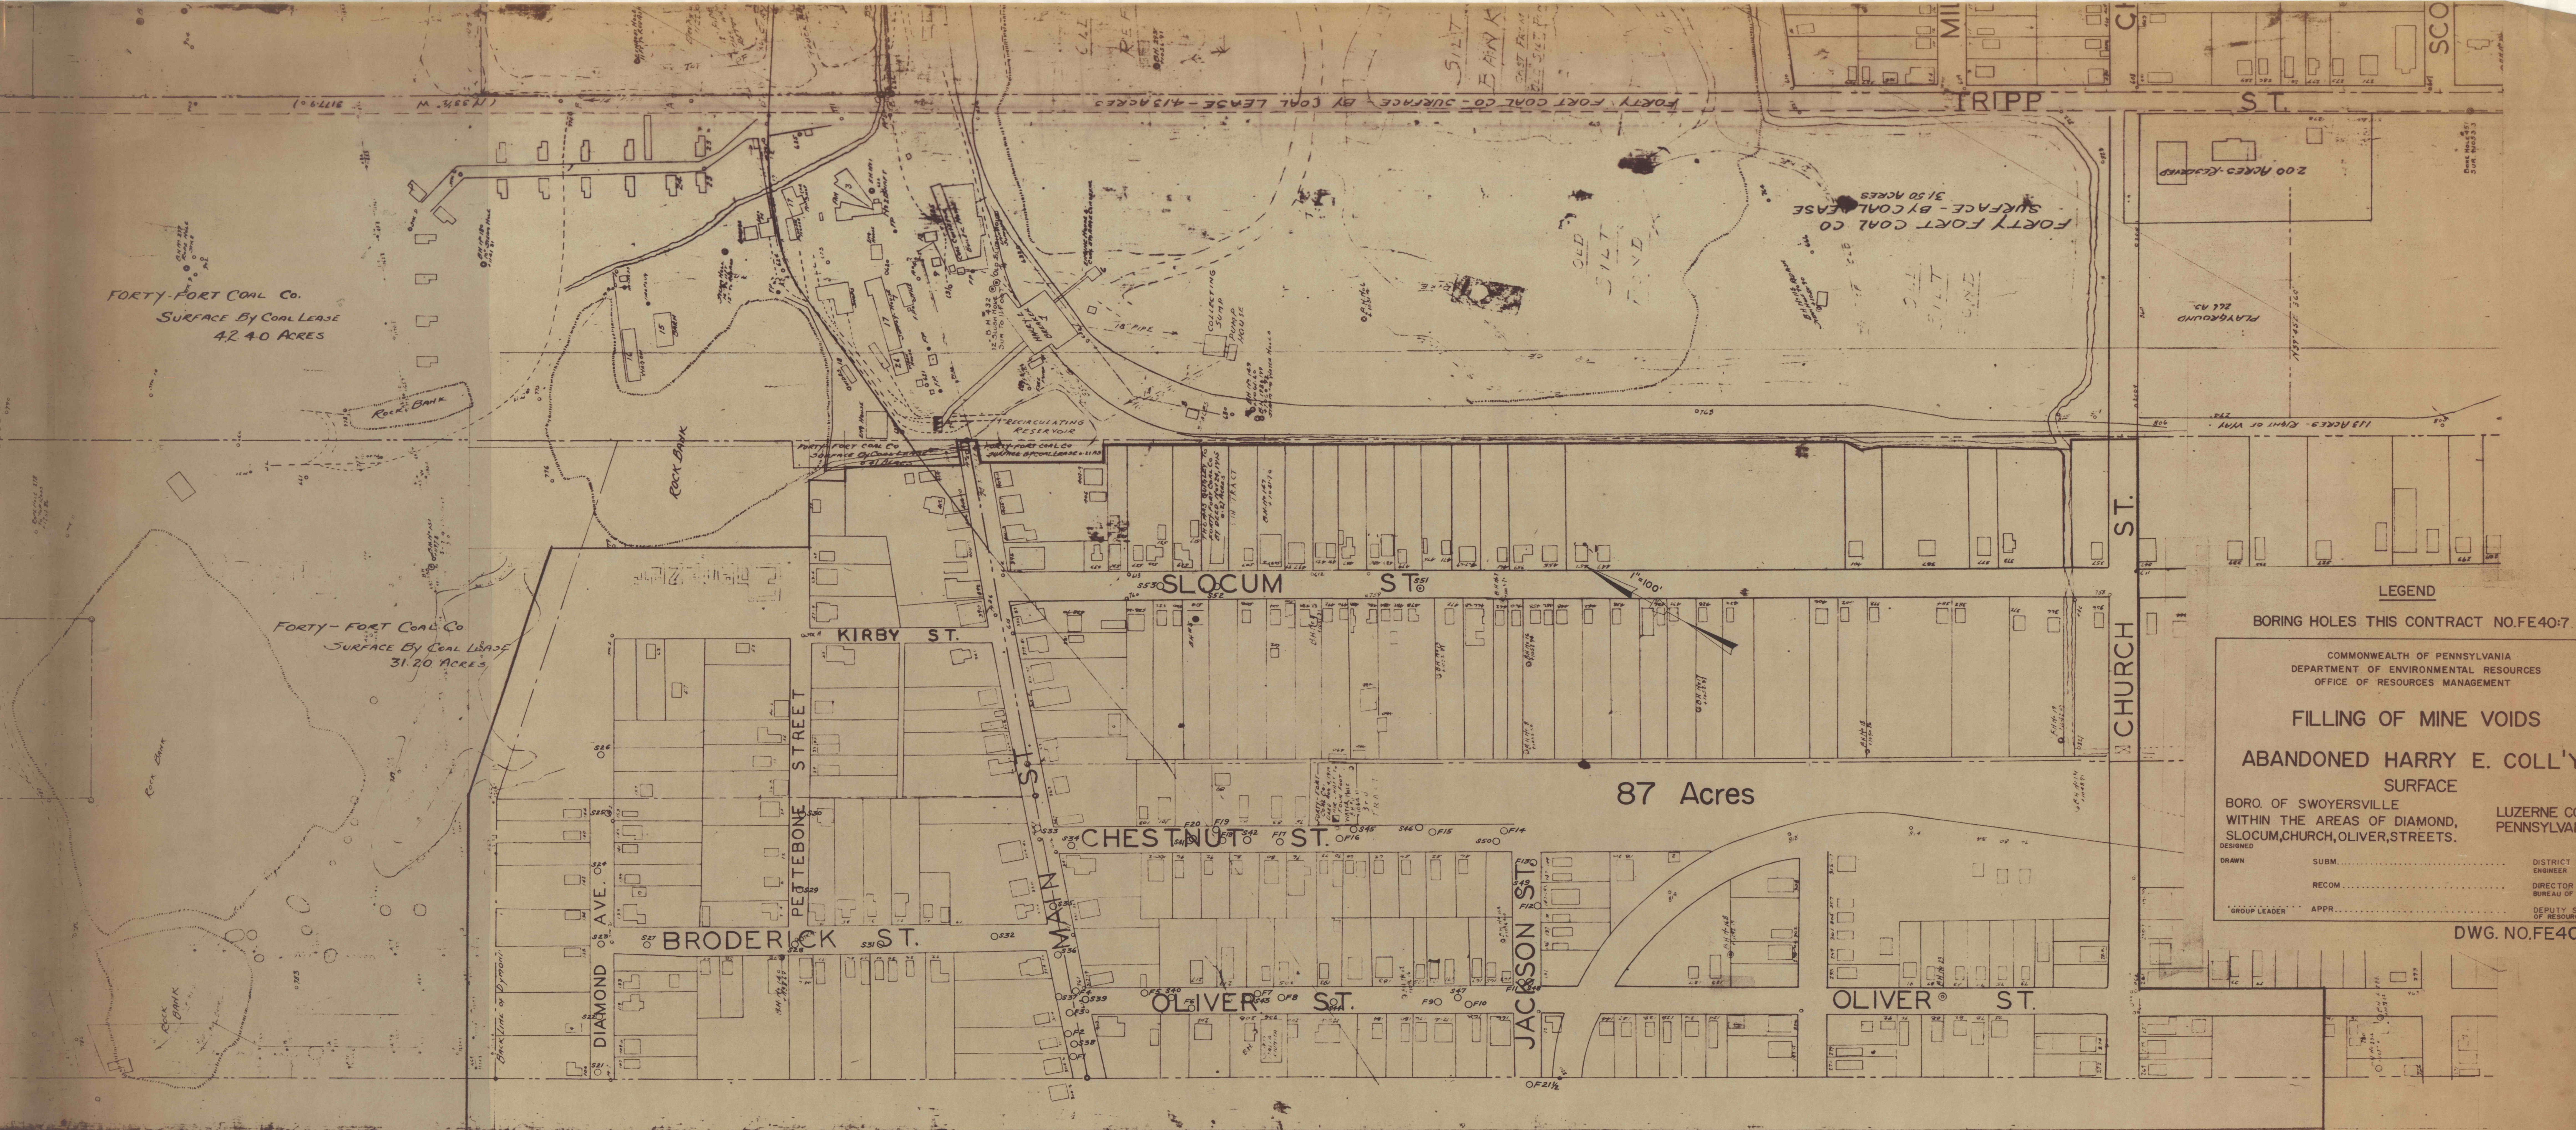

LEGEND

BORING HOLES THIS CONTRACT NO.FE40:7

COMMONWEALTH OF PENNSYLVANIA
DEPARTMENT OF ENVIRONMENTAL RESOURCES
OFFICE OF RESOURCES MANAGEMENT

FILLING OF MINE VOIDS
ABANDONED HARRY E. COLL'Y
SURFACE

BORO. OF SWOYERSVILLE
WITHIN THE AREAS OF DIAMOND,
SLOCUM, CHURCH, OLIVER, STREETS.

LUZERNE COUNTY
PENNSYLVANIA

DESIGNED	SUBM.	DISTRICT ENGINEER
DRAWN	RECOM.	DIRECTOR BUREAU OF CONST.
"GROUP LEADER"	APPR.	DEPUTY SECRETAR OF RESOURCES MANA

87 Acres

DWG. NO.FE40:7-1