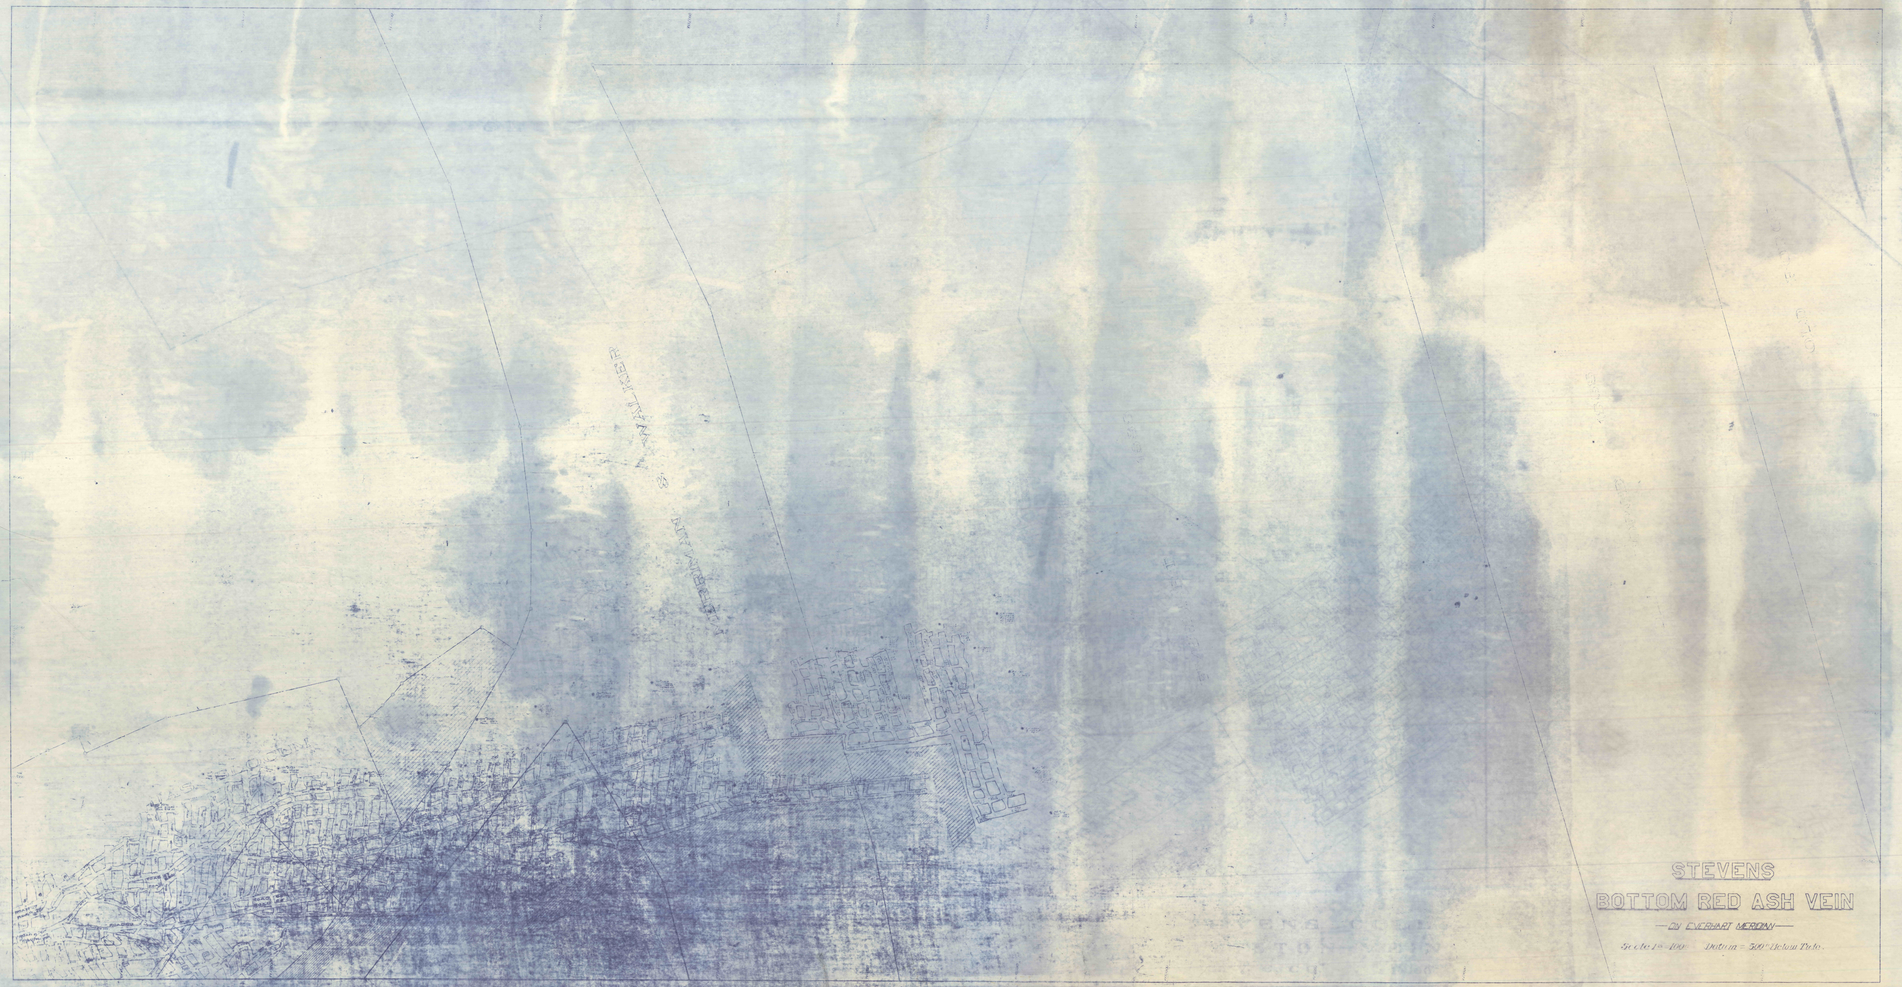
STEVENS
BOTTOM RED ASH VEIN
BY EVERHART MERONI
Scale 1" = 100'
Datum = 500' Below Pole