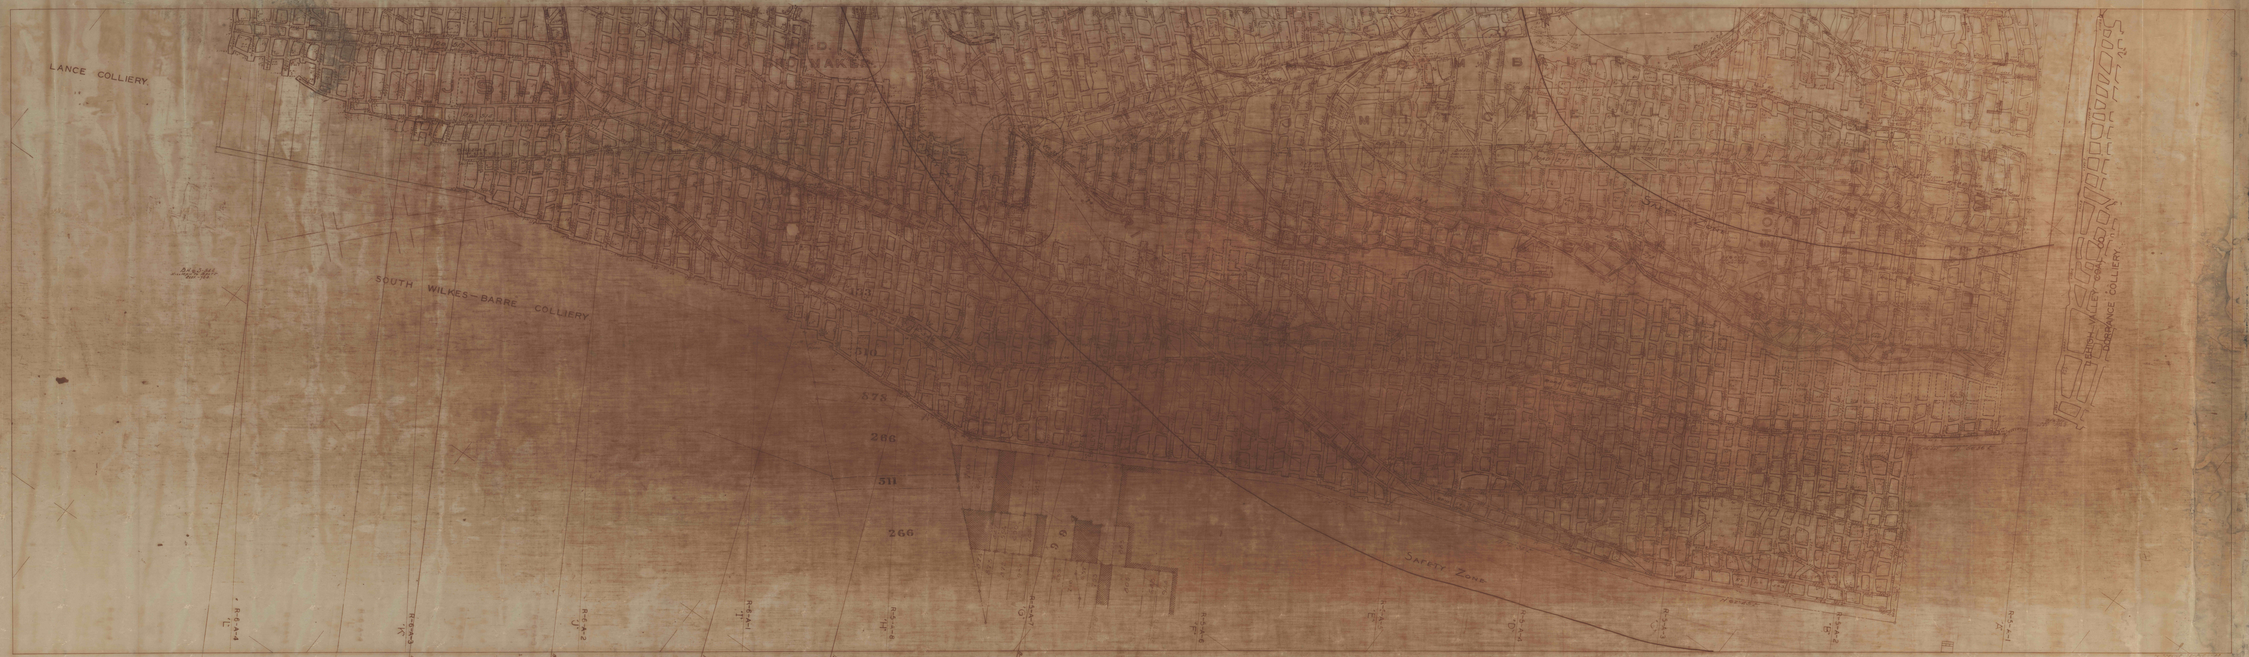
LANCE COLLIERY
SOUTH WILKES-BARRE COLLIERY
SAFETY ZONE
DORRANCE COLLIERY
HILLMAN – SOUTH.