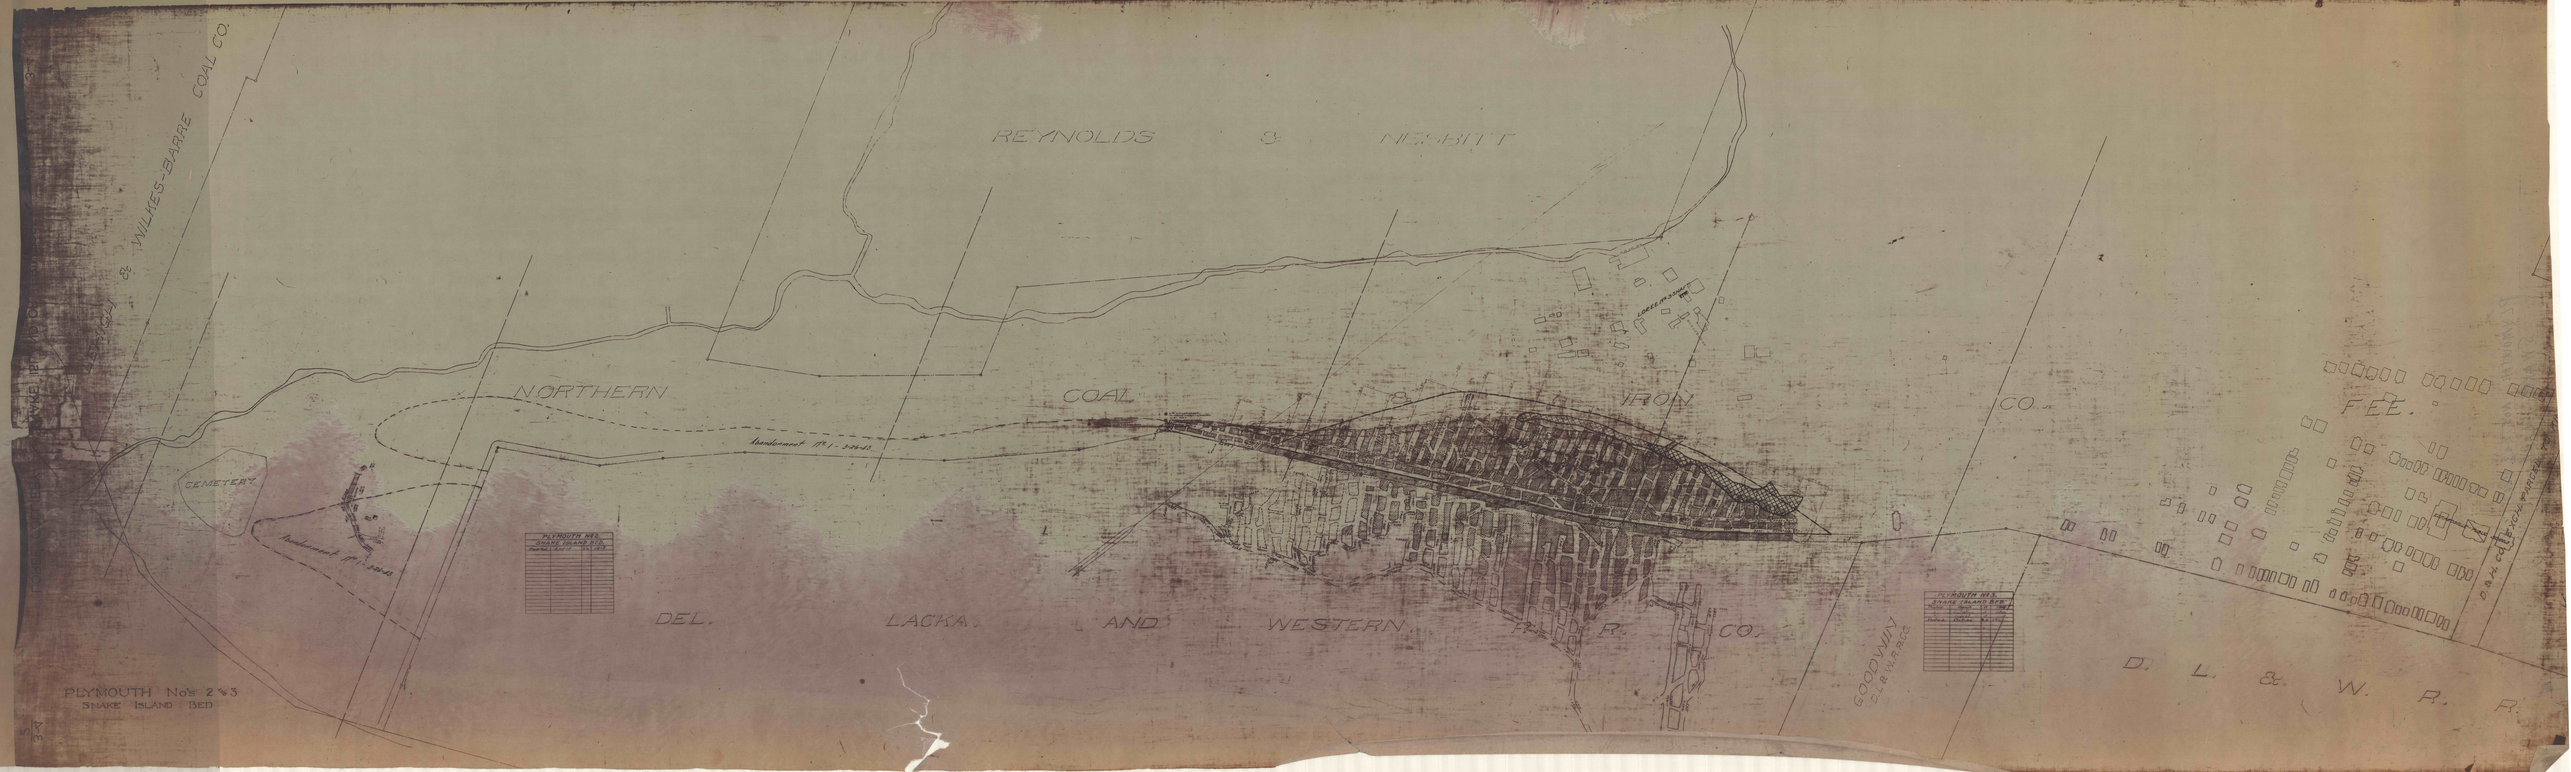
WILKES-BARRE COAL CO.
REYNOLDS & HERBITT
NORTHERN COAL & IRON CO.
Abandonment Pl. 1-3-4-5
CEMETERY
Abandonment Pl. 3-4-5
PLYMOUTH NOS. SNAKE ISLAND BED
DEL. LACKA. AND WESTERN R. R. CO.
GOODWIN
D. L. & W. R. R.
F.E.E.
PLYMOUTH Nos 2 & 3
SNAKE ISLAND BED