

LESSEE

CO. LESSEE

APPROVED MAR 16TH 1927


Authority No 43

Authority No 35

RESERVE

RESERVE

NO FURTHER MINING IN THIS AREA WITHOUT SPECIAL PERMIT

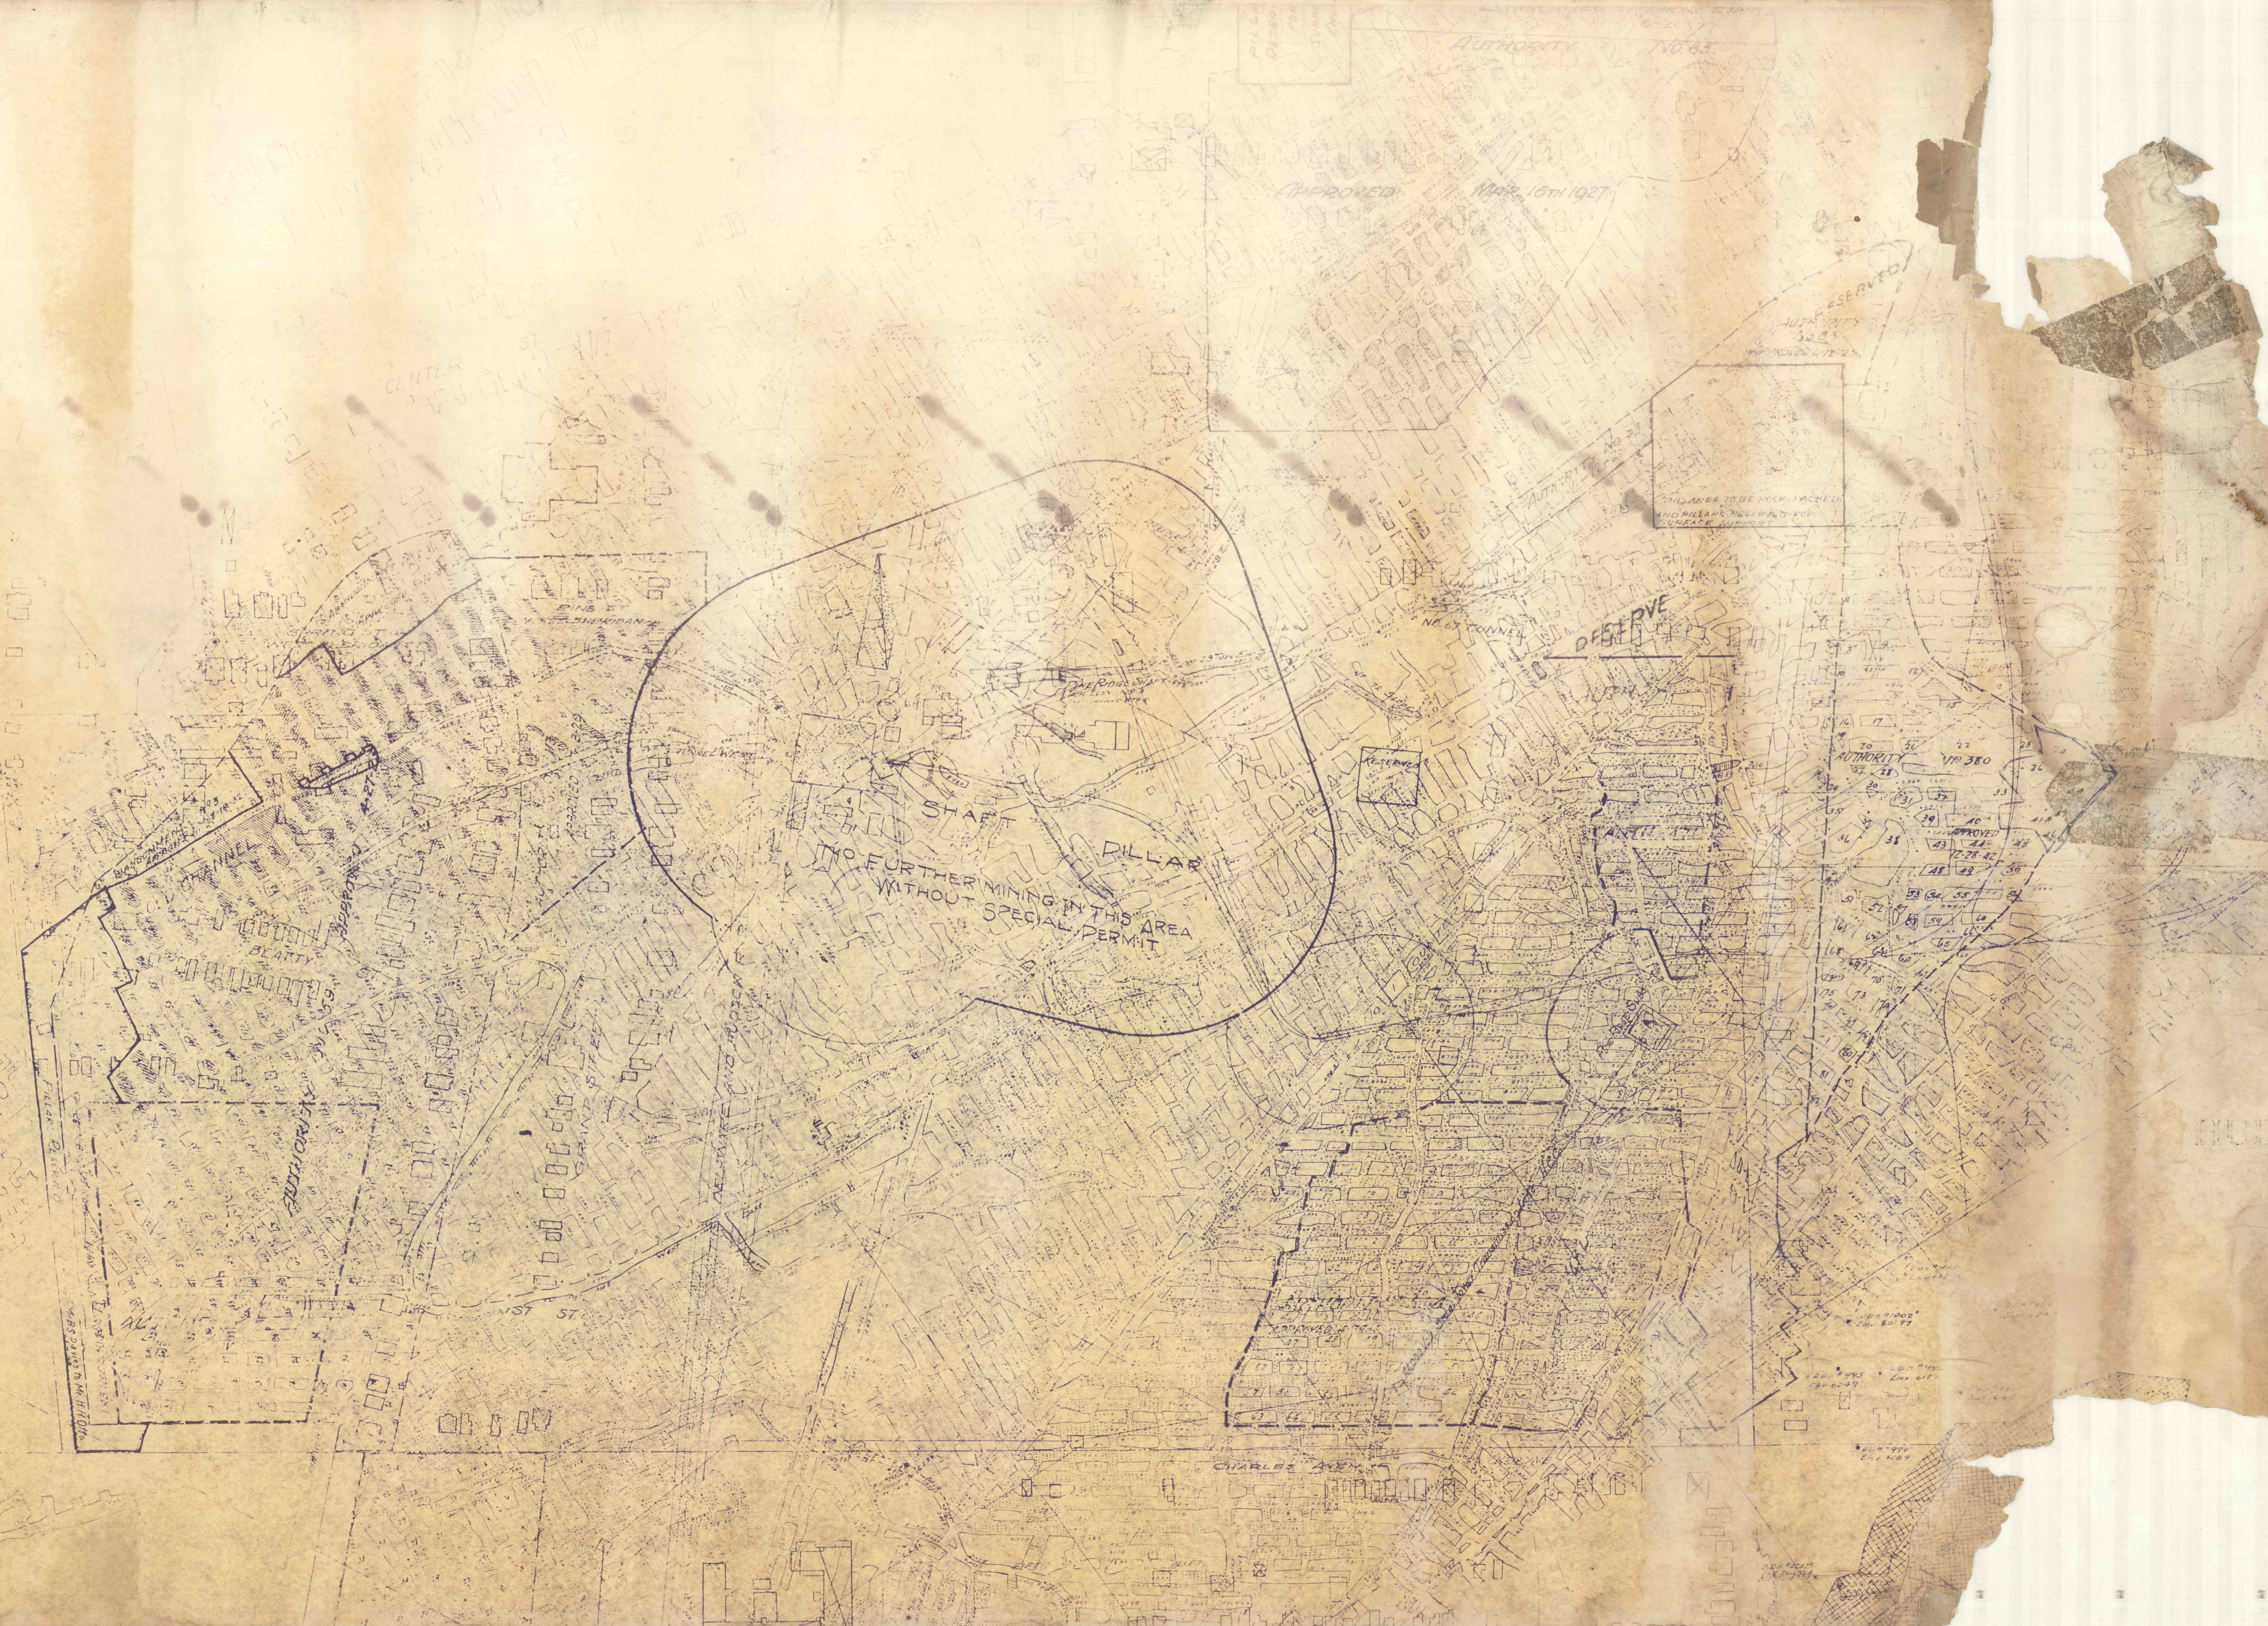

Authority No 31

APPROVED 12-28-21

Authority No 29

Authority No 28

MULL