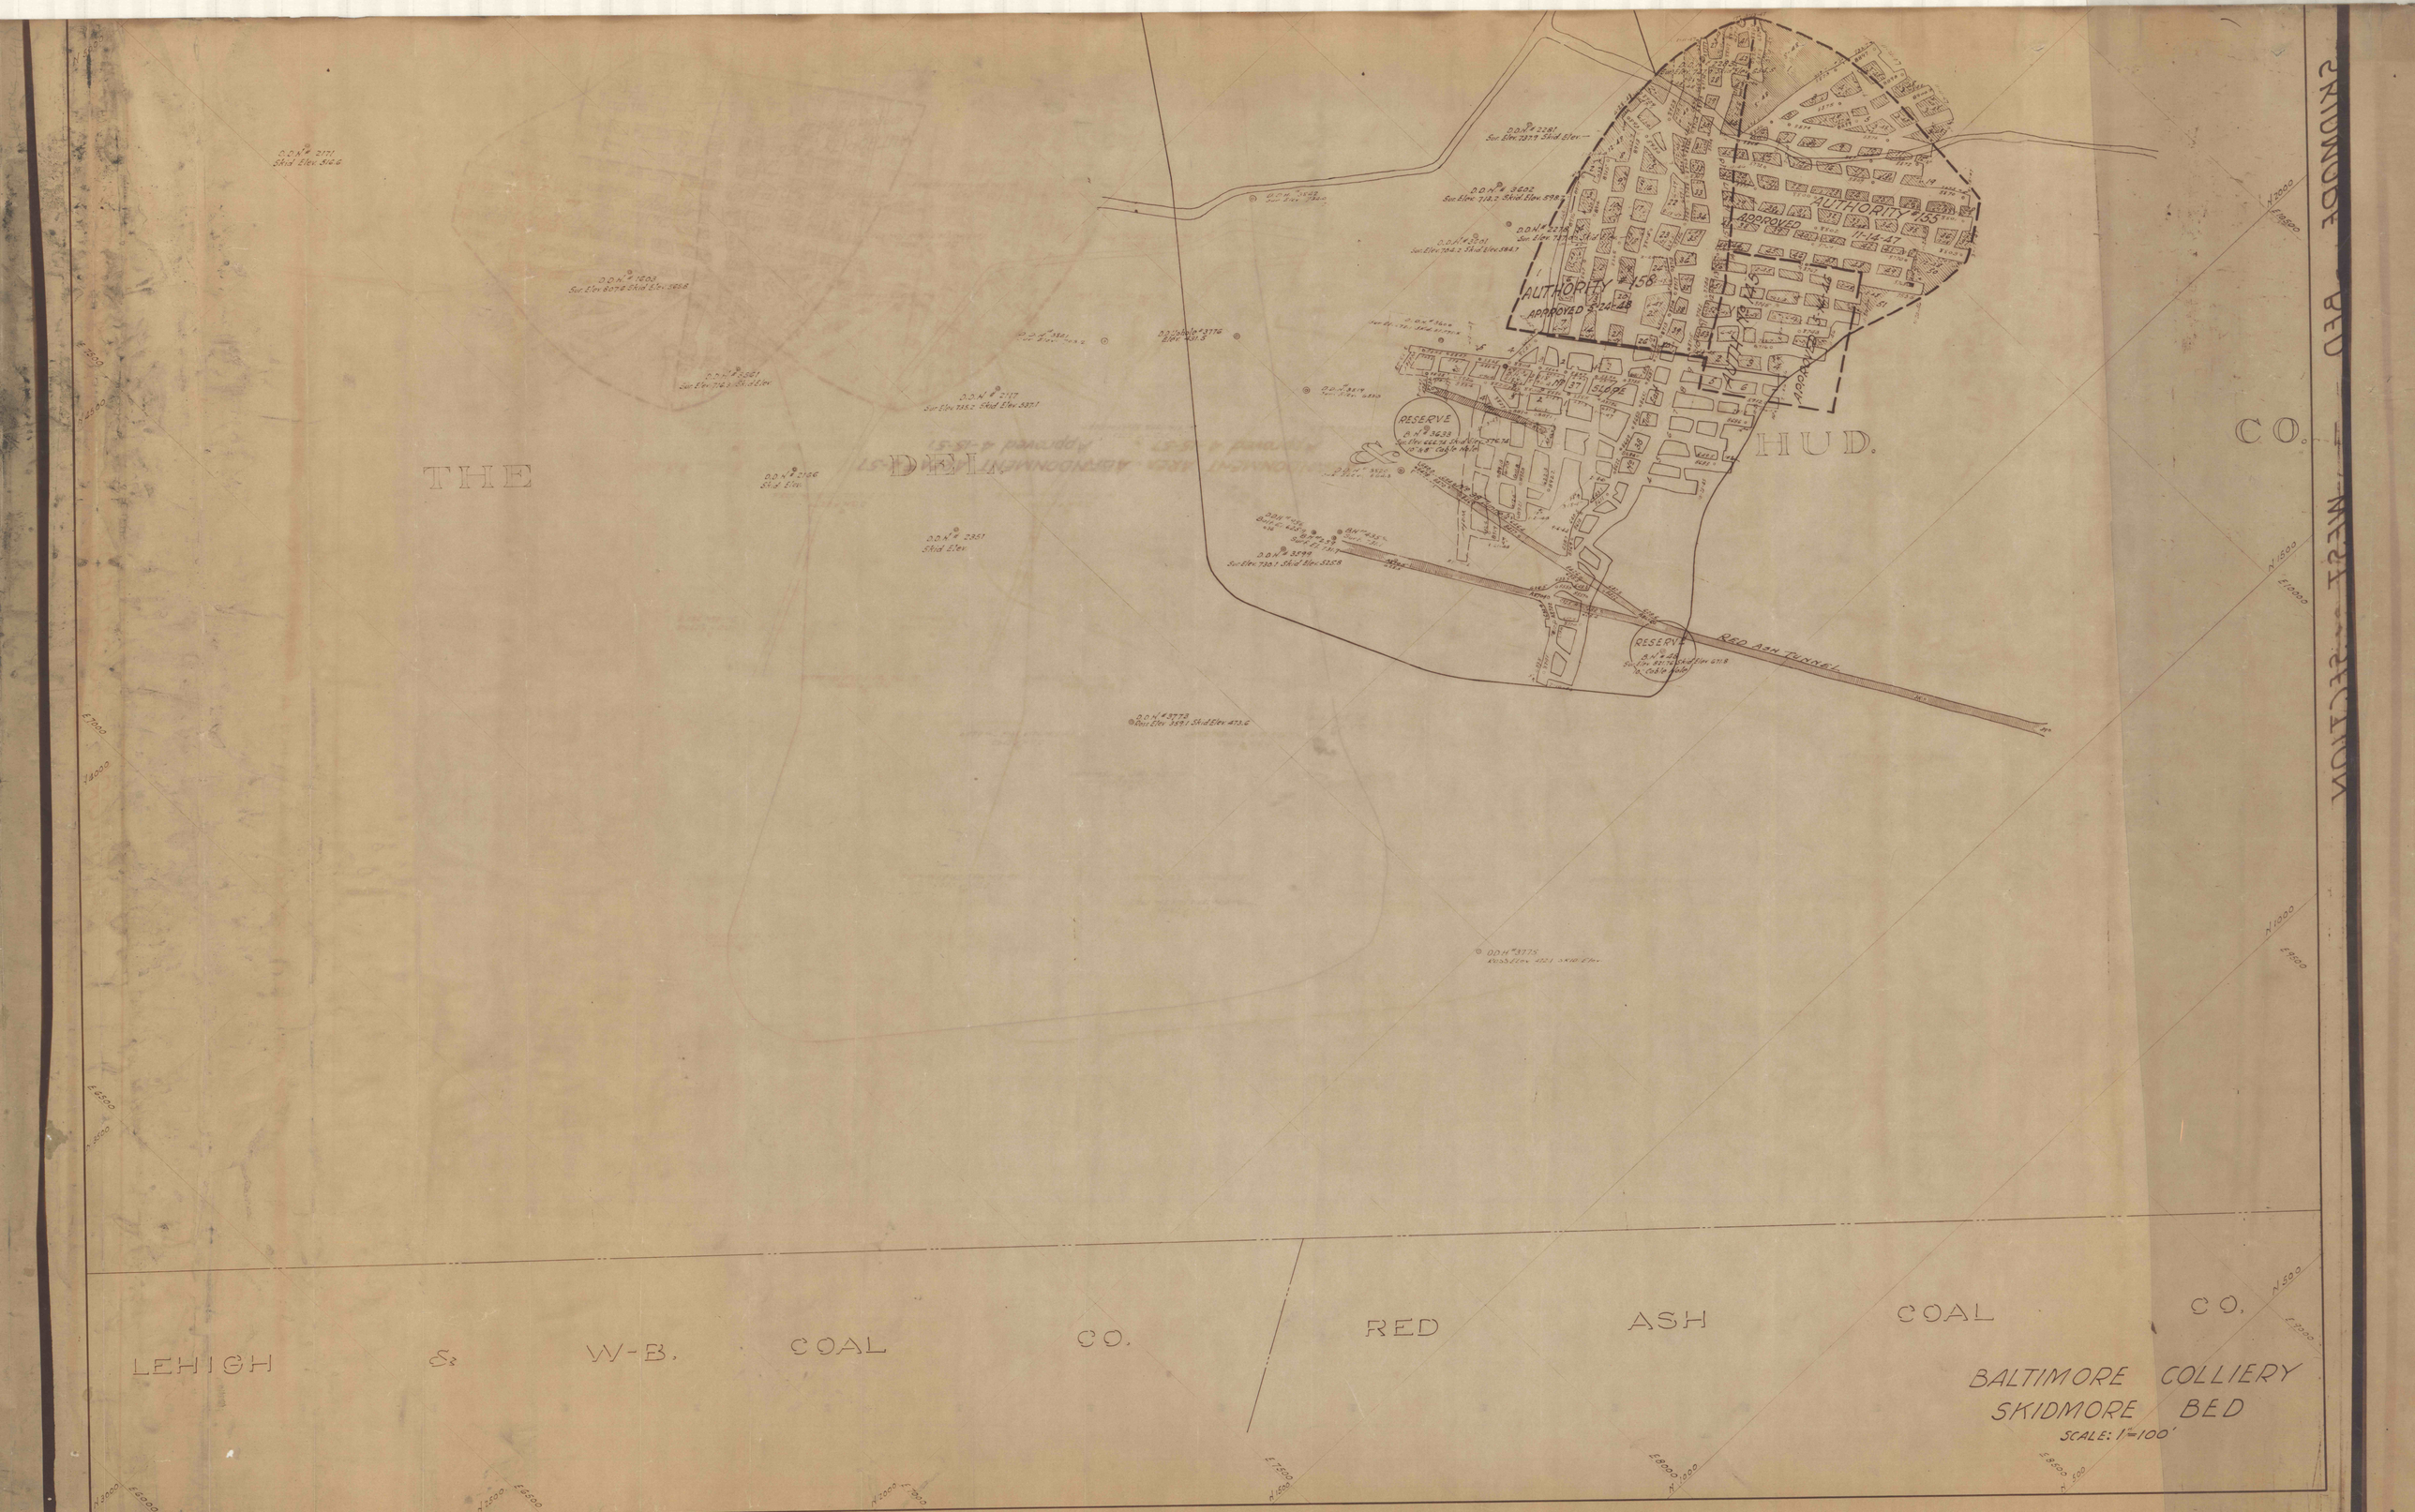
D.D.H.# 2171
Skid Elev. 966
D.D.H.# 1603
Sur Elev 807.6 Skid Elev. 769.8
D.D.H.# 2261
Sur Elev 782 Skid Elev.
D.D.H.# 2177
Sur Elev 795.2 Skid Elev 837.1
D.D.H.# 2126
Skid Elev.
D.D.H.# 2351
Skid Elev.
D.D.H.# 3776
Elev 823.3
D.D.H.# 3777
Sur Elev 769.1 Skid Elev 823.6
D.D.H.# 2281
Sur Elev 737.9 Skid Elev.
D.D.H.# 3602
Sur Elev 713.2 Skid Elev 878.3
D.D.H.# 3278
Sur Elev 774.4 Skid
D.D.H.# 2201
Sur Elev 704.2 Skid Elev 864.1
AUTHORITY #158
APPROVED 3-24-48
AUTHORITY #155
APPROVED 11-14-47
AUTHORITY #173
APPROVED
SLOPE
RESERVE
D.D.H.# 3633
Sur Elev 662.76 Skid Elev 827.4
18" Cable Hole
D.D.H.# 3599
Sur Elev 730.1 Skid Elev 825.8
RESERVE
D.D.H.# 3778
Sur Elev 821.7 Skid Elev 671.8
Cable Hole
RED ASH TUNNEL
THE
DELAWARE
HUDSON
CO.
LEHIGH & W-B. COAL CO.
RED ASH COAL CO.
BALTIMORE COLLIERY
SKIDMORE BED
SCALE: 1"=100'
N 3000
E 6000
N 2500
E 6500
N 2000
E 7000
N 1500
E 7500
N 1000
E 8000
N 500
E 8500
N 0
E 9000
N 1000
E 9500
N 1500
E 10000
N 2000
E 10500
N 2500
E 11000
N 3000
E 11500