


BALTIMORE
CITY
SCHOOL COLLEGE

BALTIMORE
CITY
GRID
BED

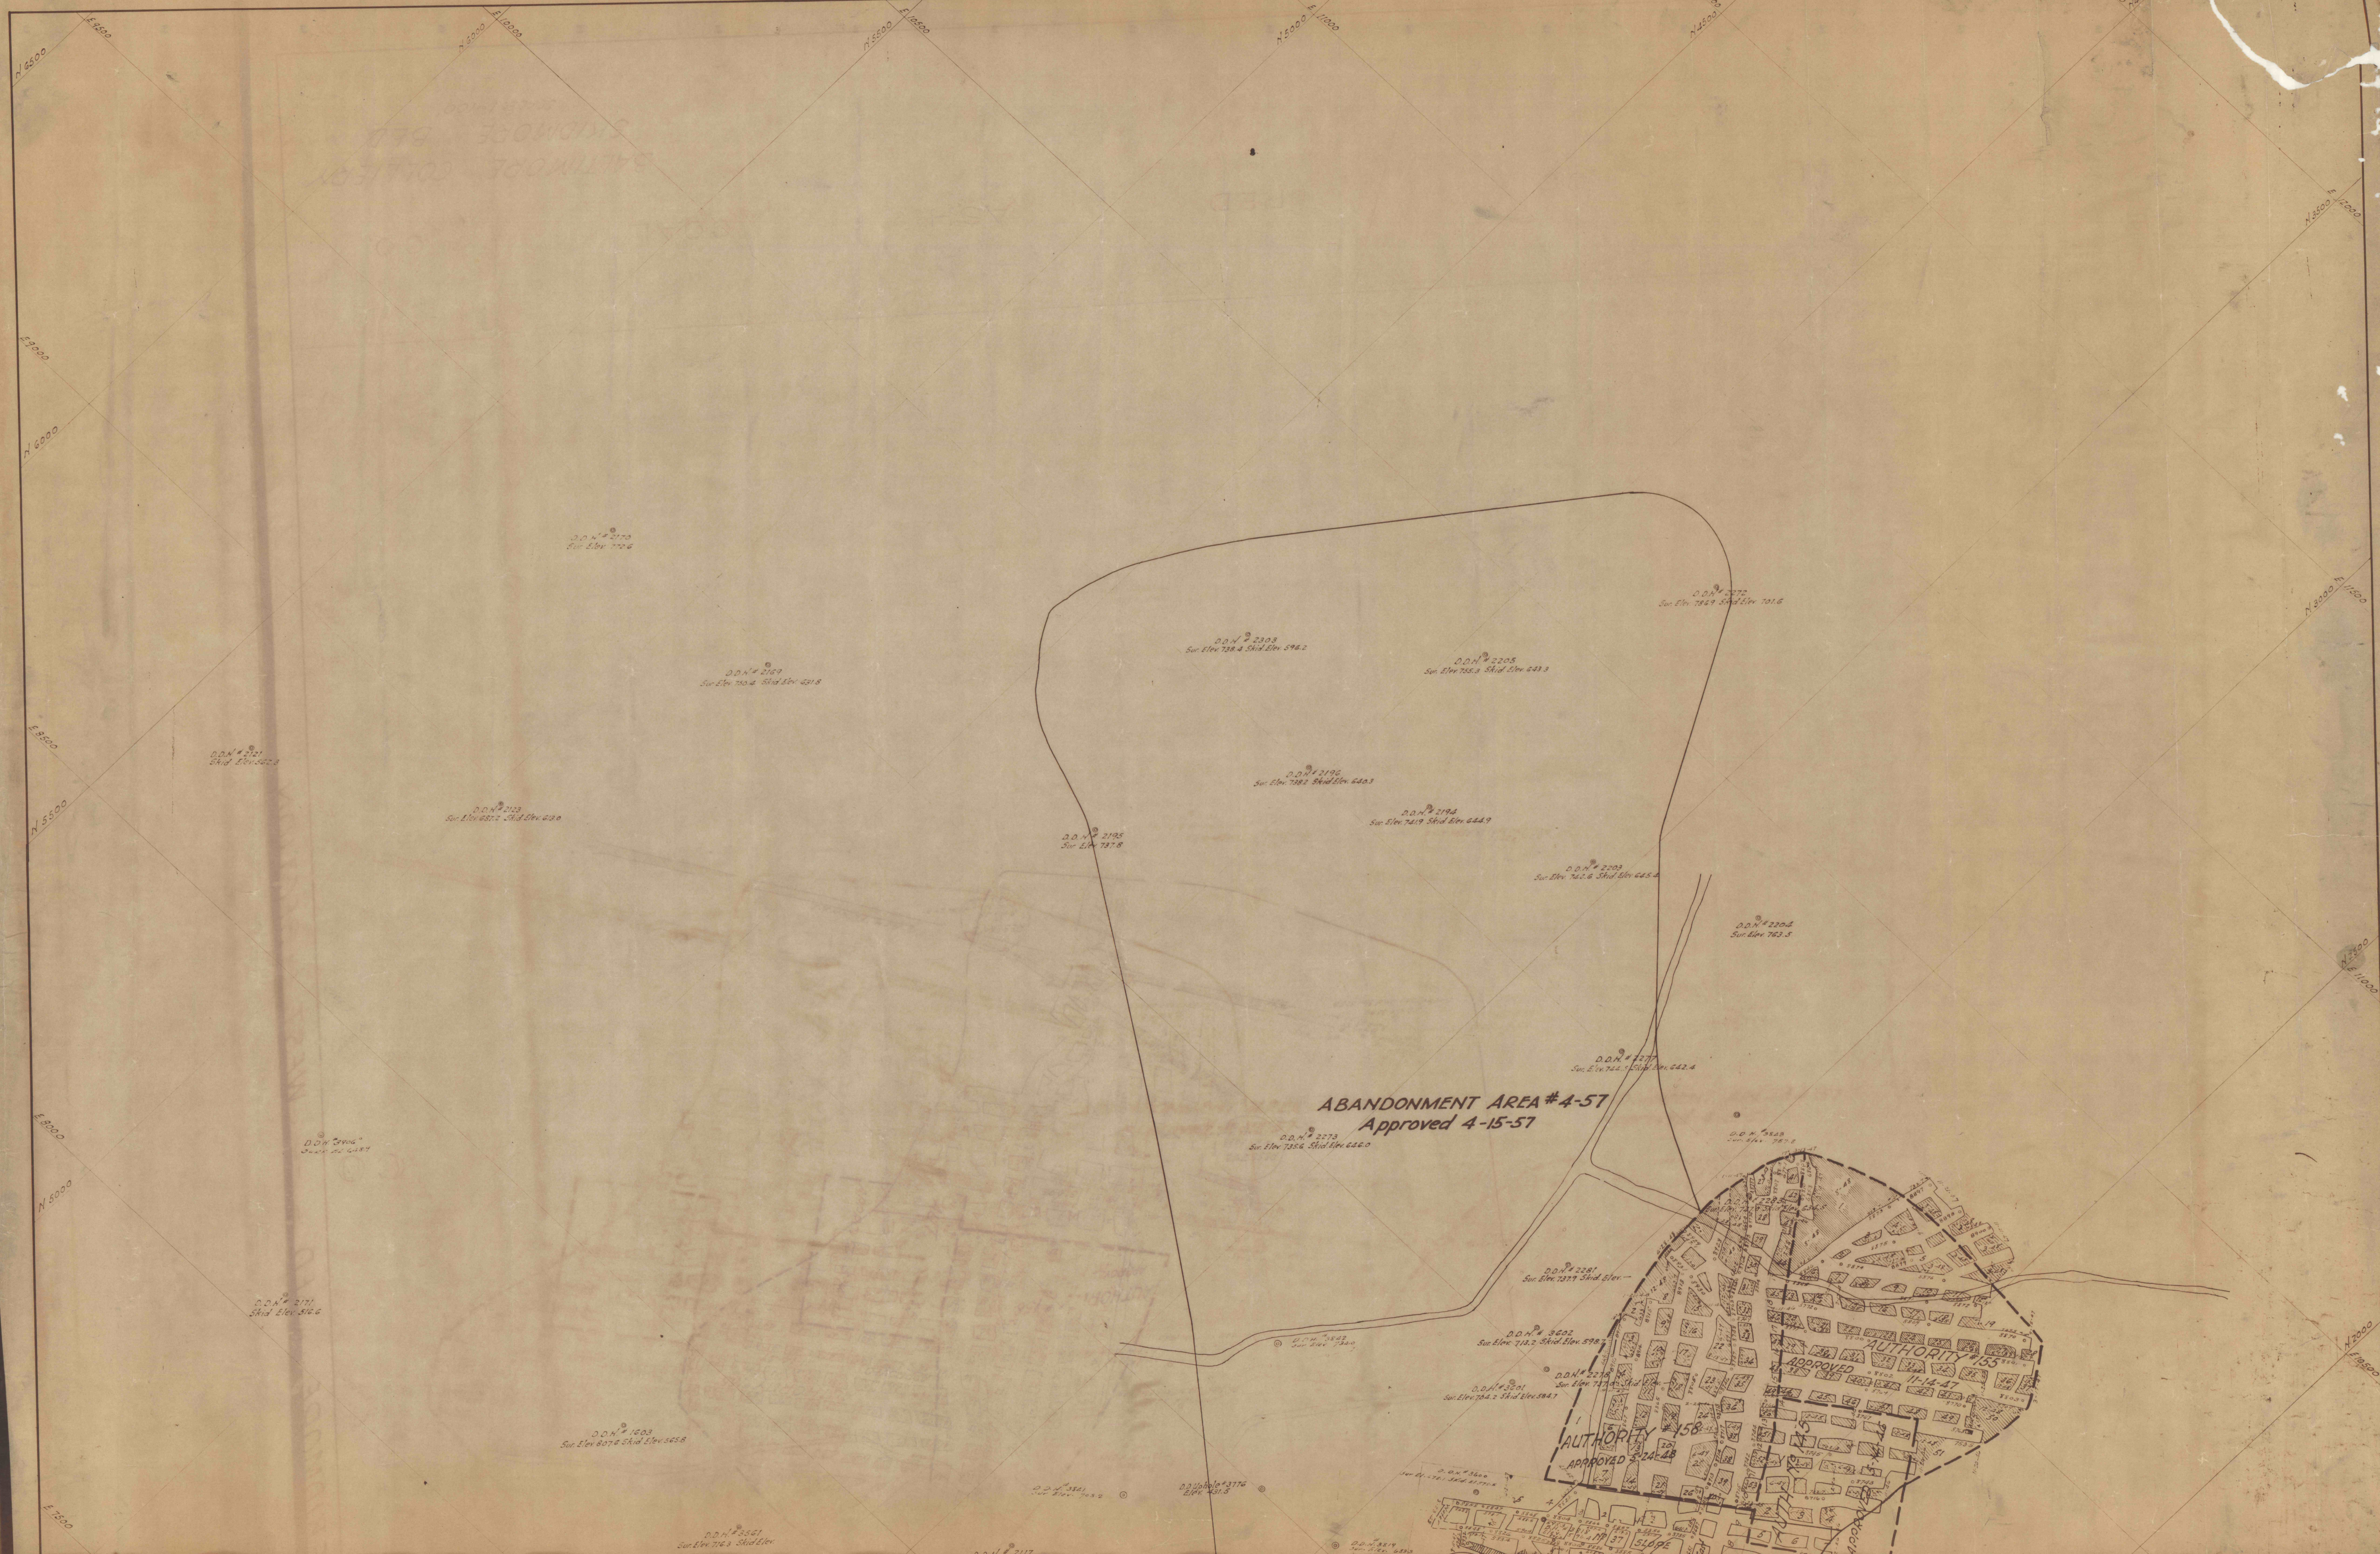

ABANDONMENT AREA #4-57
Approved 4-15-57

AUTHORITY #155

AUTHORITY #158

D.D.N. # 2170
Sur. Elev. 722.4

D.D.N. # 2167
Sur. Elev. 750.4 Skid Elev. 491.8

D.D.N. # 2171
Skid Elev. 516.6

D.D.N. # 2173
Sur. Elev. 627.2 Skid Elev. 600

D.D.N. # 2195
Sur. Elev. 787.8

D.D.N. # 2196
Sur. Elev. 788.3 Skid Elev. 640.3

D.D.N. # 2194
Sur. Elev. 741.9 Skid Elev. 644.9

D.D.N. # 2203
Sur. Elev. 742.6 Skid Elev. 642.4

D.D.N. # 2202
Sur. Elev. 763.5

D.D.N. # 2277
Sur. Elev. 742.1 Skid Elev. 642.4

D.D.N. # 2273
Sur. Elev. 735.6 Skid Elev. 620.0

D.D.N. # 2248
Sur. Elev. 787.2

D.D.N. # 2281
Sur. Elev. 737.9 Skid Elev. 642.4

D.D.N. # 3622
Sur. Elev. 712.2 Skid Elev. 598.2

D.D.N. # 2281
Sur. Elev. 736.2 Skid Elev. 584.7

D.D.N. # 2278
Sur. Elev. 741.2

D.D.N. # 1603
Sur. Elev. 807.6 Skid Elev. 658.8

D.D.N. # 2171
Sur. Elev. 787.8

D.D.N. # 2176
Elev. 731.3

D.D.N. # 2551
Sur. Elev. 716.3 Skid Elev. 642.4

D.D.N. # 2117