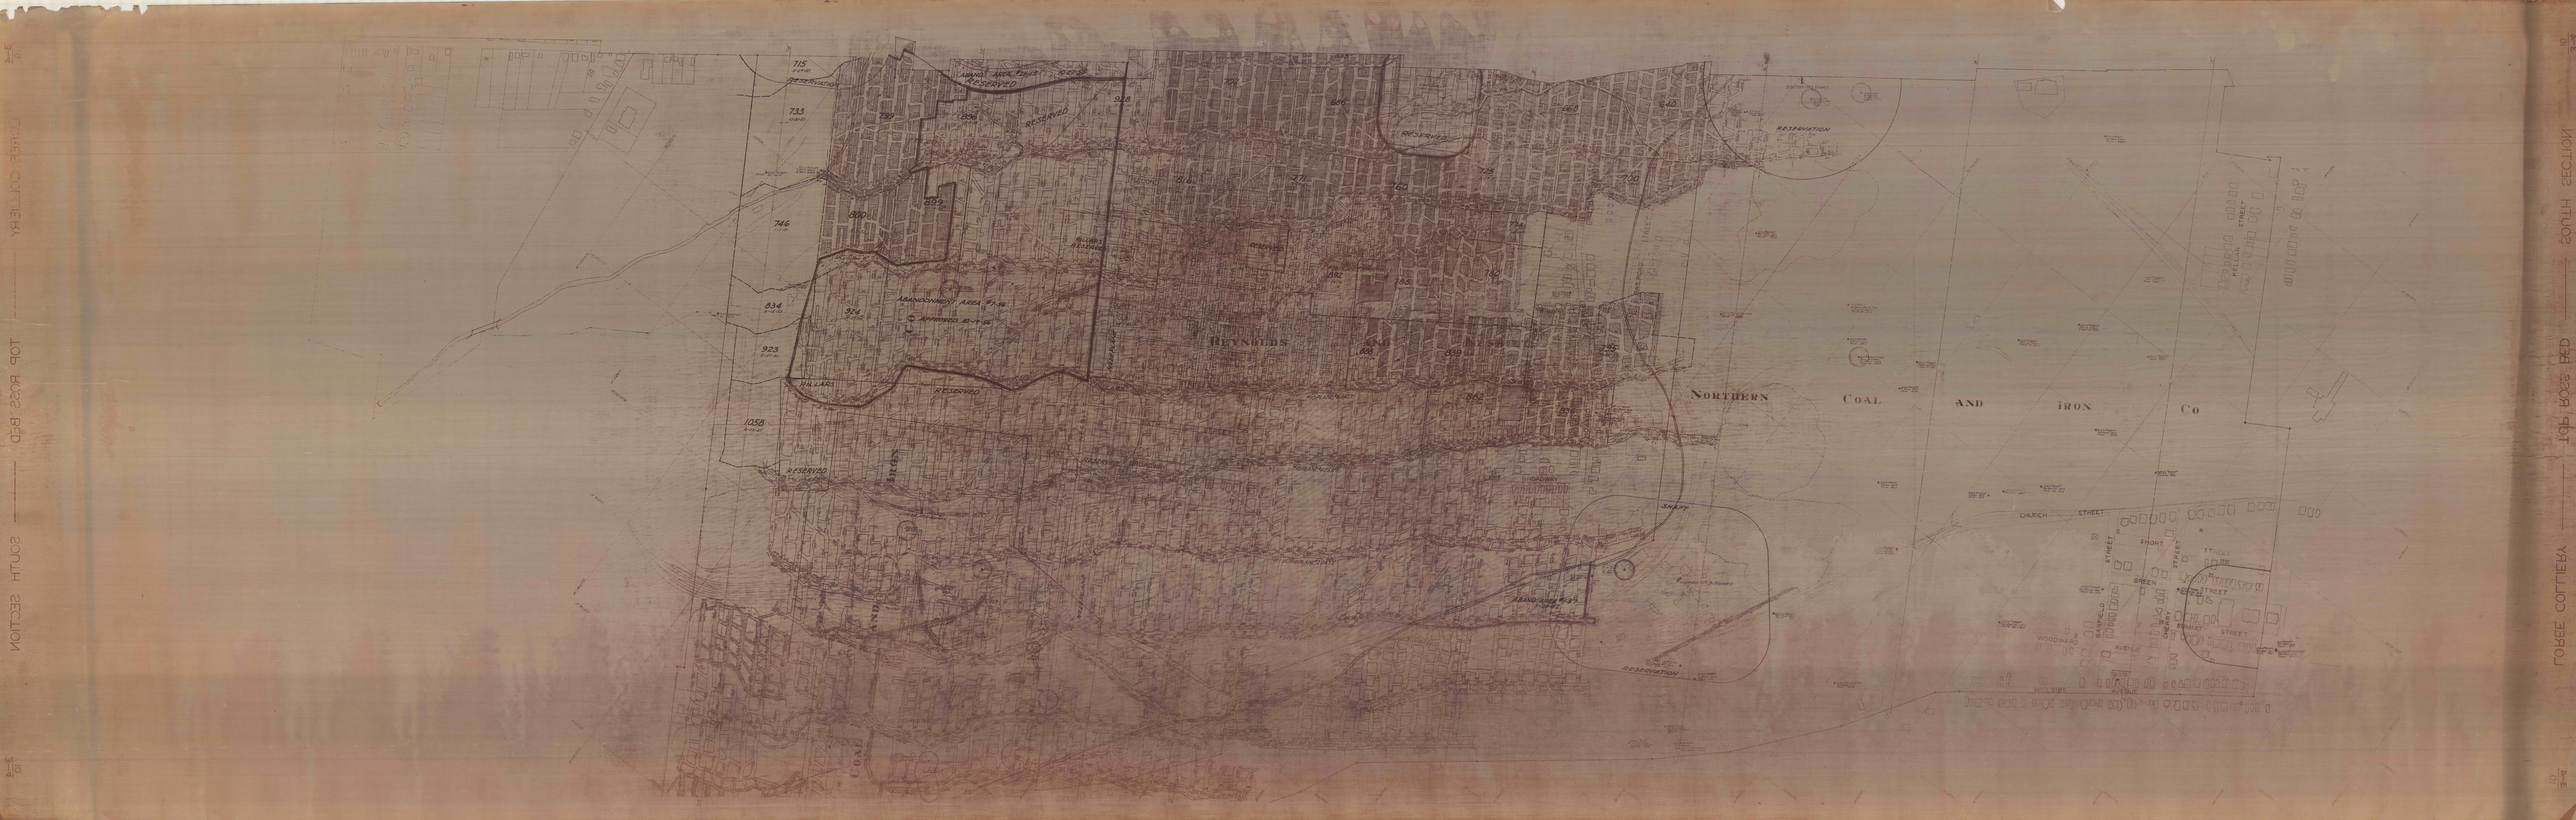

REYNOLDS
NORTHERN COAL AND IRON CO
RESERVATION
ABANDONMENT AREA
HILLARS
SHAFT
CHURCH STREET
SHORT STREET
GREEN STREET
WOODWARD AVENUE
HILLSIDE AVENUE