

DATE OF LAST SURVEY POSTED									
No 2 Shaft		No 3 Shaft		No 4 Shaft		No 5 Shaft		BOSTON	
By	Whom	By	Whom	By	Whom	By	Whom	By	Whom

NC 7/100 FEE
4-19-28 W.T. Payne Lessee for 20 yrs

NC 7/100 2 FEE COAL
1/2 LEASED COAL
4-19-28 W.T. Payne Lessee 1/2 and Coal
for 20 yrs



KINGSTON


KINGSTON

LEHIGH 7/10 WILKES BARRE C CO
NOW GLEN ALDEN COAL CO

PLYMOUTH COAL CO

GLEN ALDEN COAL

A Permit to be done
in this area without
Special Permit

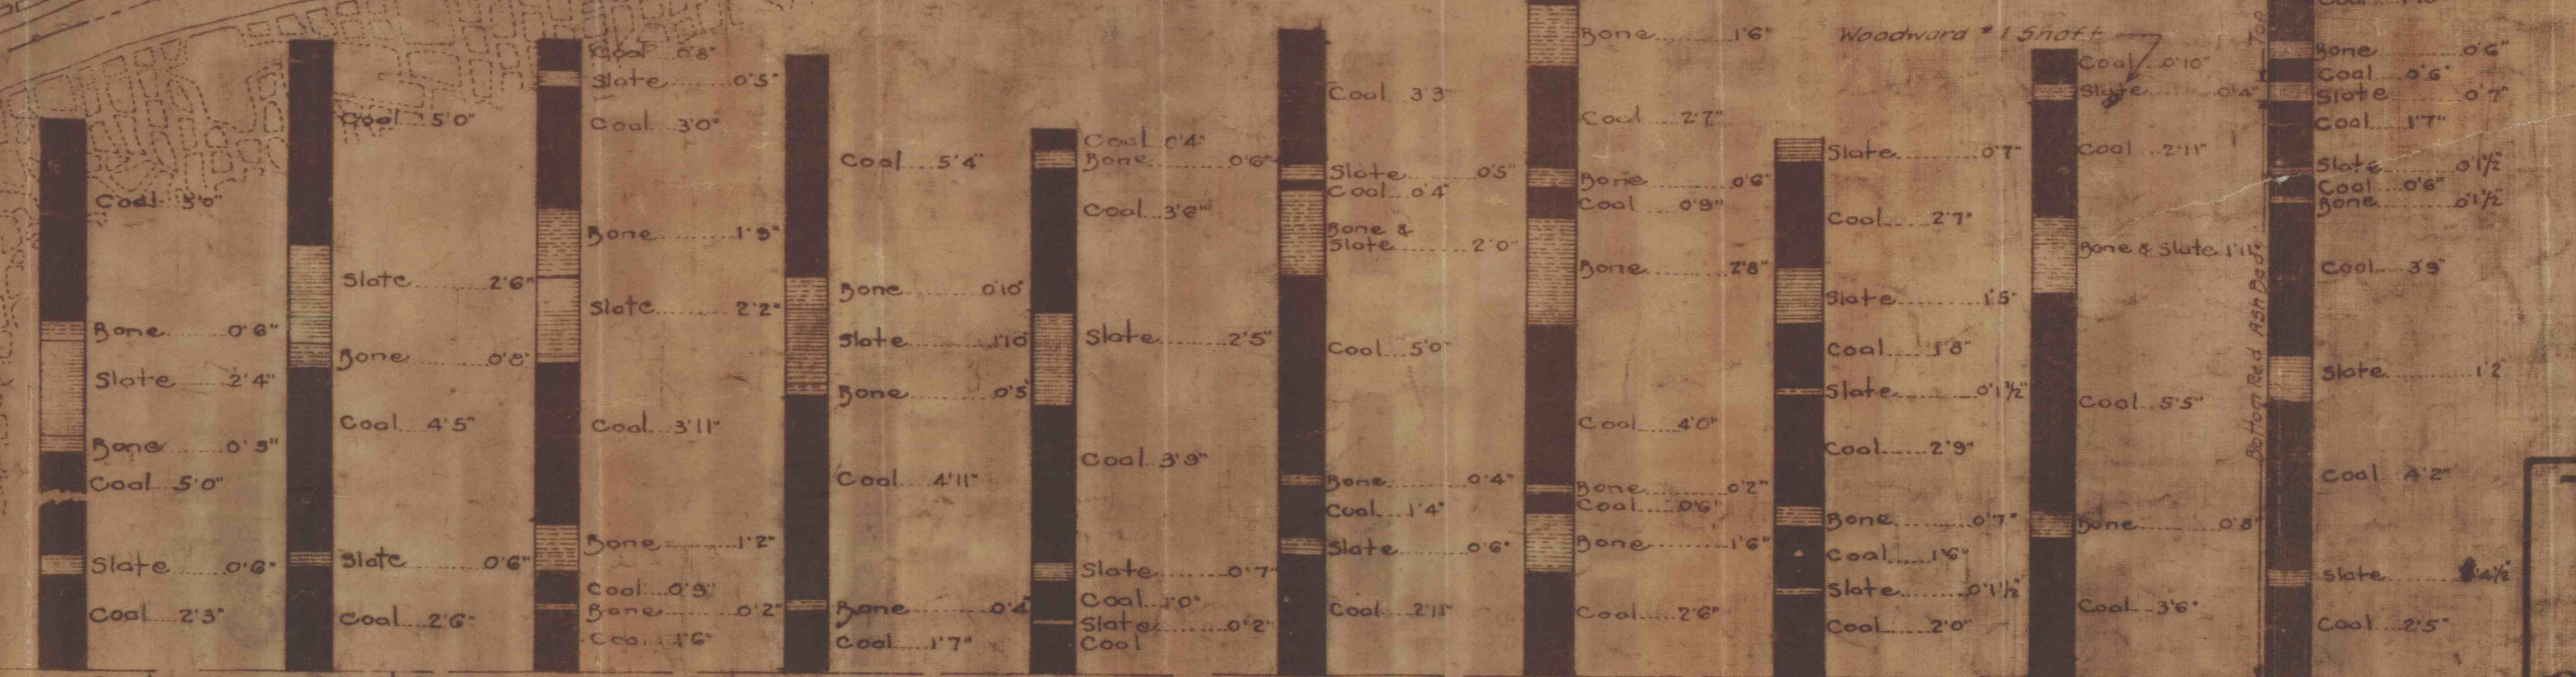

BED SECTIONS