NO. 7 BOTTOM BALTIMORE VEIN NO. 7

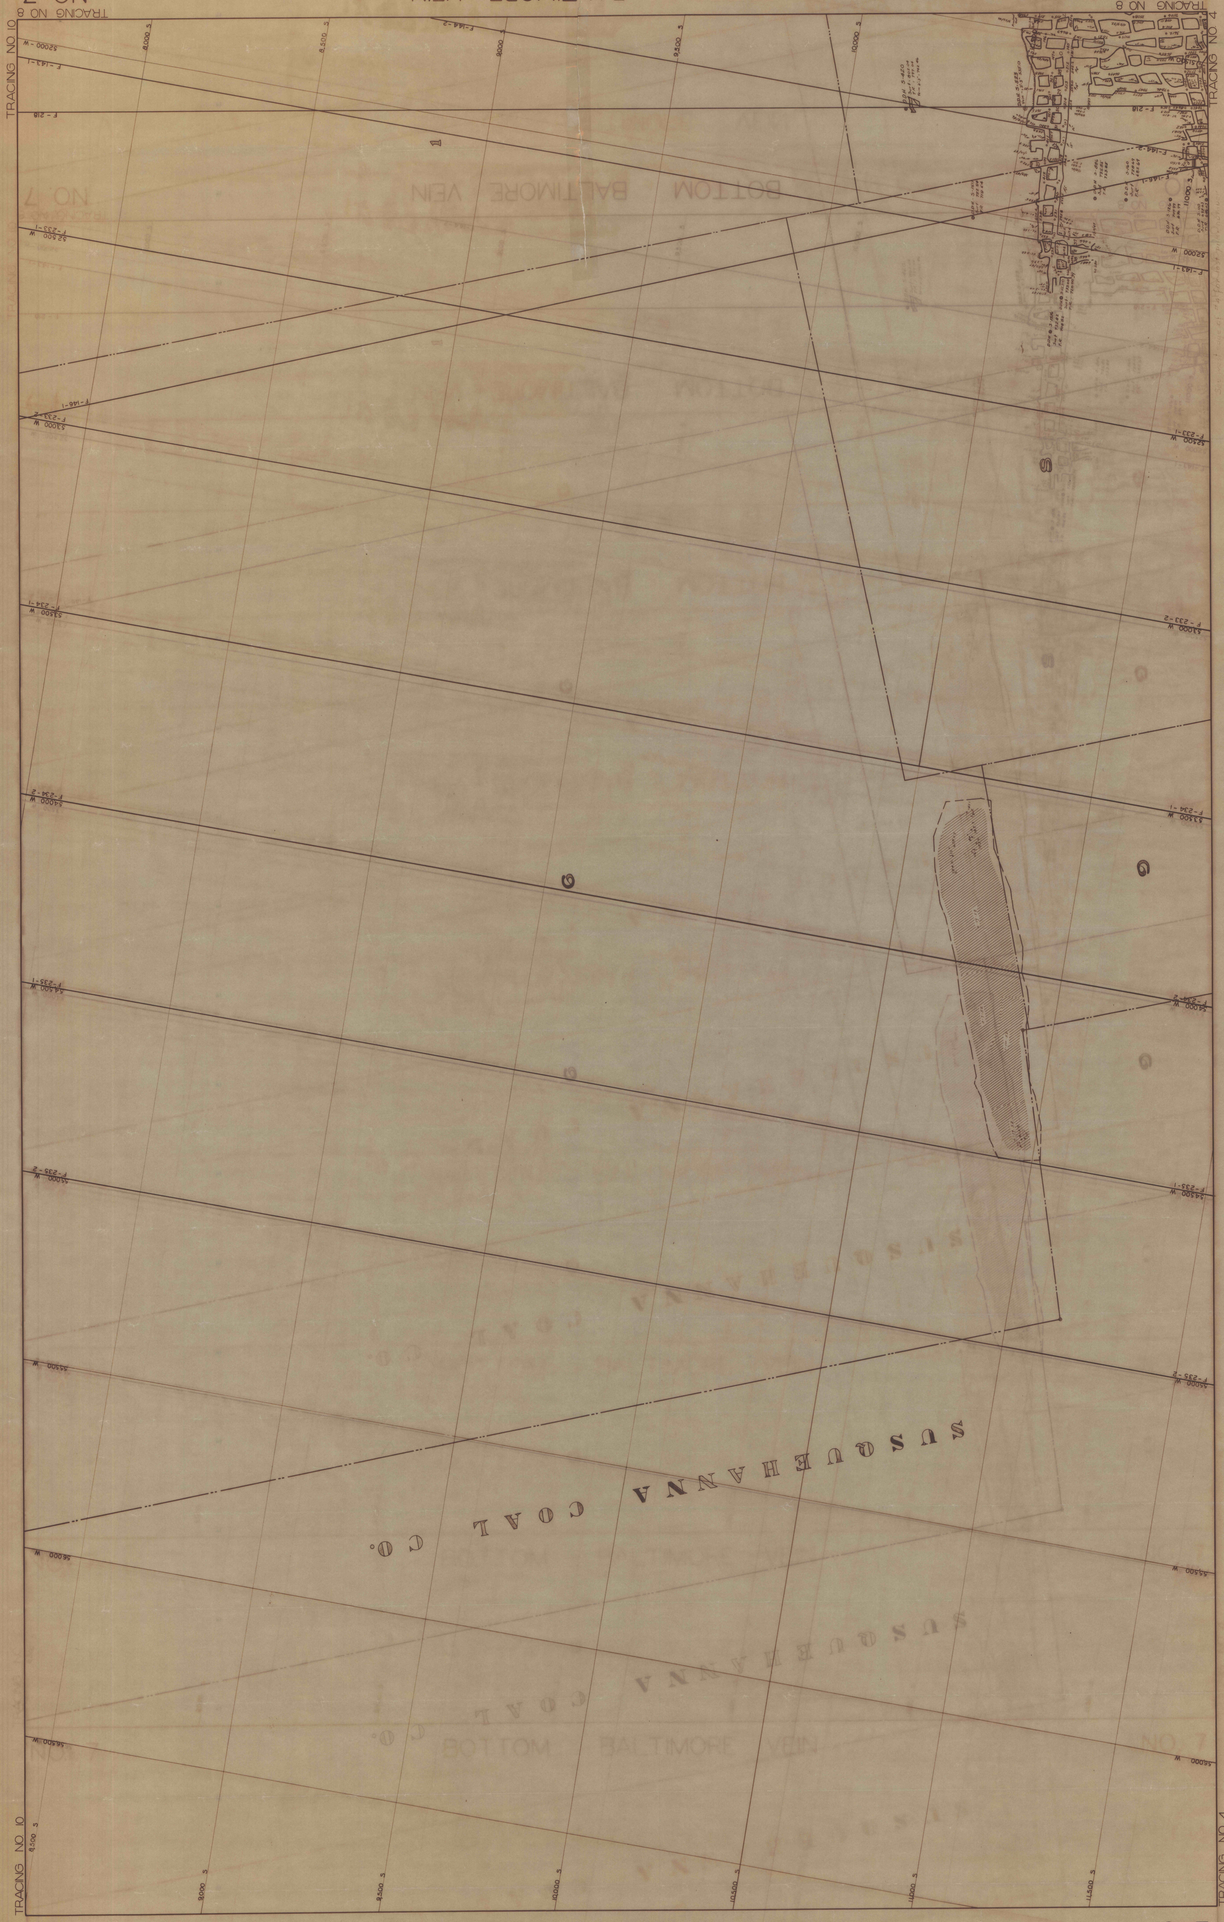

NO. 7 BOTTOM BALTIMORE VEIN NO. 7