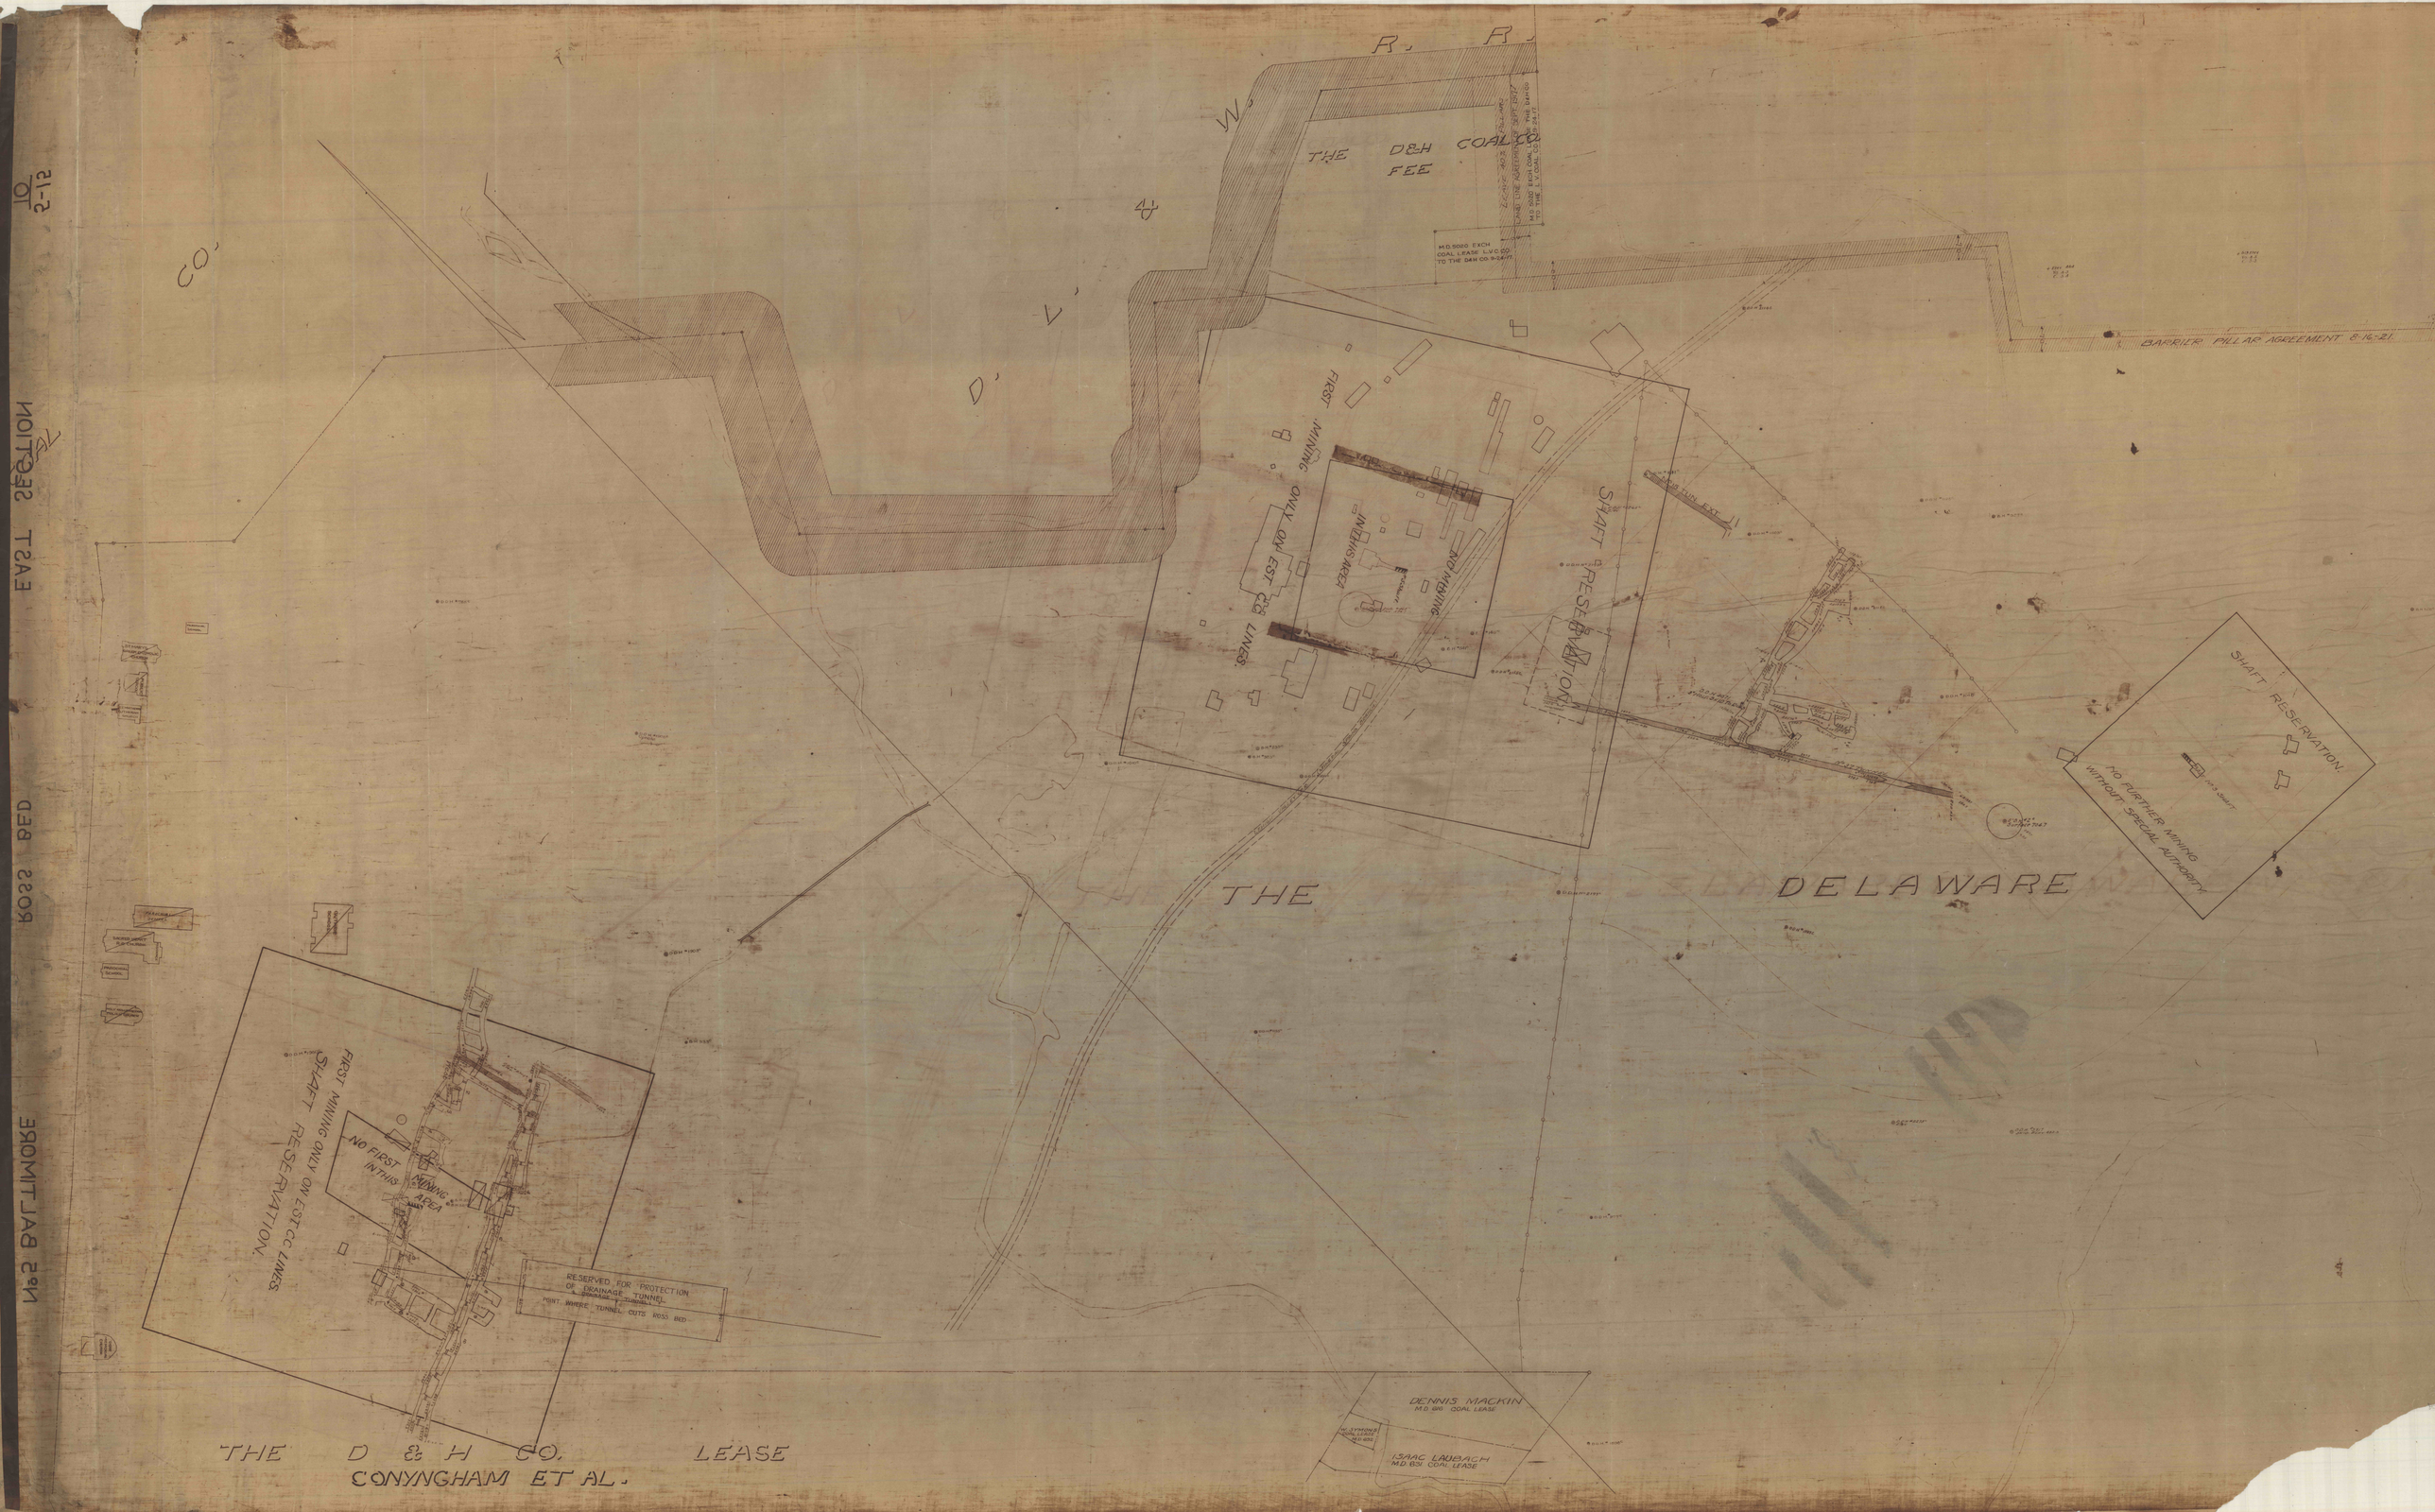

THE D&H COAL CO. FEE
M.D. 5020 EXCH COAL LEASE L.V.C. CO. TO THE D&H CO. 9-24-17
BARRIER PILLAR AGREEMENT 8-16-21
FIRST MINING ONLY ON EST. C.C. LINES.
NO MINING IN THIS AREA
SHAFT RESERVATION
SHAFT RESERVATION.
NO FURTHER MINING WITHOUT SPECIAL AUTHORITY
THE DELAWARE
FIRST MINING ONLY ON EST. C.C. LINES.
SHAFT RESERVATION.
NO FIRST MINING IN THIS AREA
RESERVED FOR PROTECTION OF DRAINAGE TUNNEL
POINT WHERE TUNNEL CUTS ROSS BED
DENNIS MACKIN
M.D. 616 COAL LEASE
ISAAC LAUBACH
M.D. 631 COAL LEASE
THE D & H CO. LEASE
CONYNGHAM ET AL.