


COMPILED P.W.A. 4-2-39	REVISIONS 7-14-59 J.R. SK-P2B311-14AW SK-P2B-311A	SUPERSEDES	SUPERSEDED BY	SYMBOL
---------------------------	---	------------	---------------	--------

SK-P2B311-14A

FAIRBANKS, MORSE & CO.
POMONA WORKS

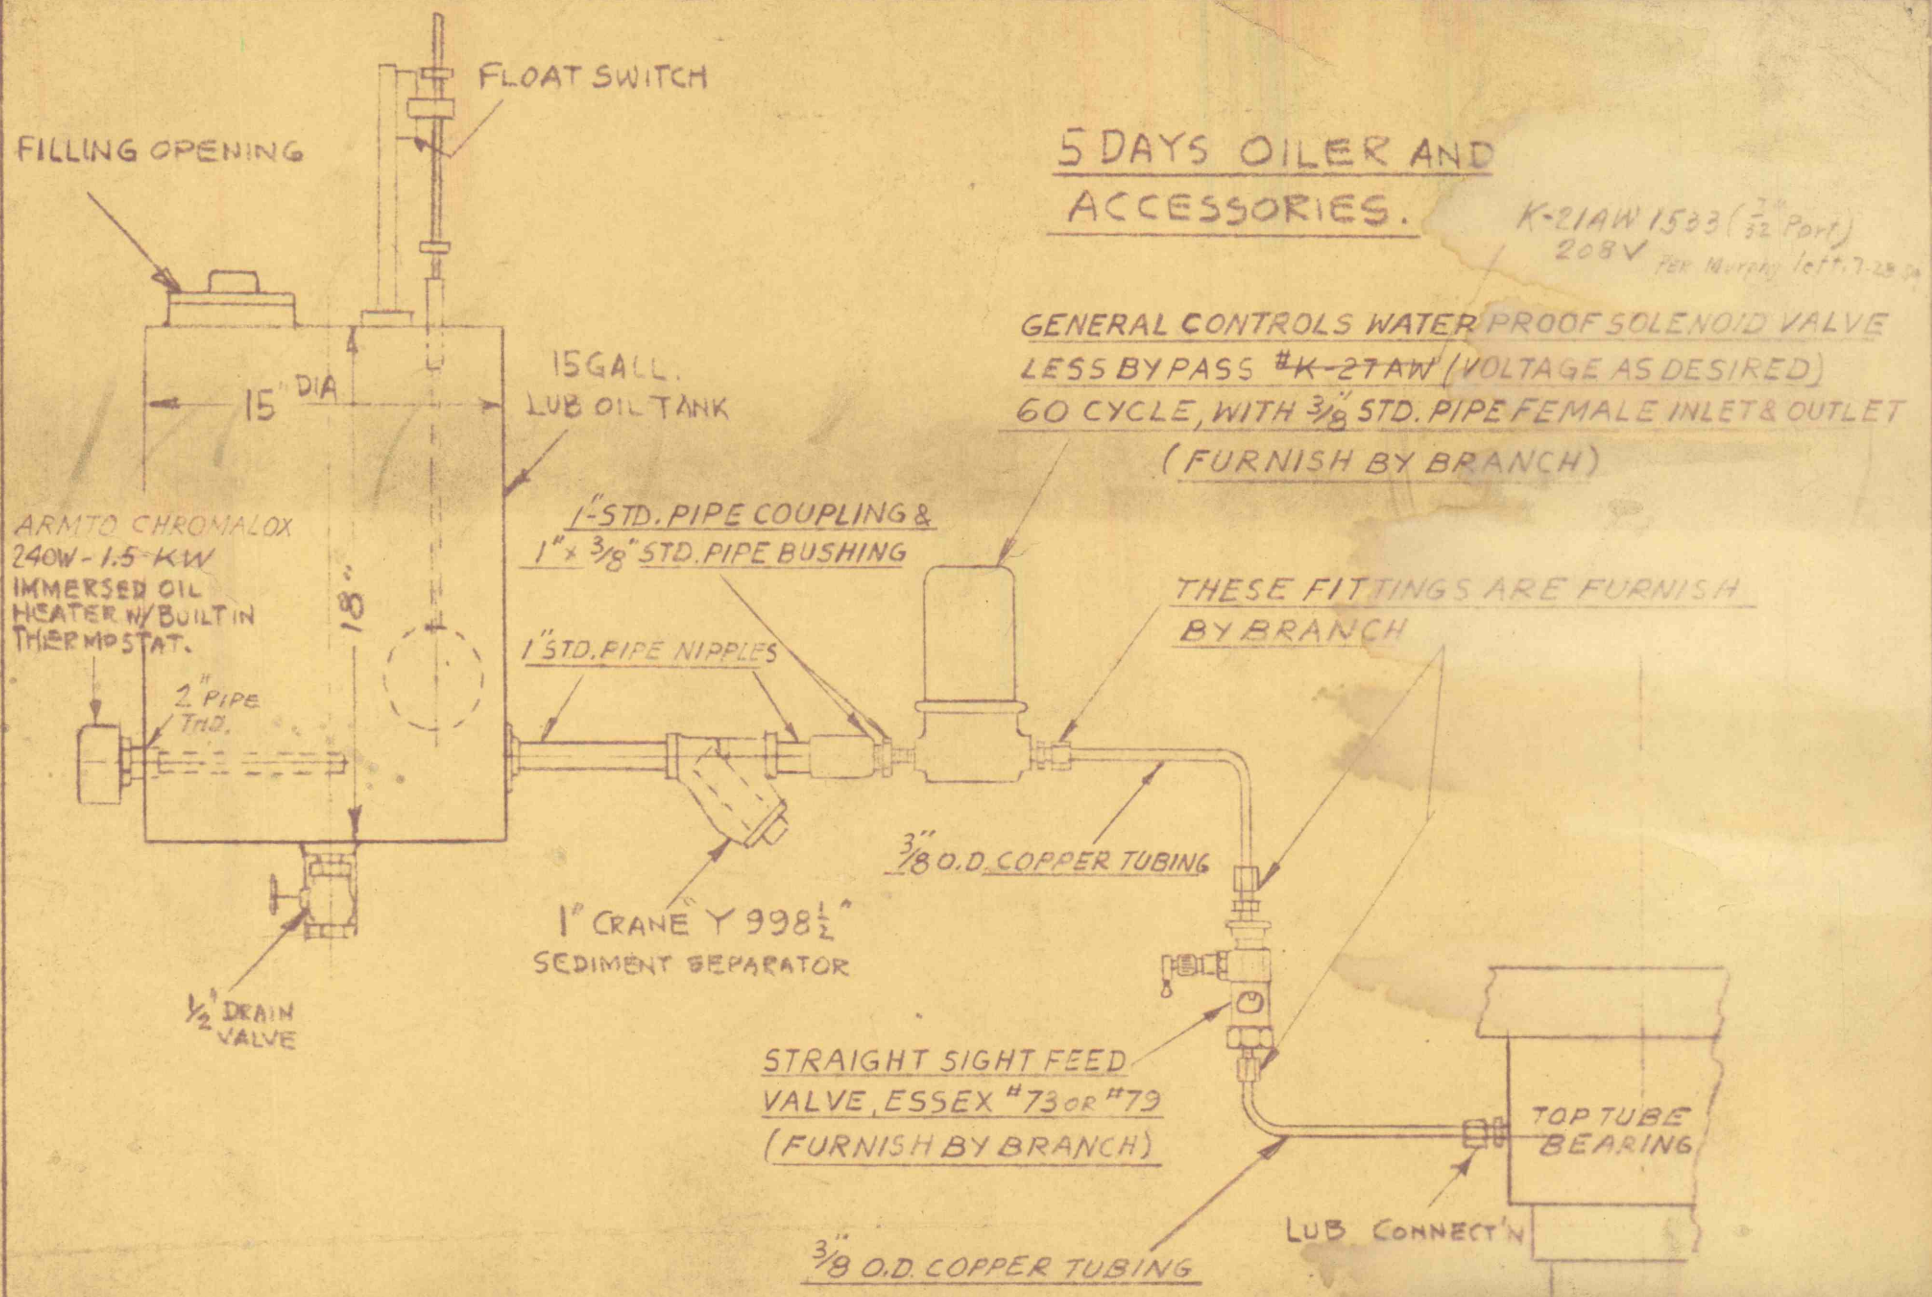

5 DAYS OILER AND ACCESSORIES.

K-21AW 1533 (3/32 Port)
208V
TEX MURPHY lett. 7-25-59

GENERAL CONTROLS WATER PROOF SOLENOID VALVE LESS BYPASS #K-2TAW (VOLTAGE AS DESIRED) 60 CYCLE, WITH 3/8" STD. PIPE FEMALE INLET & OUTLET (FURNISH BY BRANCH)

COMMONWEALTH OF PENNSYLVANIA
SPECIFICATIONS FOR ASKAM SHAFT (TRUESDALE COLLIERY)

FAIRBANKS, MORSE & CO. POMONA WORKS STANDARD CHART