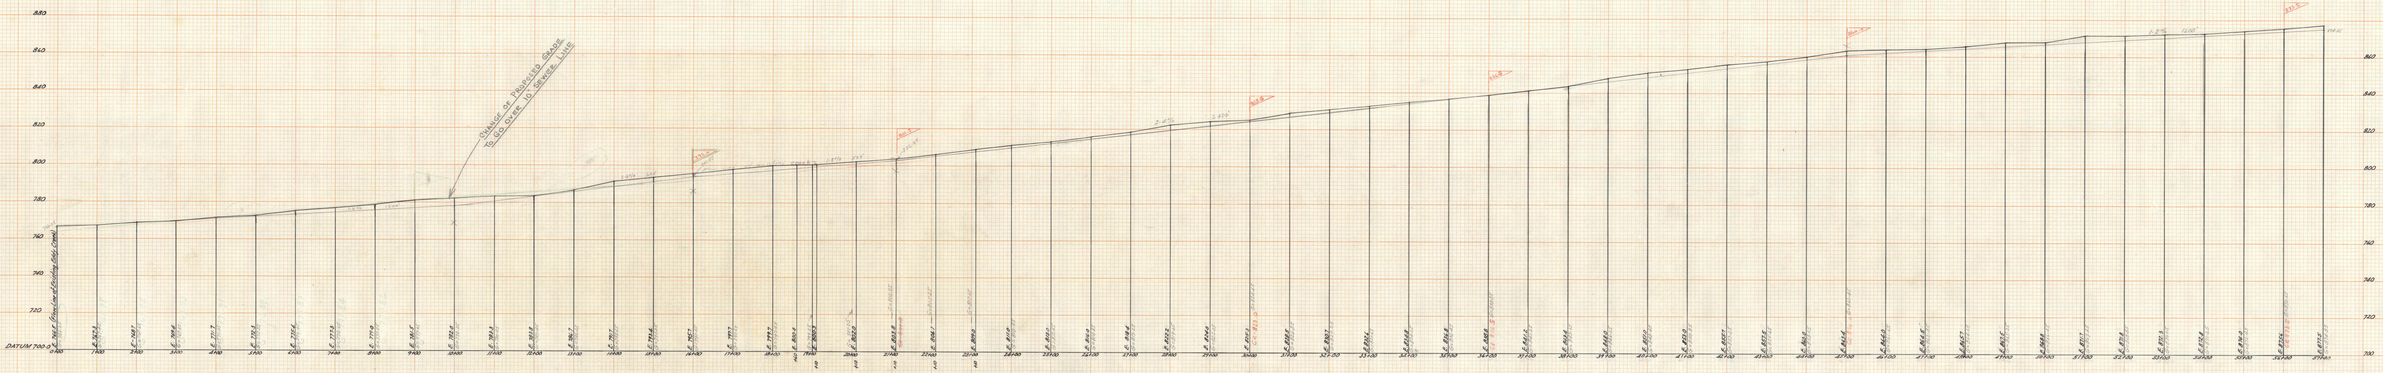
DATUM 700.0
700
710
720
730
740
750
760
770
780
790
800
810
820
830
840
850
860
PROFILE
ON JORDAN CREEK
TRIBUTARY TO EDDY CREEK
SCALE 1"100'/1"20'