
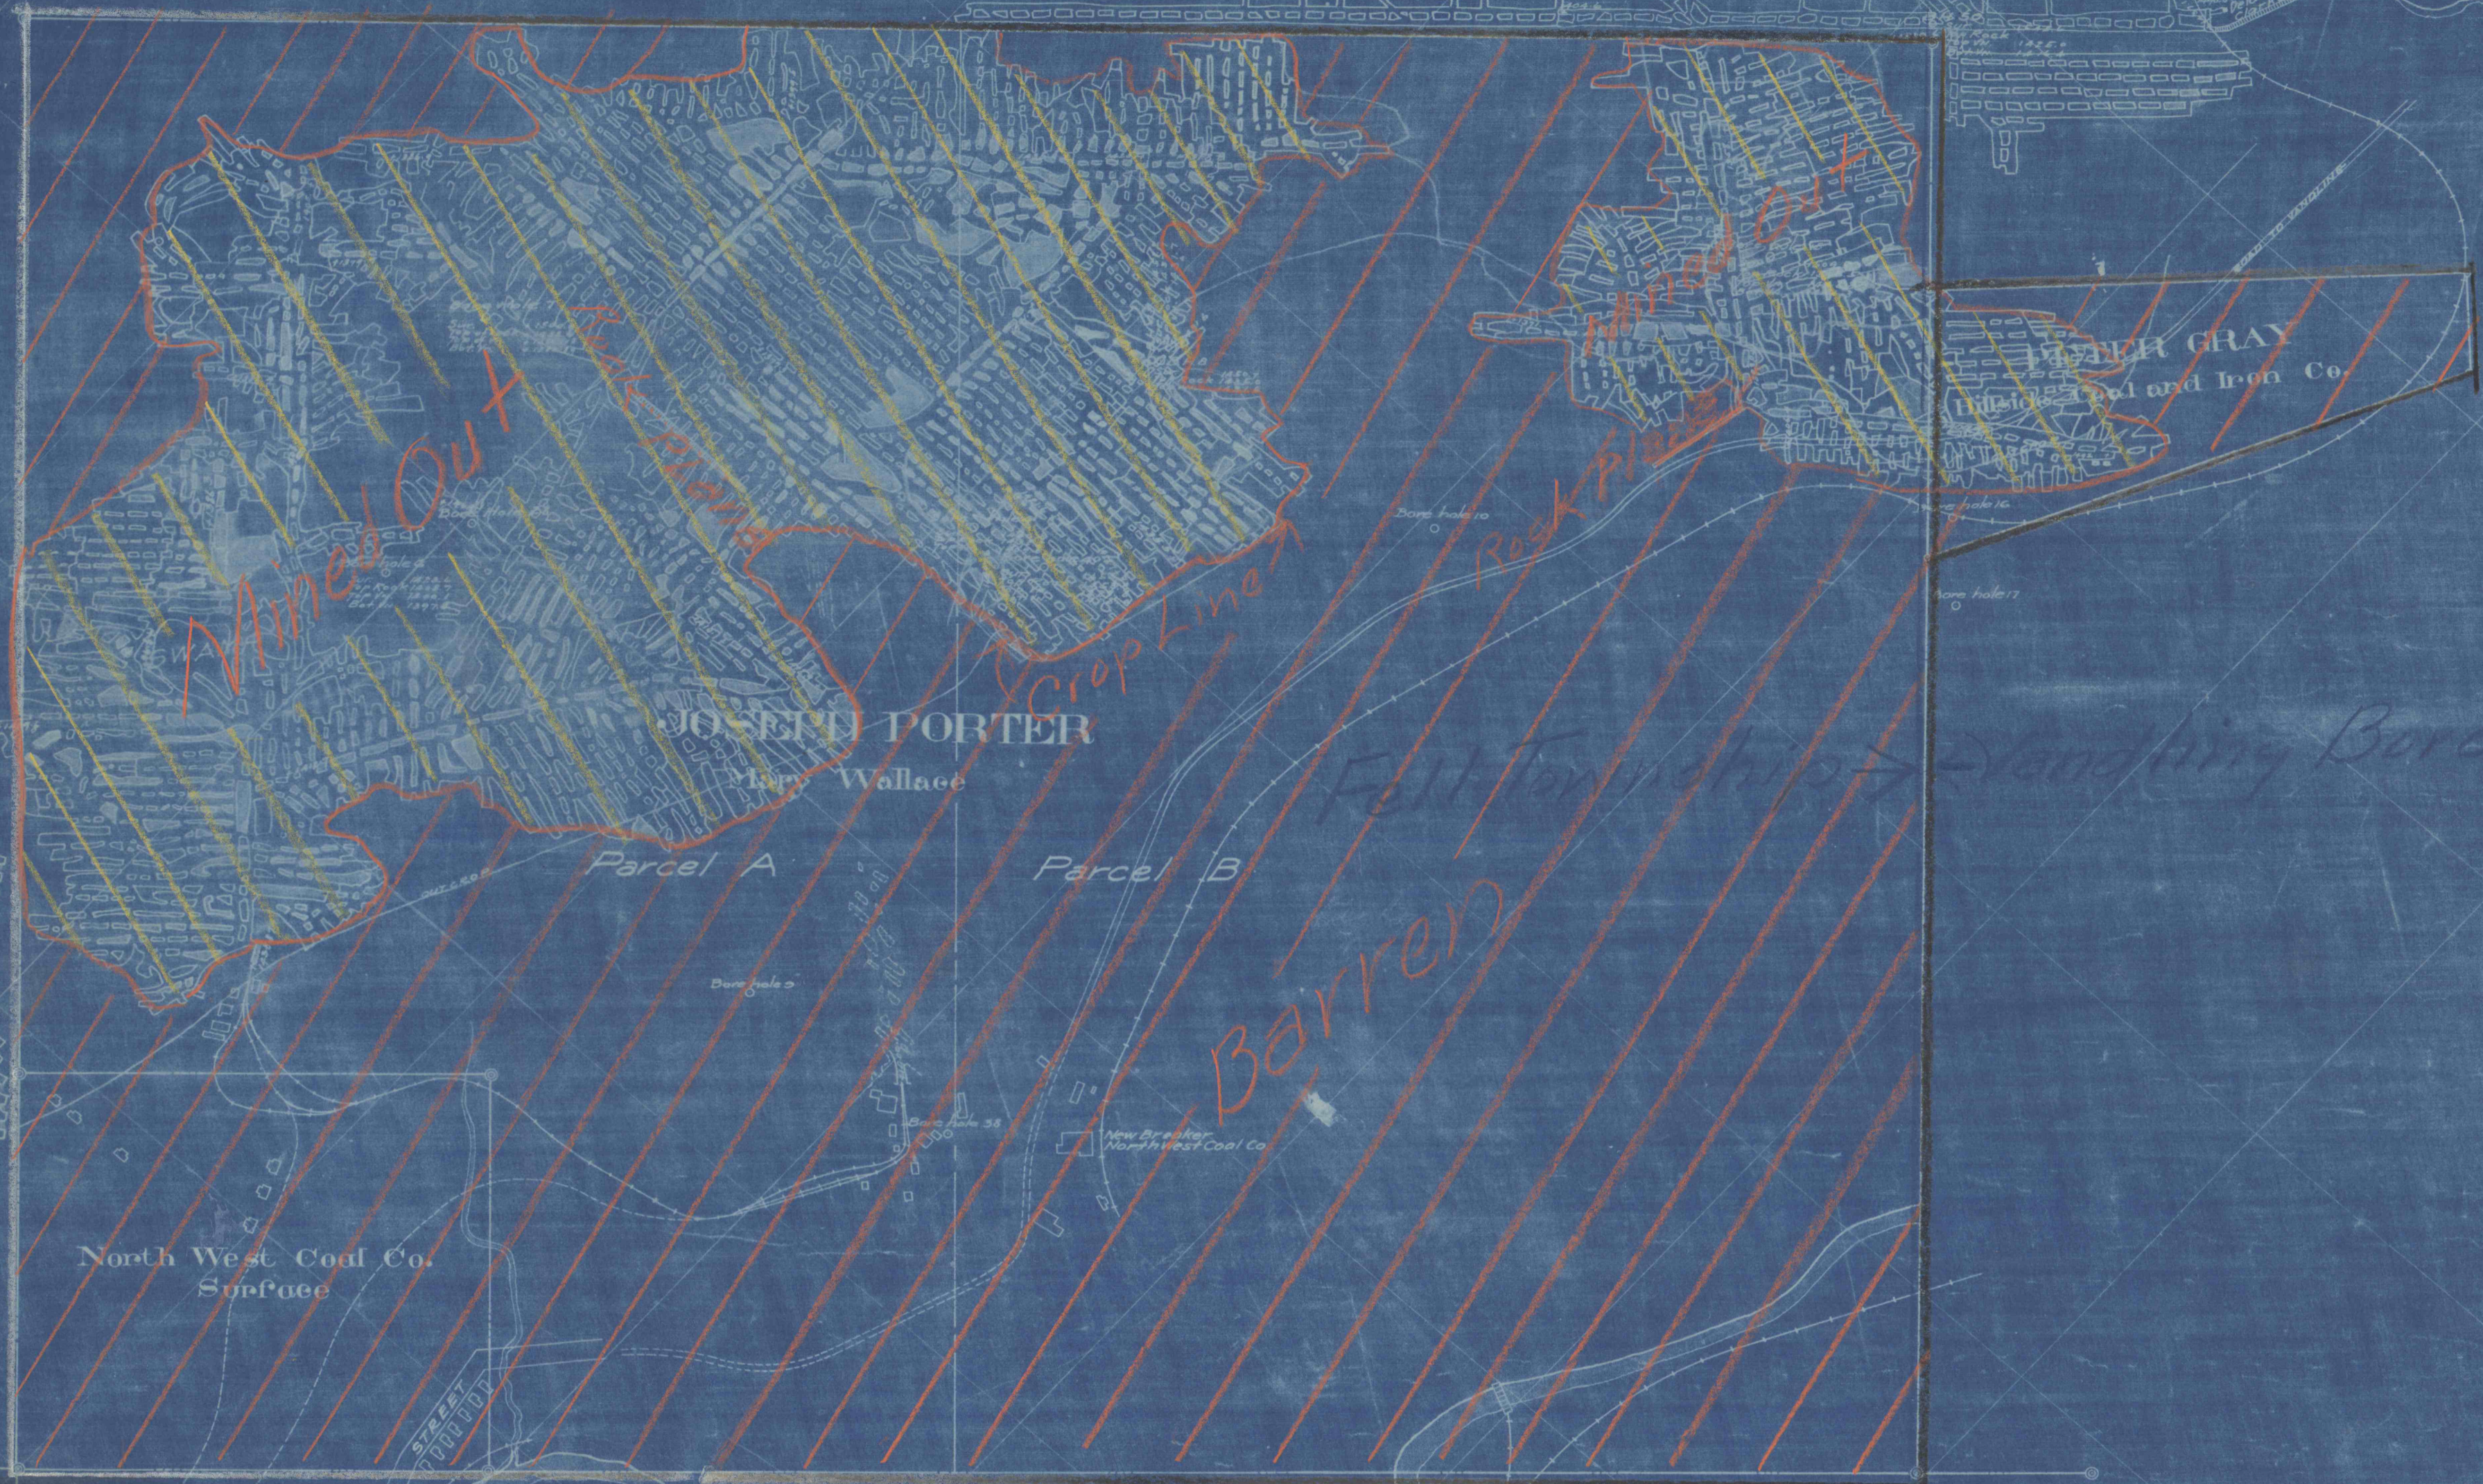


DELAWARE

HUDSON

HUDSON

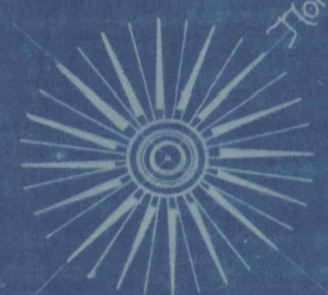

North West Coal Co. Surface

North West Coal Co. Surface

SAMUEL PORTER

North West Colliery  
Fell Township  
Lackawanna County

SAMUEL PORTER

Lake Erie

Western Railroad

New York

Mills Veir's  
Scale 1" = 400'

Wilmington

JOSEPH PORTER

Wallace

Parcel A

Parcel B

Barren


Rocky Point

Hillsdale Coal and Iron Co.

Sheet No. 1222

Scale 1" = 400'

Copyright 1887

Copyright 1887

