

SCALE: 1 INCH = 10 FEET



PENNSYLVANIA TURNPIKE COMMISSION CROSS SECTIONS

CL-1A

District _____ County _____ Route _____ Section _____ Prelim Book No. _____ Final Book No. _____ Sheet No. _____

70 60 50 40 30 20 10 0 10 20 30 40 50 60 70 80

KEY:
Revised Original
Cl. 1A Excavation

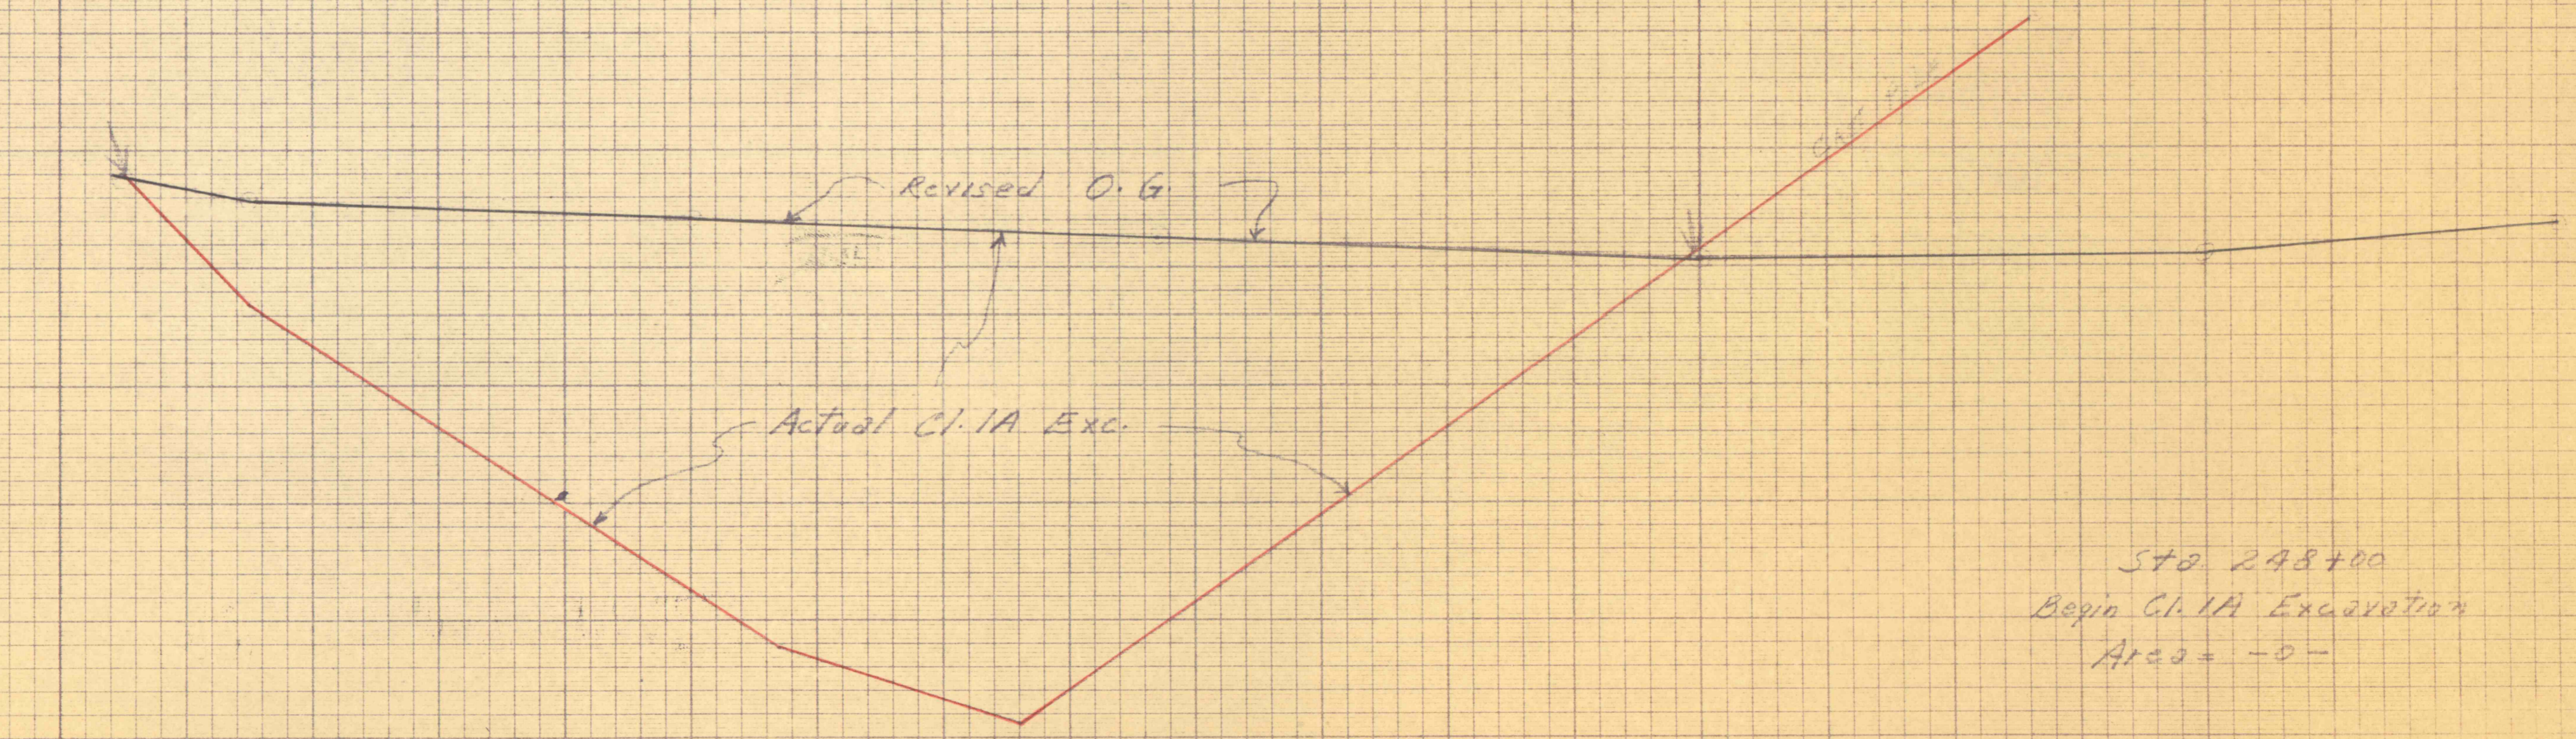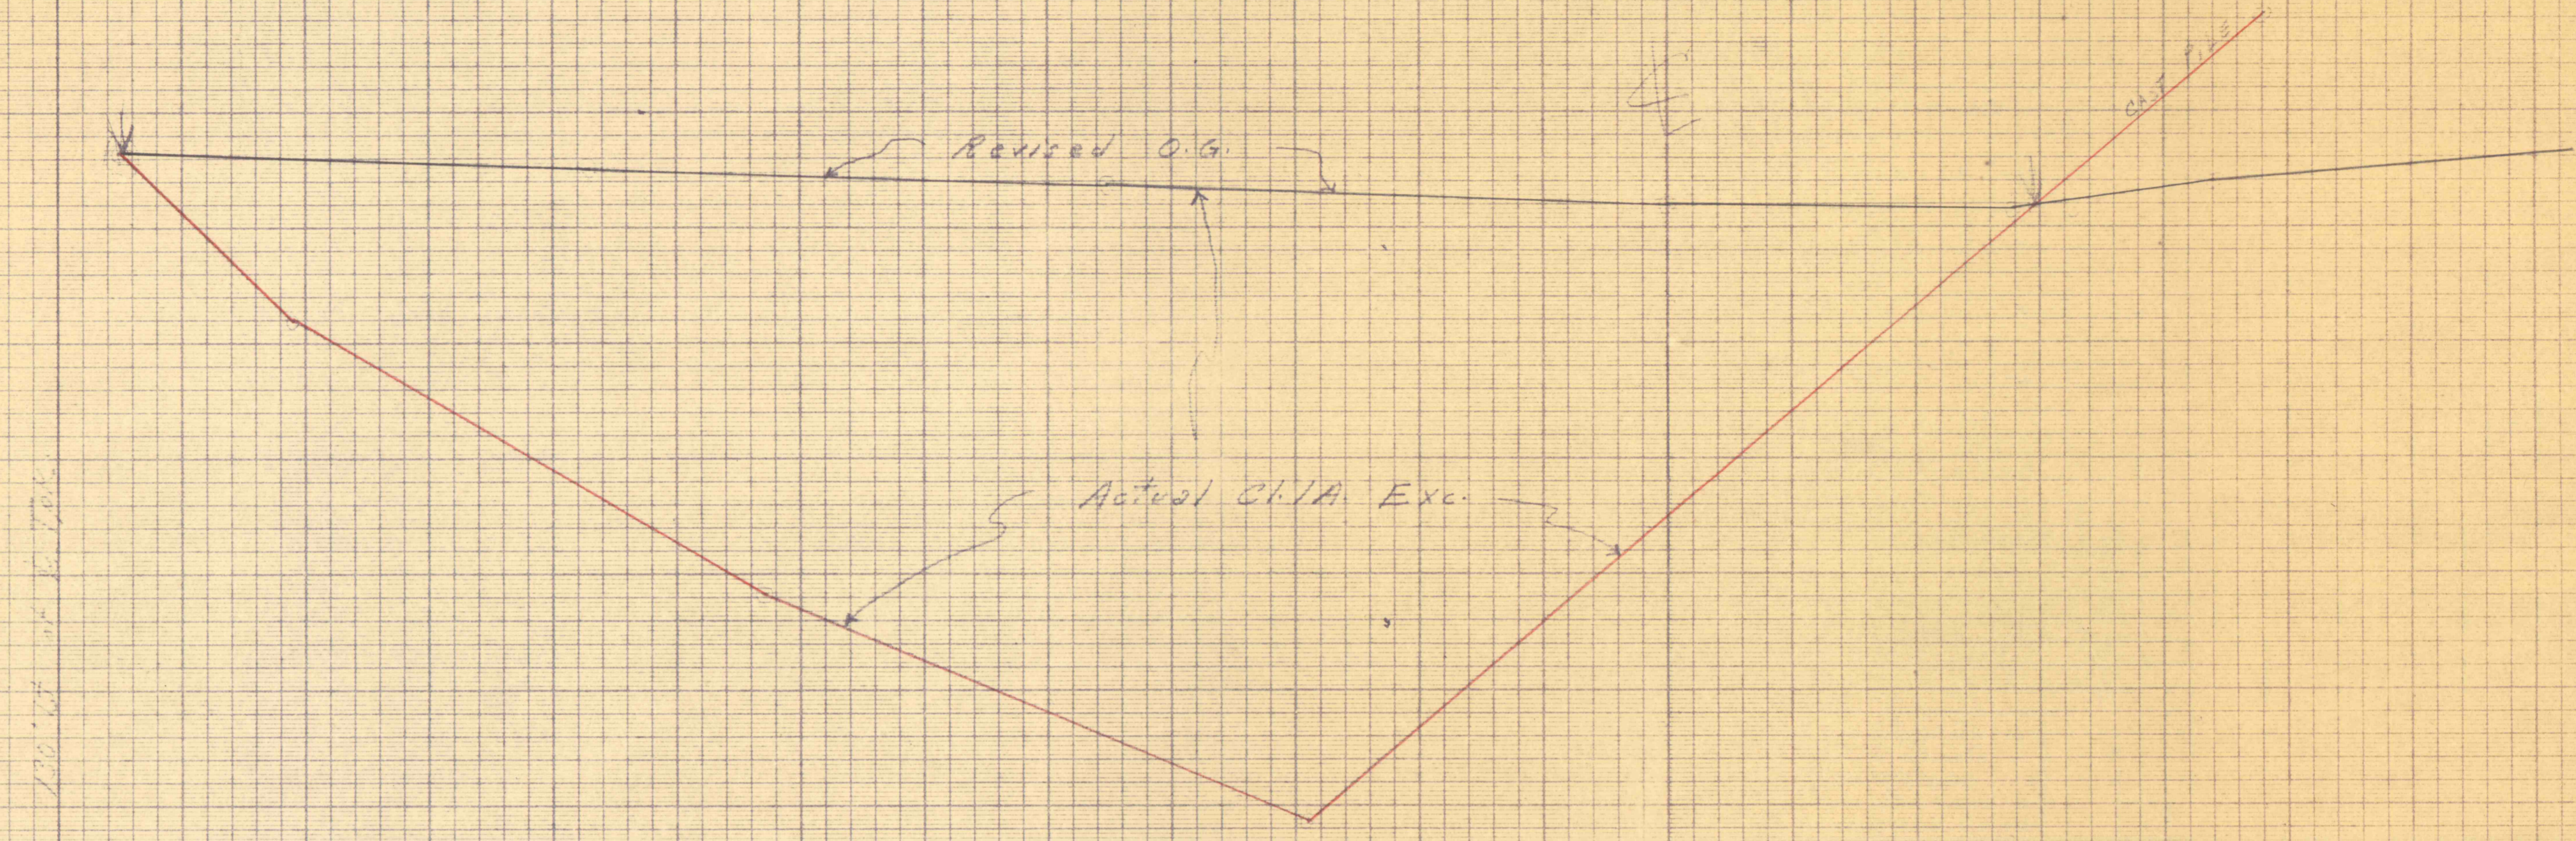

PRELIMINARY	
C.	F.
FINAL	
C.	F.
T.C. 9626	T.F. 9626

248400
870

248400
870

PRELIMINARY	
C.	F.
FINAL	
C.	F.
T.C. 2820	T.F. 2820

Sta 248400
Begin Cl. 1A Excavation
Area = -0-

30 20 10 0 10 20 30 40 30 20 10 0 10 20

SCALE: 1 INCH = 5 FEET