


SCALE: 1/4 INCH = 10 FEET

PENNSYLVANIA
TURNPIKE COMMISSION
CROSS SECTIONS

CI-1A Exc.


District	County	Route	Sec.	Prelim. Book No.	Final Book No.	Sheet No.
				377	332	C-157-531

80 70 60 50 40 30 20 10 0 10 20 30 40 50 60 70 80

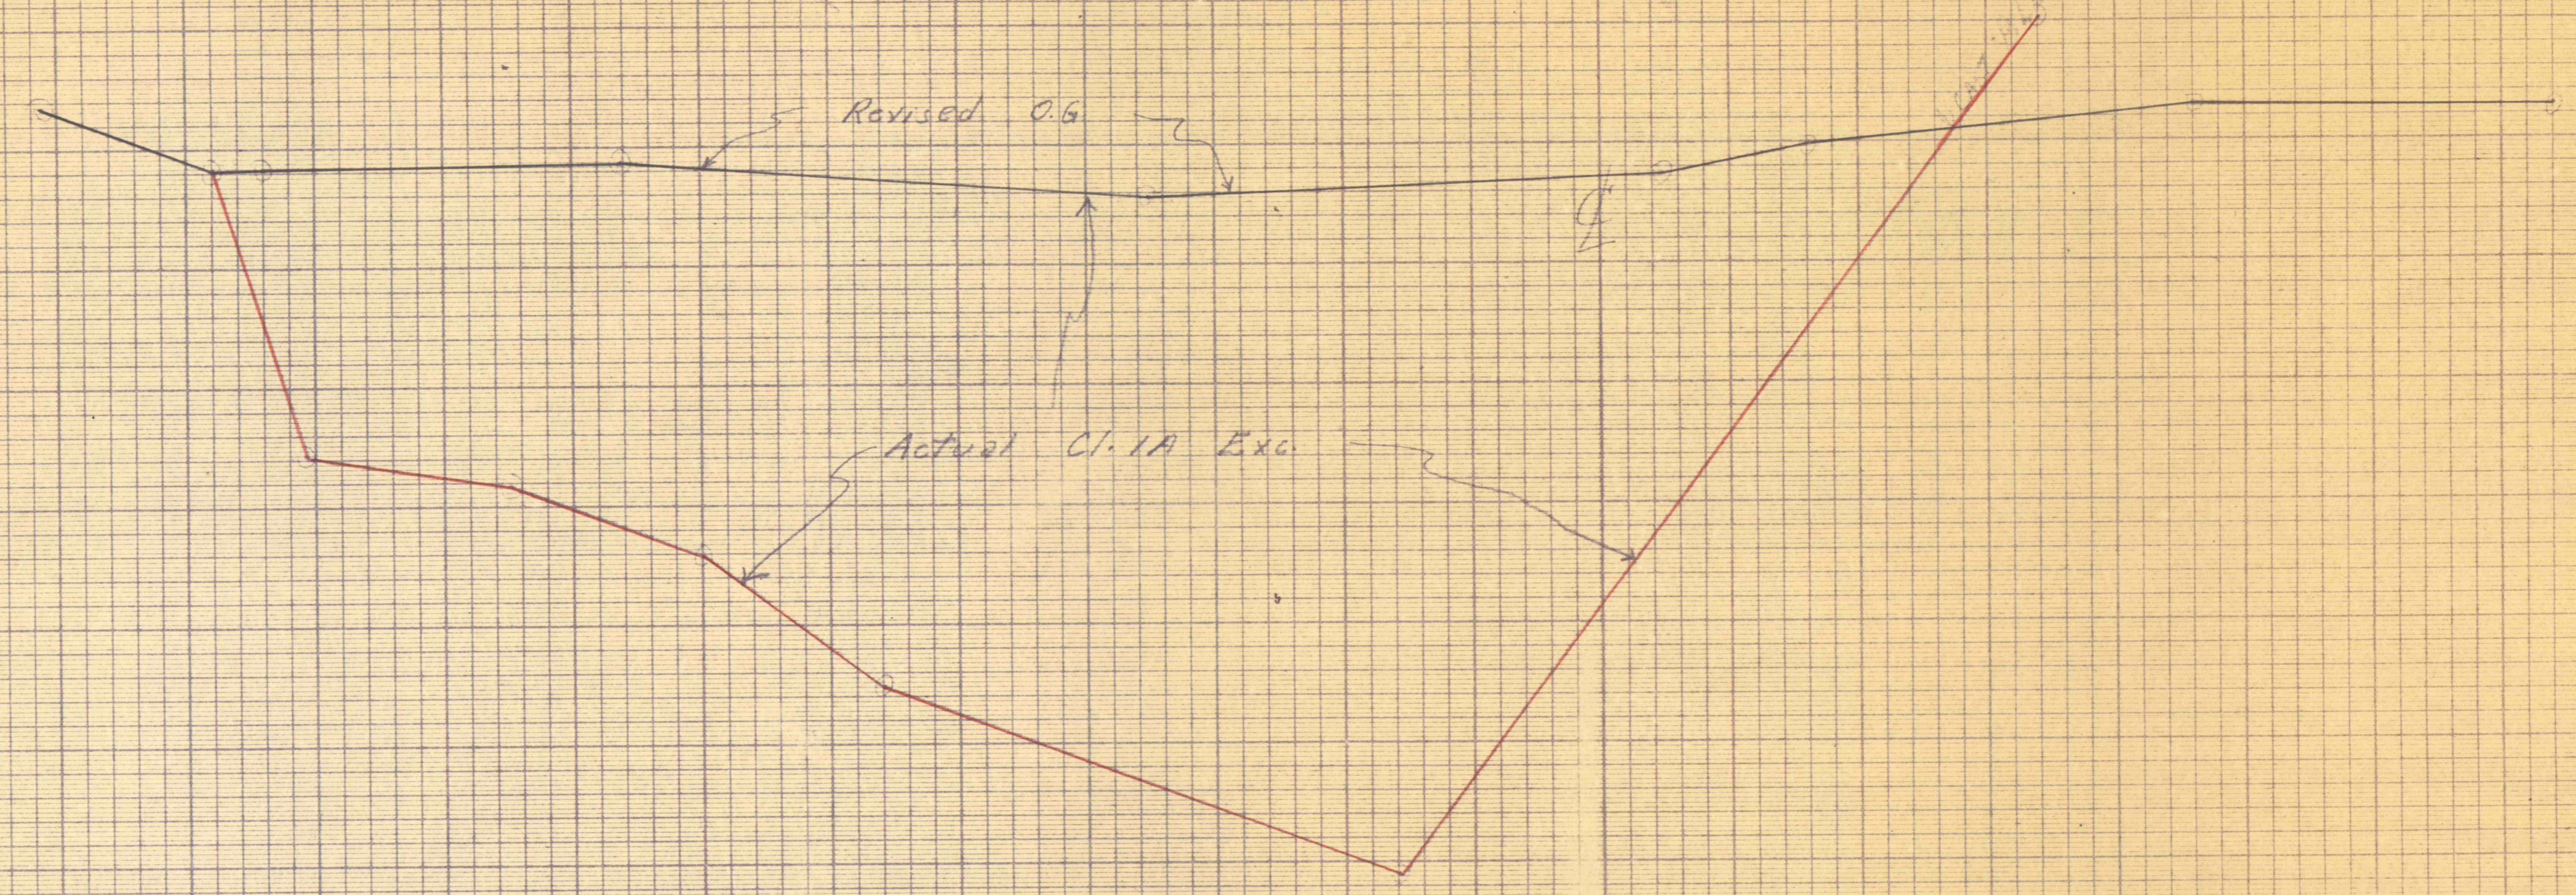

298175
850

PRELIMINARY	
C.	F.
FINA	
C.	F.
T.C. 7658 T.F. 4658	

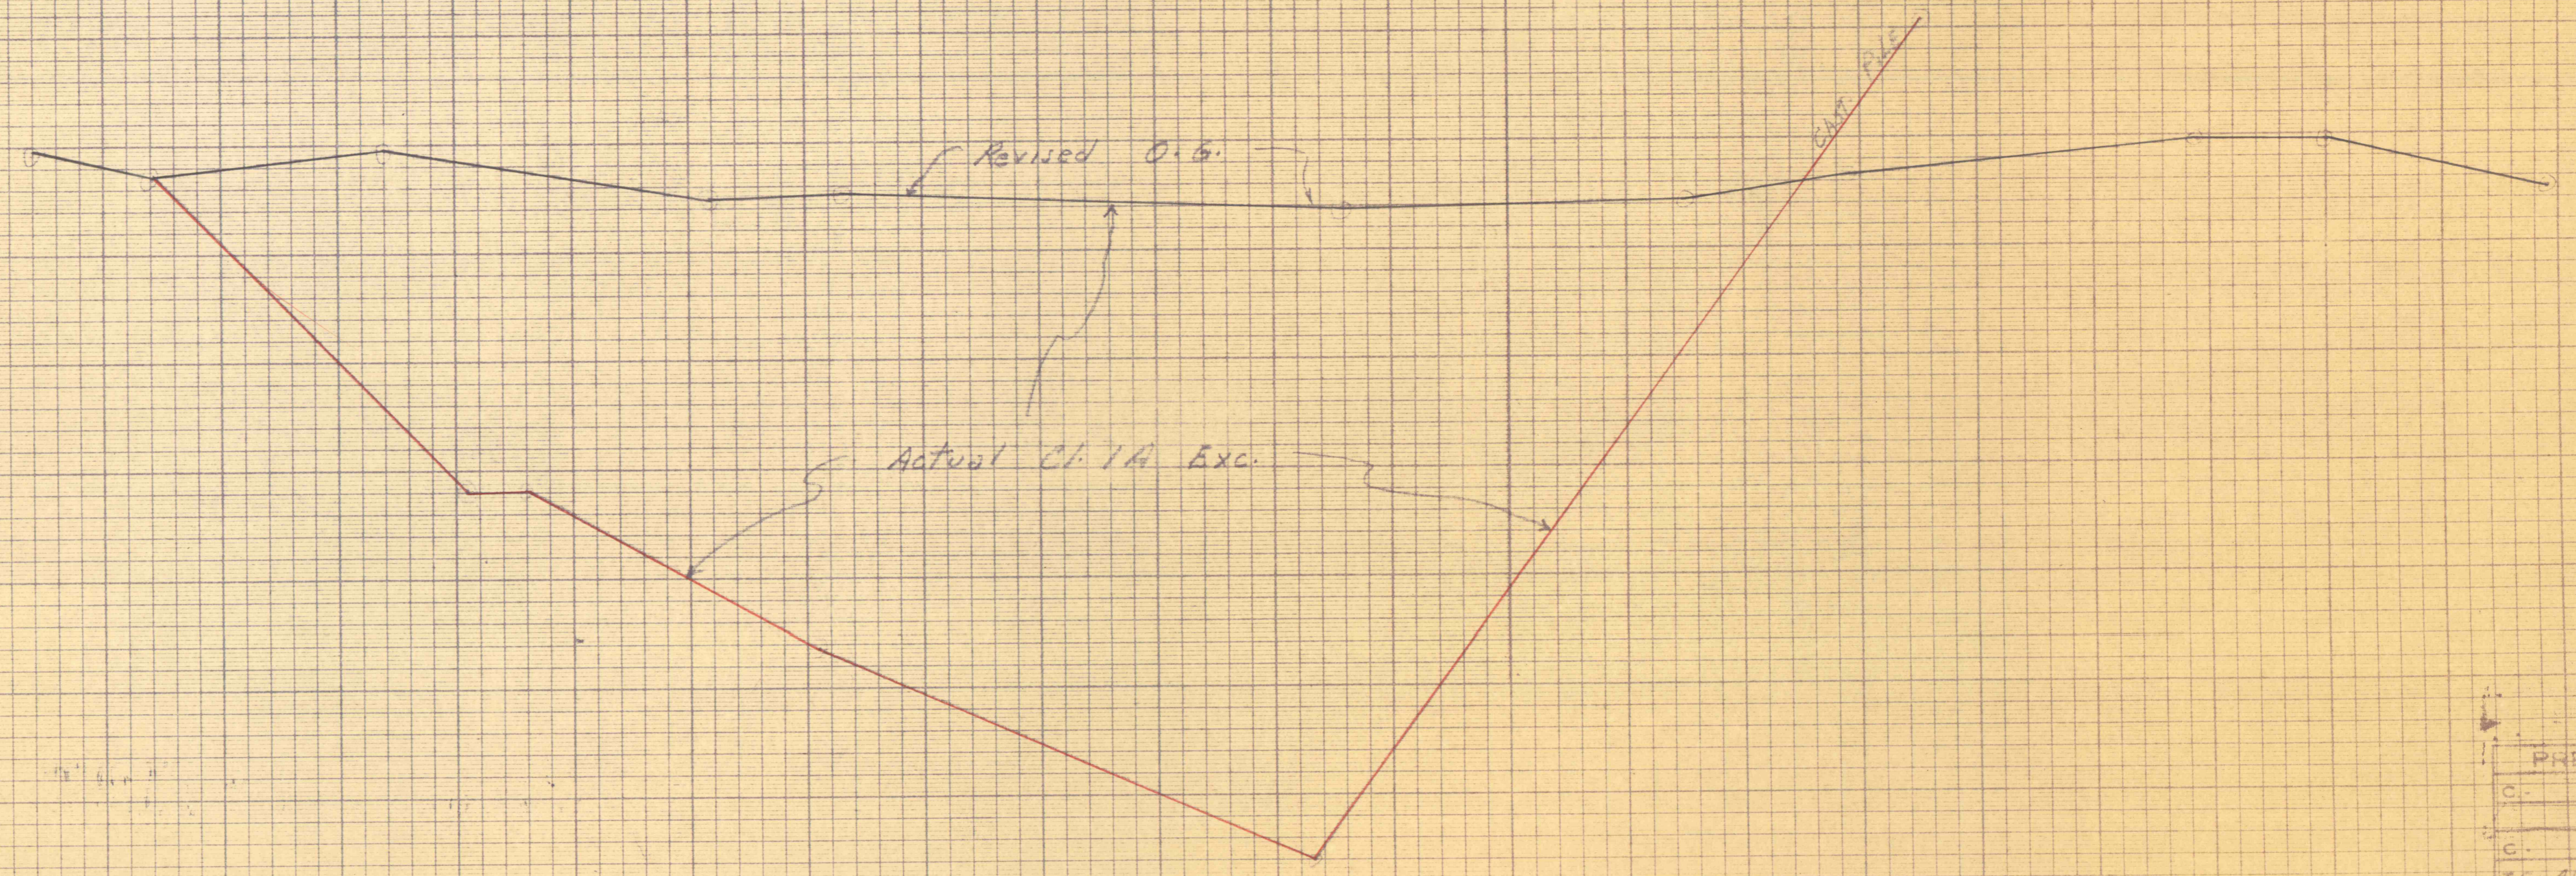

298150
850

PRELIMINARY	
C.	F.
FINA	
C.	F.
T.C. 4804 T.F. 4804	

Application No.
Date
Original Plans
Scale
Checked by
Contract No.
Area
Plans Prepared by
Scale
Checked by
Date

40 30 20 10 0 10 20 30 40 30 20 10 0 10 20 30 40

SCALE: 1/4 INCH = 5 FEET