

SCALE: 1 INCH = 10 FEET


PENNSYLVANIA TURNPIKE COMMISSION
CROSS SECTIONS

C.I.A. Exc.


District	County	Route	Secl.	Prelim. Book No.	Final Book No.	Sheet No.
				1373	1373	373

Cast P/c Moved
Ordered at U.S. Connaly, Dept. Secretary at Mines
July 3, 1956, to enclose old mine workings
1st of C.I.A. Exc.
24710-247150 RT

Typical Section

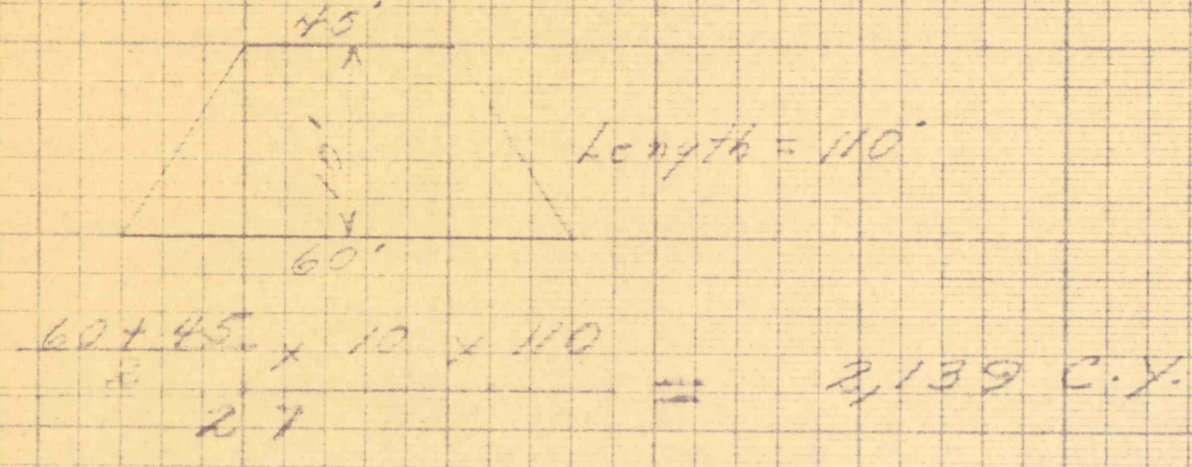


Sta. 247+45
End C.I.A. Exc.
Area = -0-

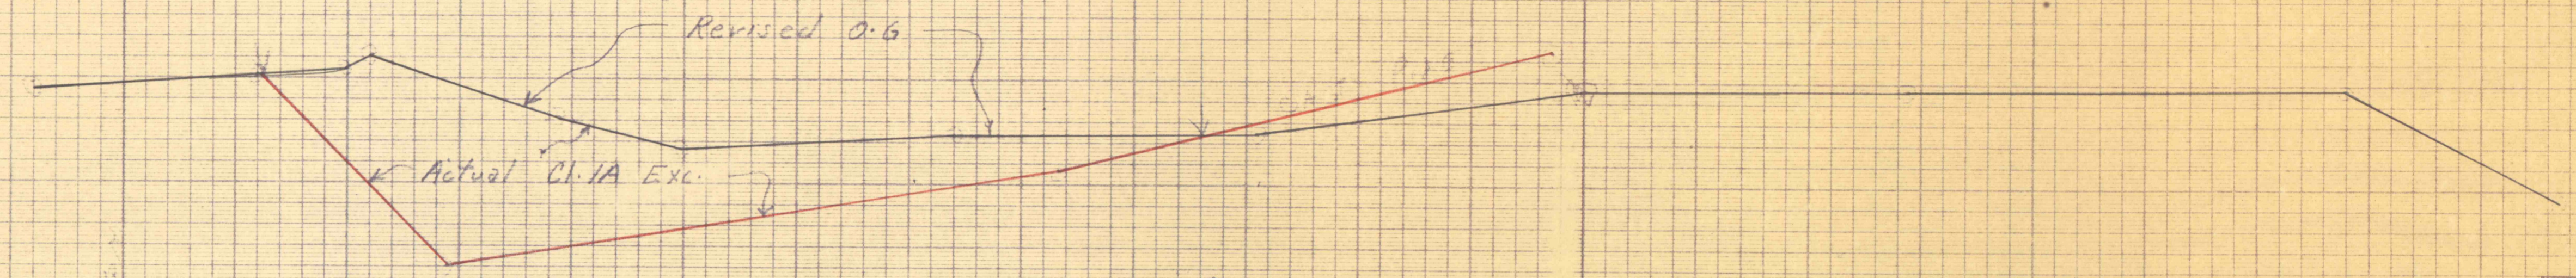

247+25
850

PRELIMINARY	
C-1	FI
C-2	TF
TC	650 TF 650

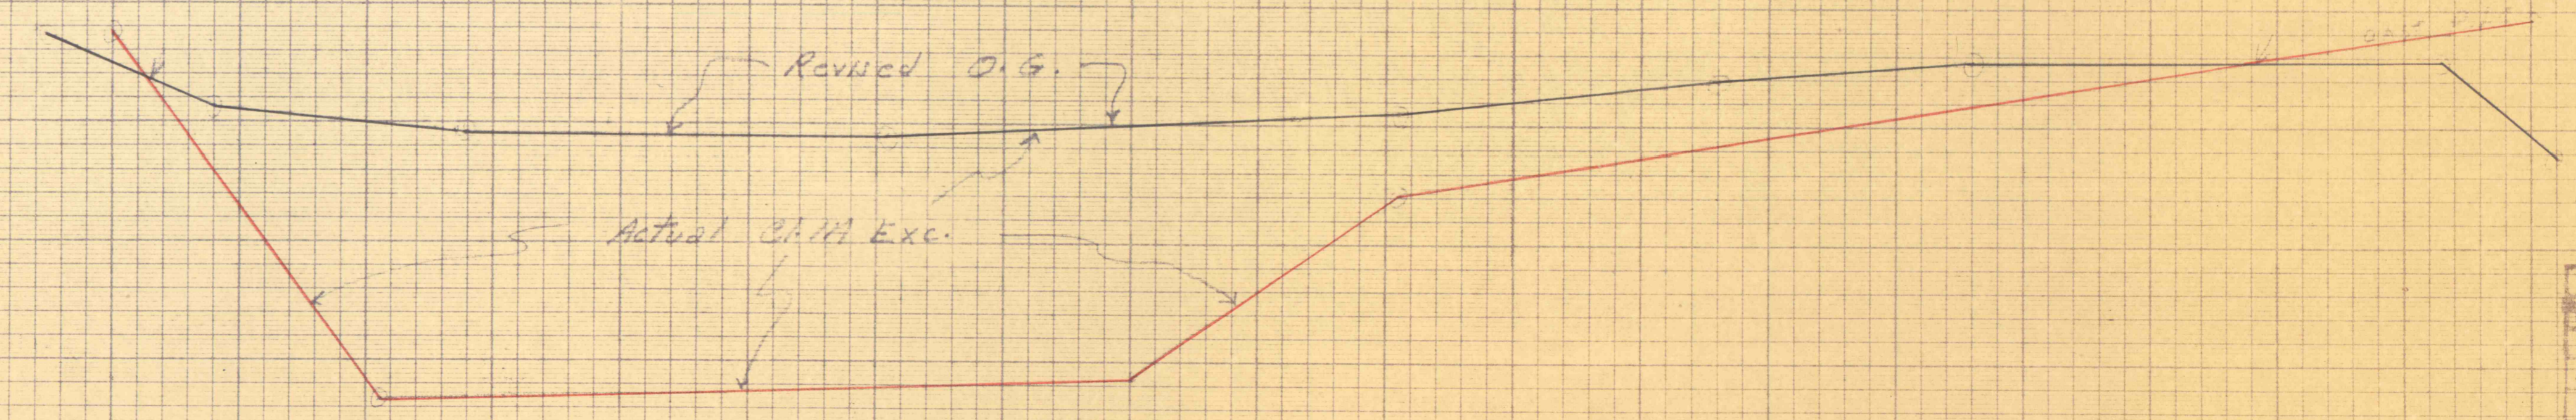

249+00
890

PRELIMINARY	
C-1	FI
C-2	TF
TC	2036 TF 2036

Application No.	
Route No.	
Original Entered by	
Checked by	
Drawn by	
Field Checked by	
Checked by	
Approved by	

SCALE: 1 INCH = 5 FEET