

SCALE: 1 INCH = 10 FEET


PENNSYLVANIA
TURNPIKE COMMISSION
CROSS SECTIONS

District	County	Route	Sect.	Prelim. Book No.	Final Book No.	Sheet No.
18	Lackawanna	37K	537-P-160			1 of 3

80 70 60 50 40 30 20 10 0 10 20 30 40 50 60 70 80

KEY:
 P.T.C. Template
 Cl. 1A Excavation
 Cl. 1A Excavation Backfill

CLASS 1A EXCAVATION

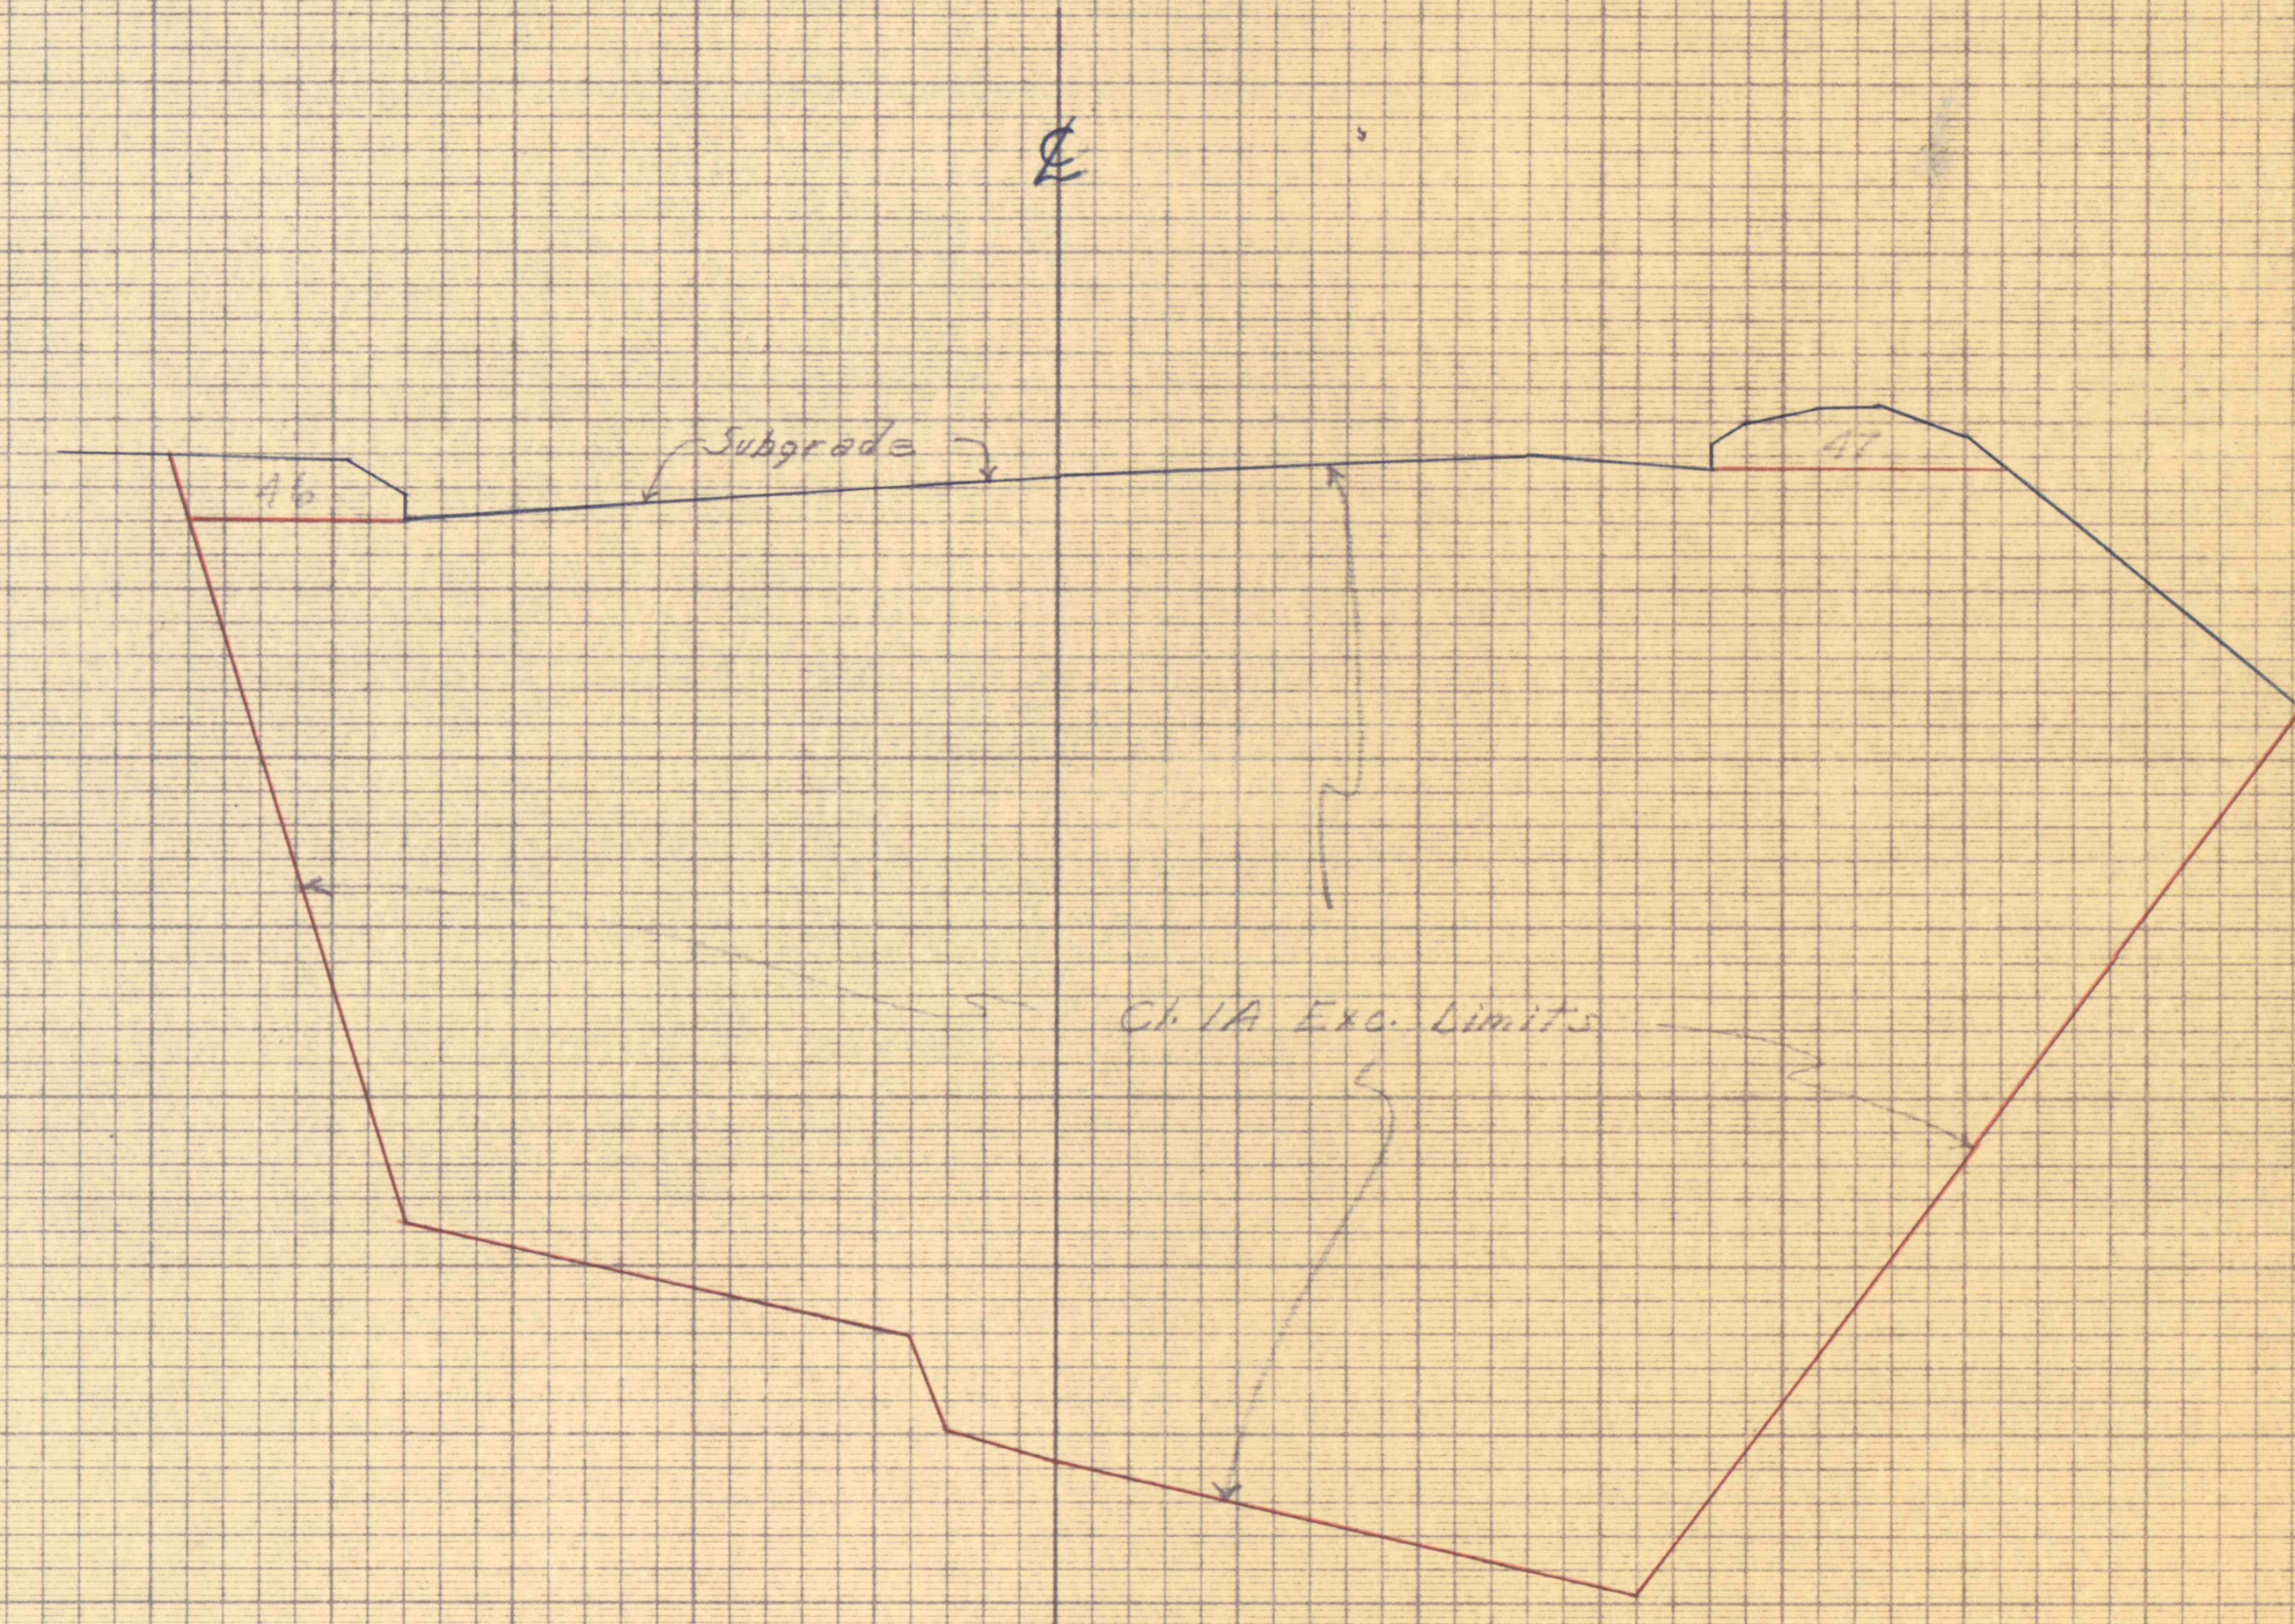

276+50
930

5368 3368

276+10
990

Begin Cl. 1A Excavation
Station 276+10 Area = -0-

Appropriation No. _____
 Route No. _____
 Original Plotted by _____
 Checked by _____
 Template by _____
 Area by _____
 Final Plotted by _____
 Checked by _____
 Area by _____
 Checked by _____

40 30 20 10 0 10 20 30 40 50 60 70 80
SCALE: 1 INCH = 5 FEET