


SCALE: 1 INCH = 10 FEET

PENNSYLVANIA TURNPIKE COMMISSION CROSS SECTIONS

CLASS 1A EXCAV

District	County	Route	Sec.	Prelim. Book No.	Final Book No.	Sheet No.
18	Lackawanna			37K	537-P-160	

80 70 60 50 40 30 20 10 0 10 20 30 40 50 60 70 80

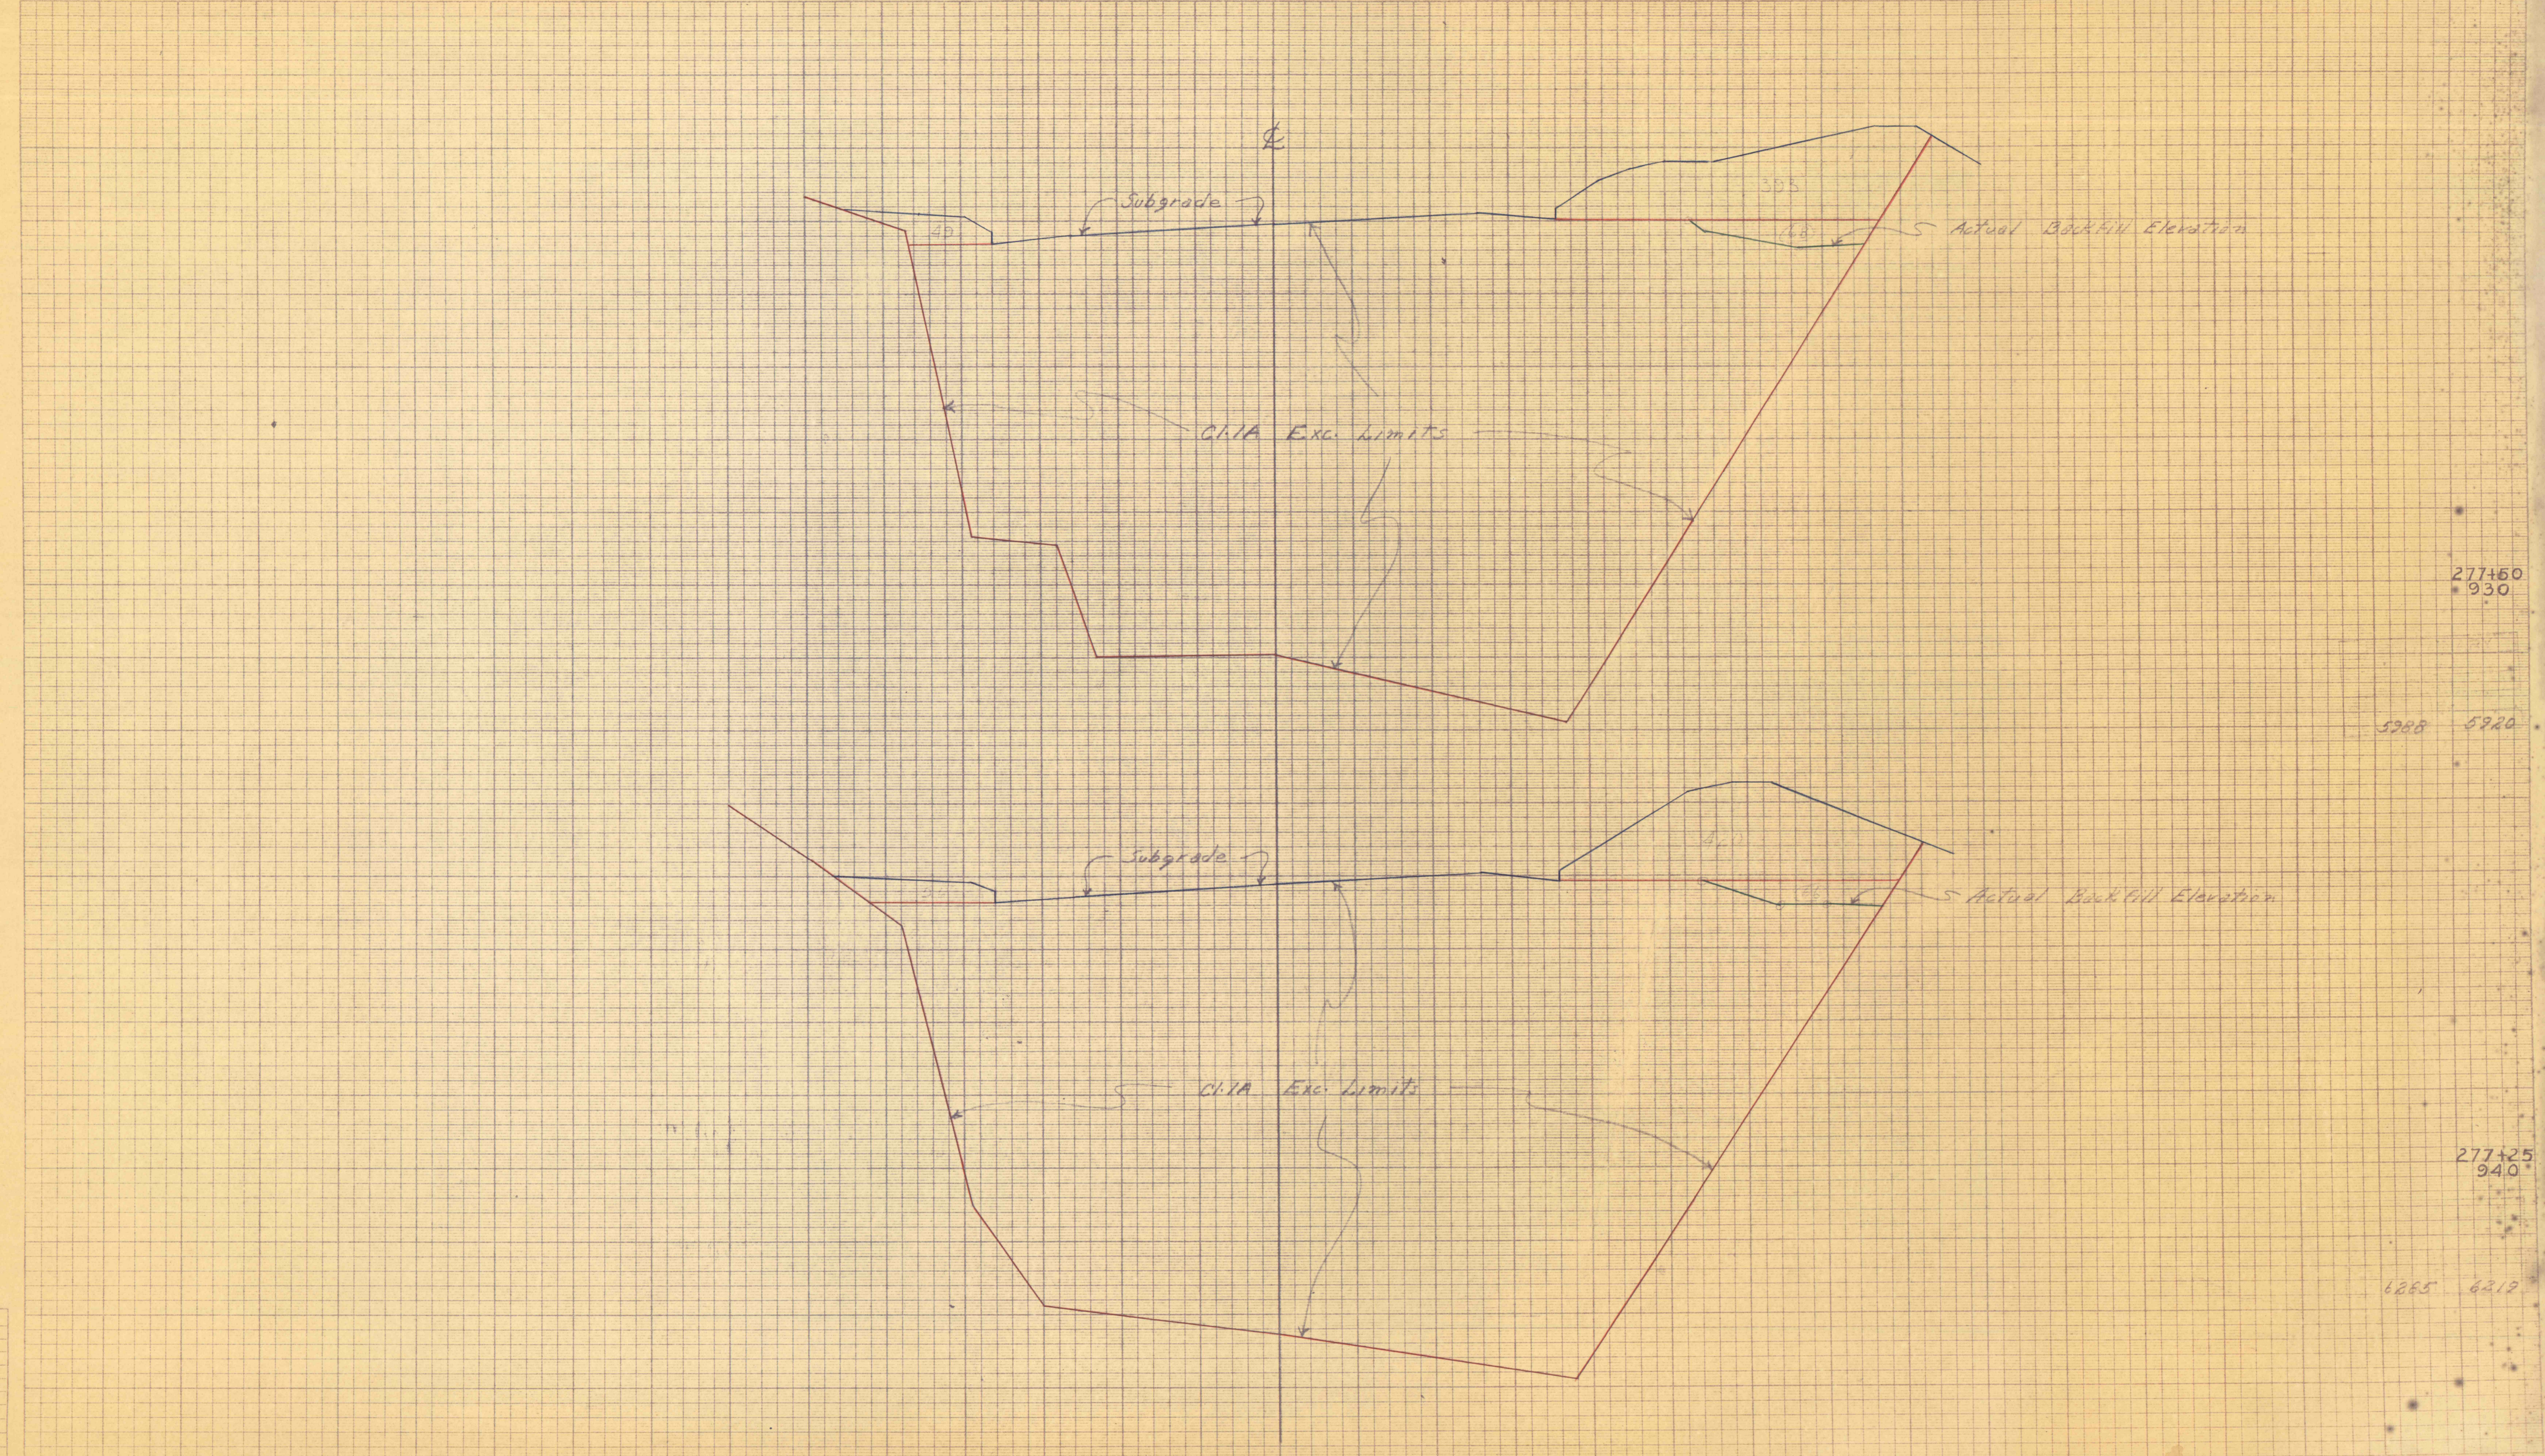

277+60
930

5908 5920

277+25
940

6265 6272

SCALE: 1 INCH = 5 FEET

40 30 20 10 0 10 20 30 40 50 60 70 80

Application No. _____
 Route No. _____
 Original Plotted by LJI
 Checked by _____
 Template by _____
 Area by LJI
 Totals Plotted by _____
 Checked by _____
 Area by LJI
 Checked by _____