


SCALE: 1 INCH = 10 FEET

PENNSYLVANIA
TURNPIKE COMMISSION
CROSS SECTIONS

District	County	Route	Sect.	Prelim. Book No.	Final Book No.	Sheet No.
18	Lacawanna			31K 537-P/60		

80 70 60 50 40 30 20 10 0 10 20 30 40 50 60 70 80

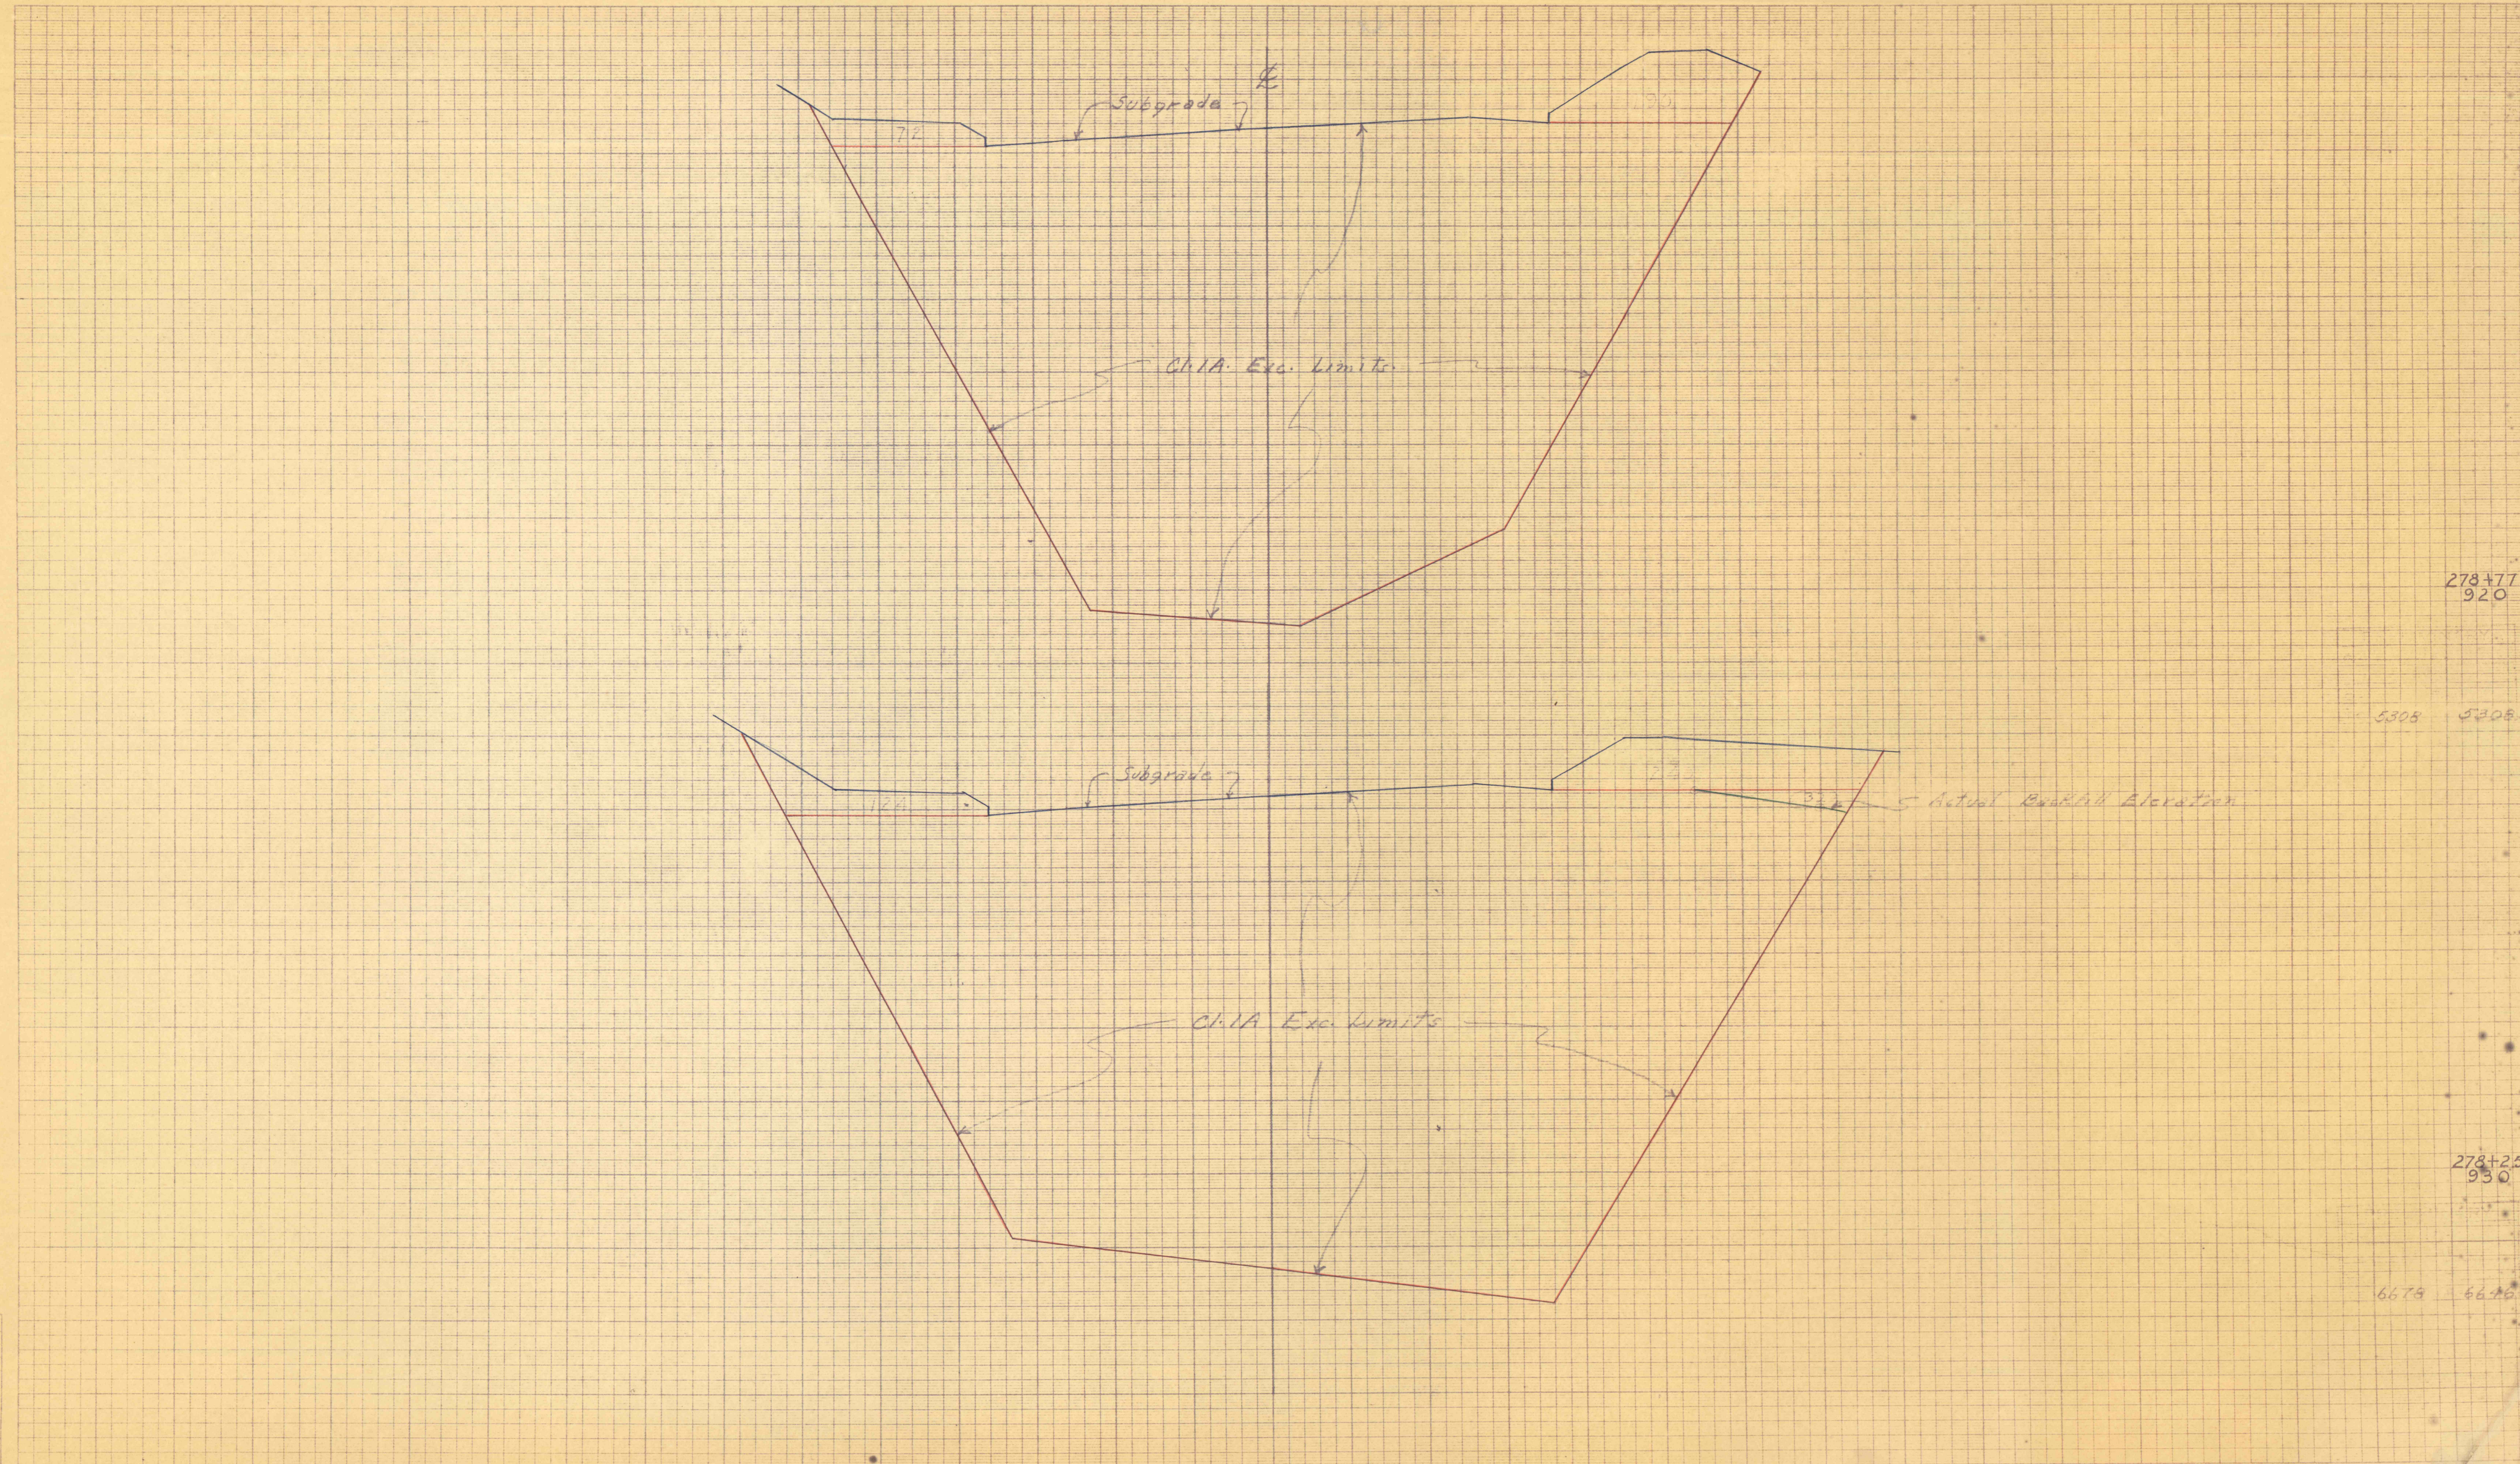

278+77
920

5308 5308

278+25
930

6678 6678

Acquisition No. _____
 Route No. _____
 Original Plotted by LJI
 Checked by _____
 Template by LJI
 Area by _____
 Final Plotted by _____
 Checked by _____
 Area by LJI
 Checked by _____

40 30 20 10 0 10 20 30 40 30 20 10 0 10 20 30 40

SCALE: 1 INCH = 5 FEET