


SCALE: 1 INCH = 10 FEET

PENNSYLVANIA  
TURNPIKE COMMISSION  
CROSS SECTIONS


District	County	Route	Sec.	Prelim. Book No.	Final Book No.	Sheet No.
18	Lackawanna	37K	537-P-160			2 of 5

80 70 60 50 40 30 20 10 0 10 20 30 40 50 60 70 80

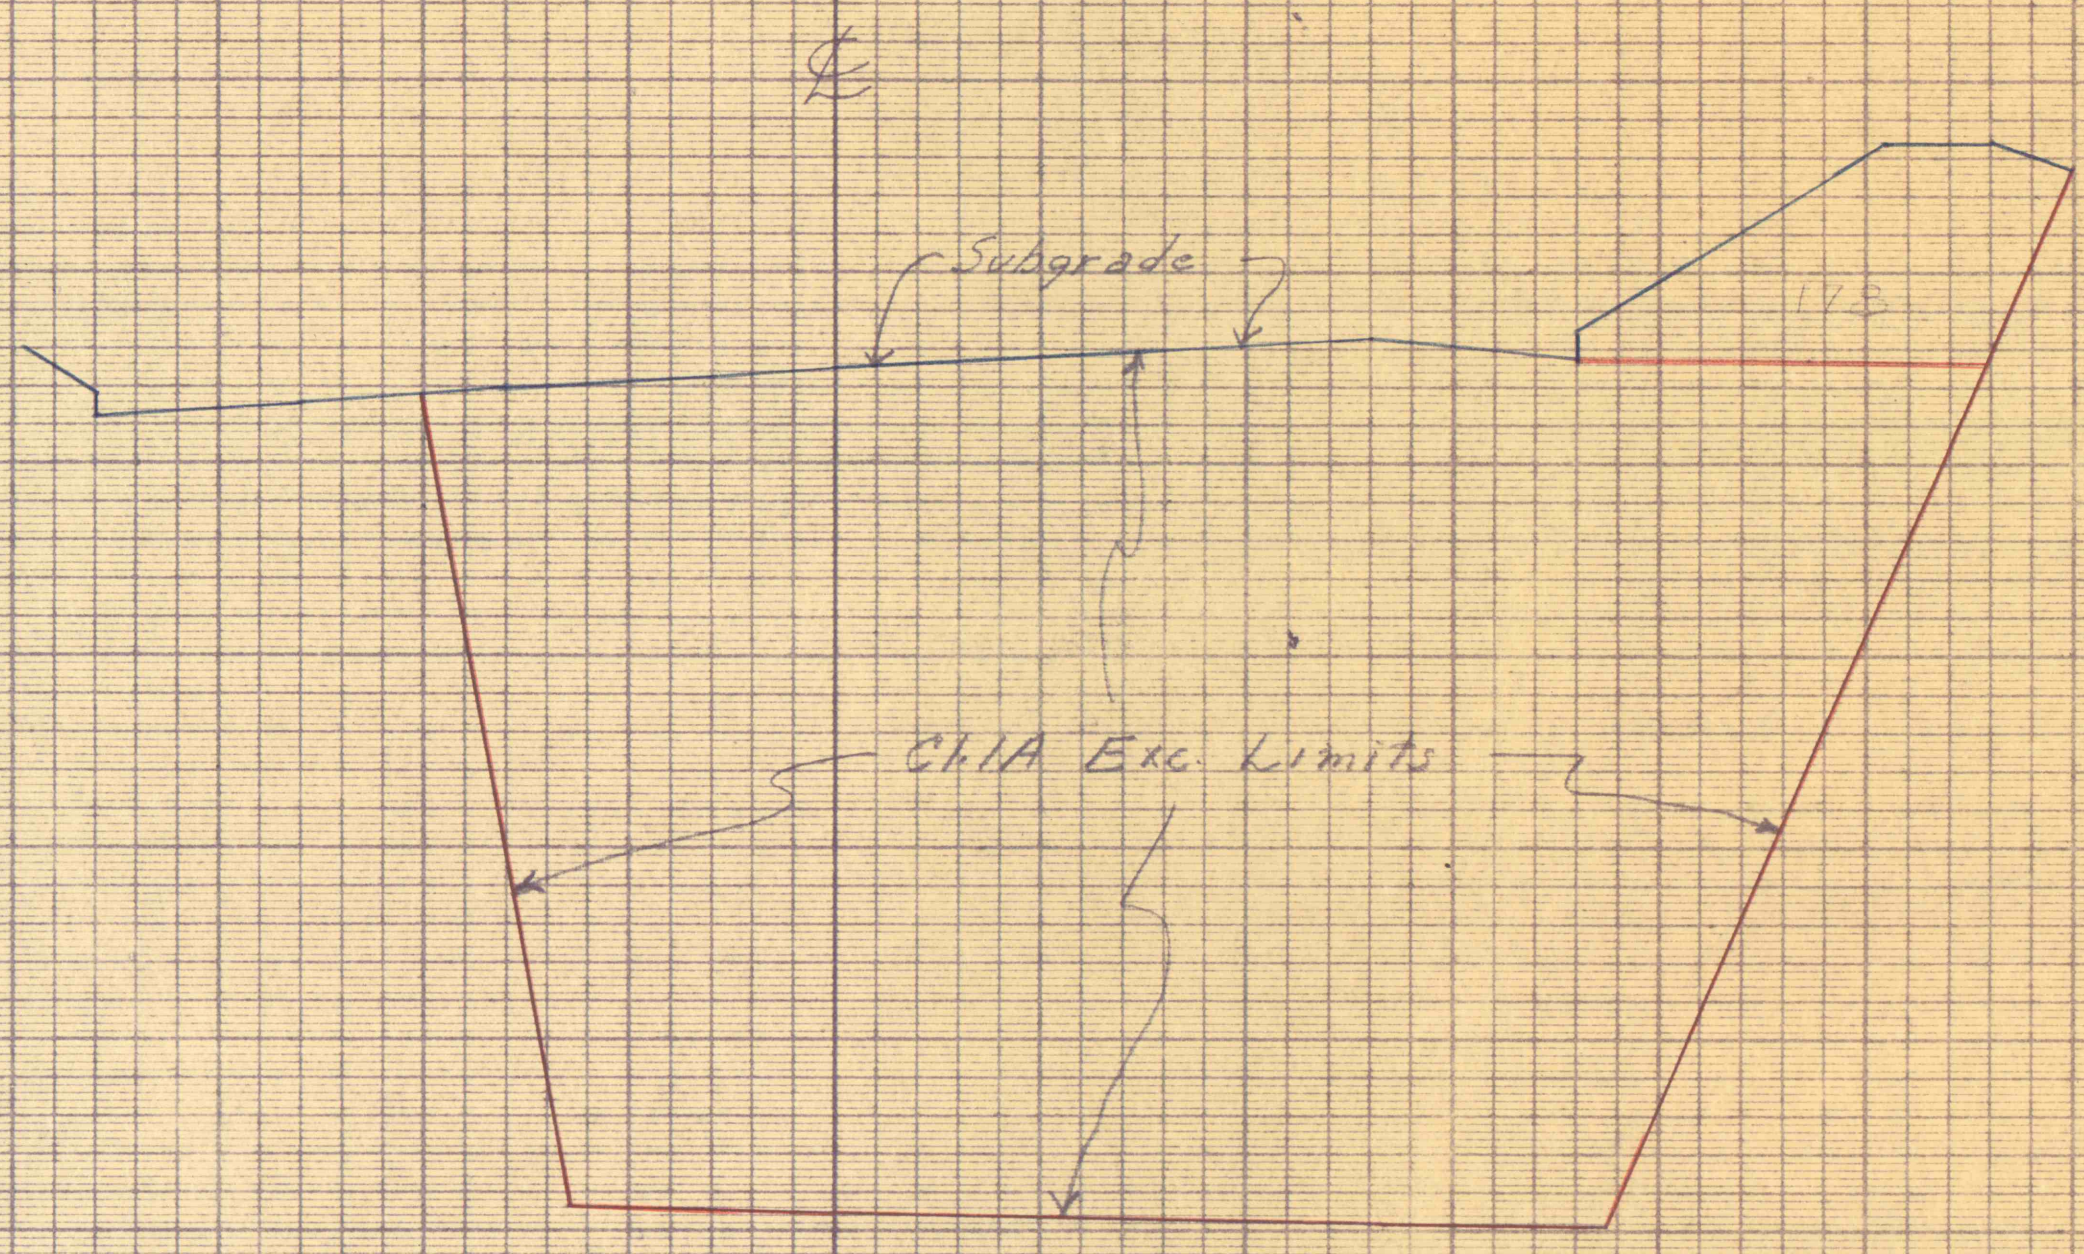

279+28  
940

2827 2827

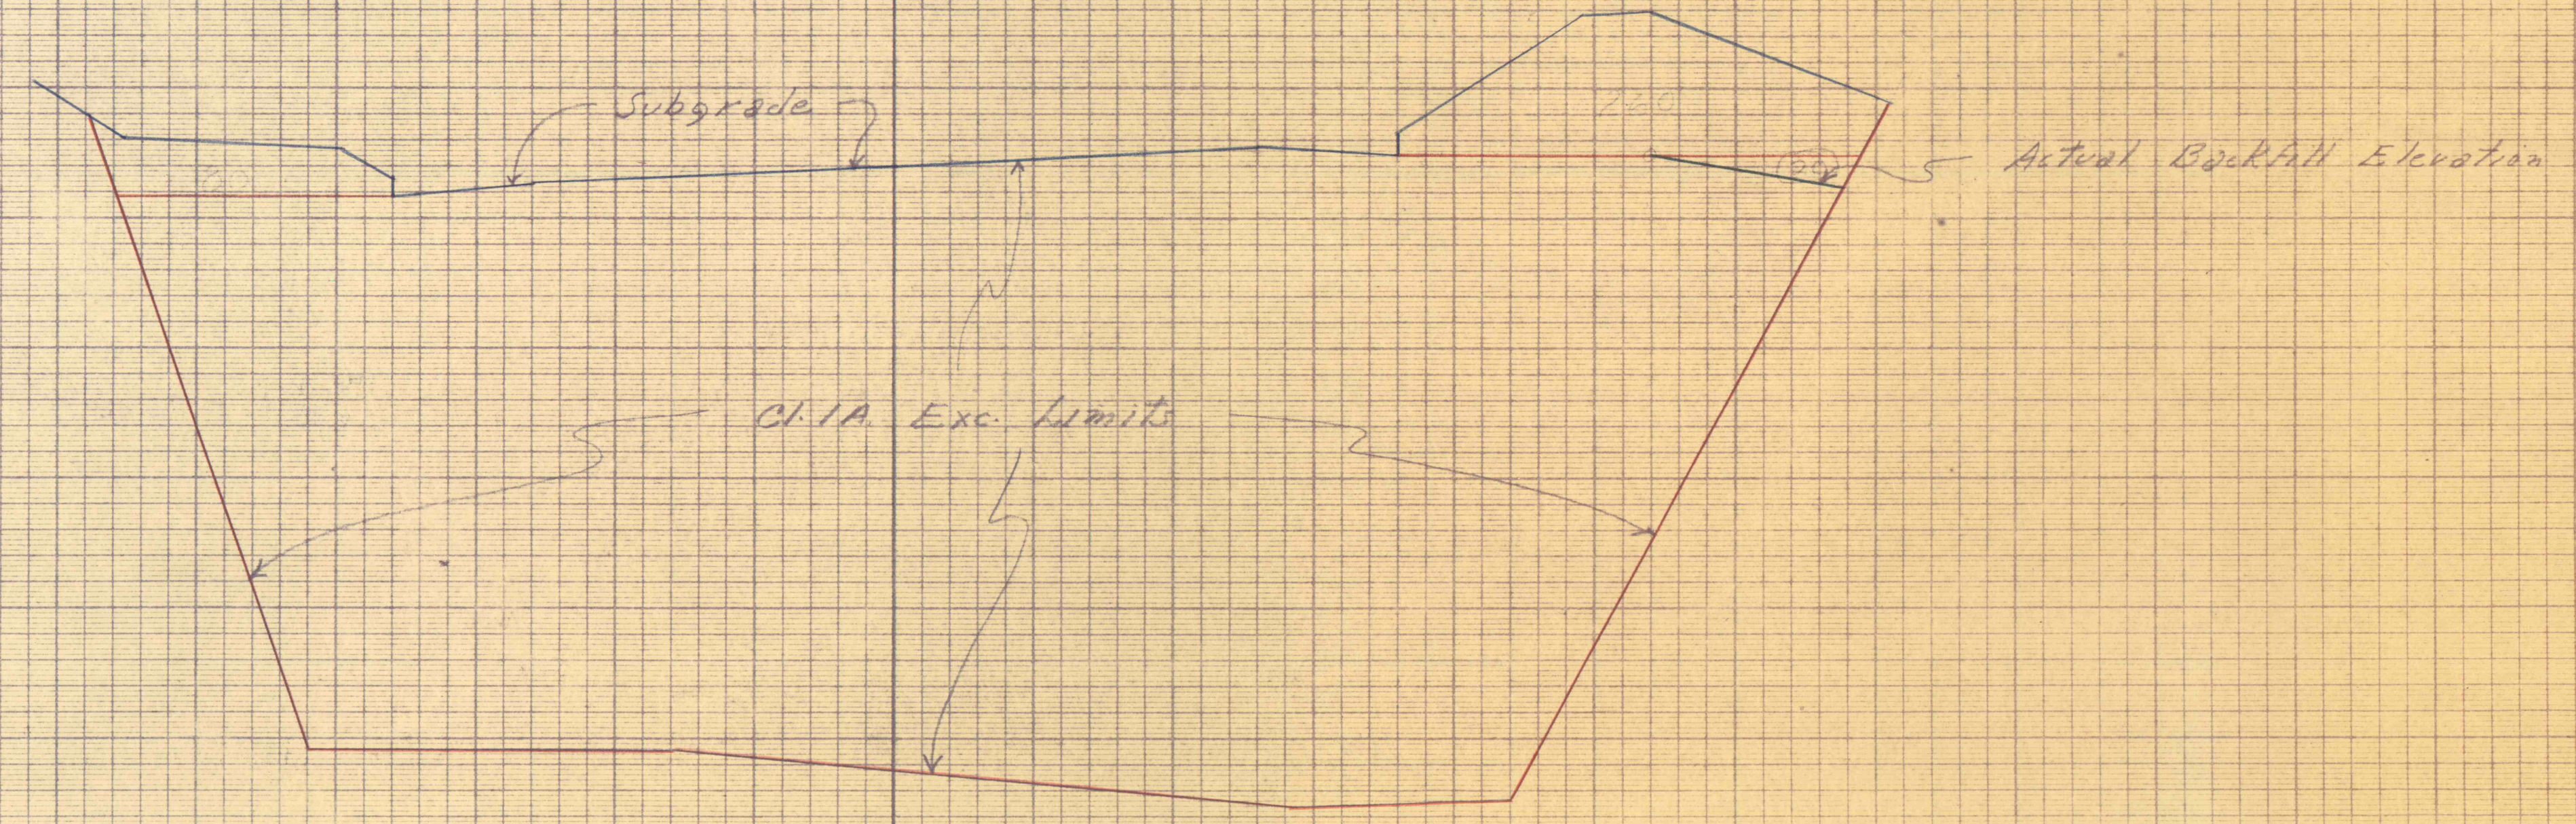

279+02.5  
950

4876 4876

Aspiration No.  
Route No.  
Original Plotted by LJI  
Checked by  
Template by LJI  
Area by  
Final Plotted by  
Checked by  
Area by LJI  
Checked by

40 30 20 10 0 10 20 30 40 30 20 10 10 20 30 40

SCALE: 1 INCH = 5 FEET