



80 70 60 50 40 30 20 10 0 10 20 30 40 50 60 70 80

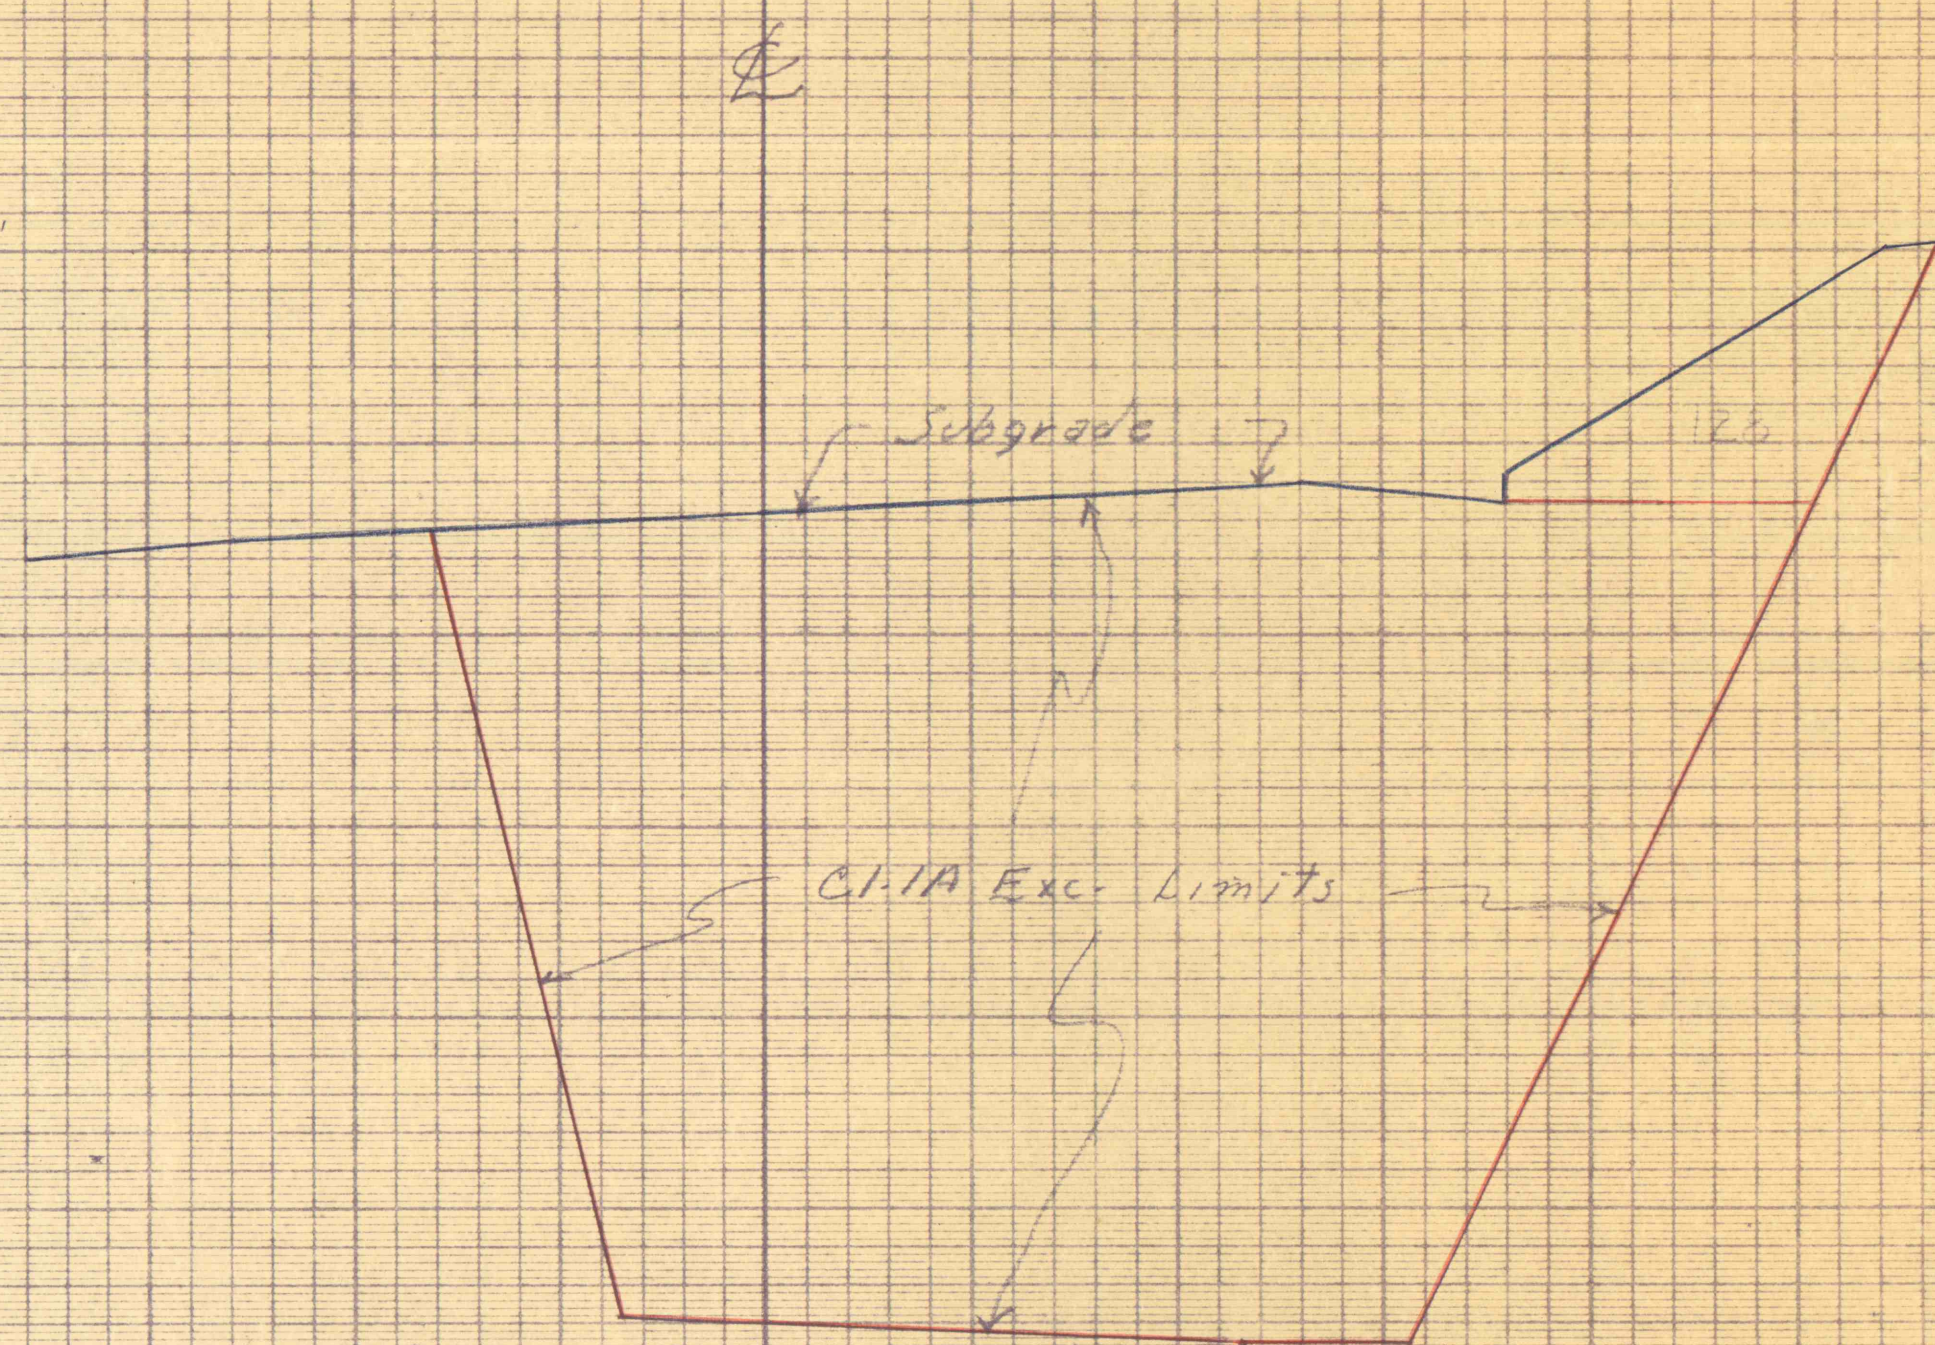

279+79
940

2625 2625

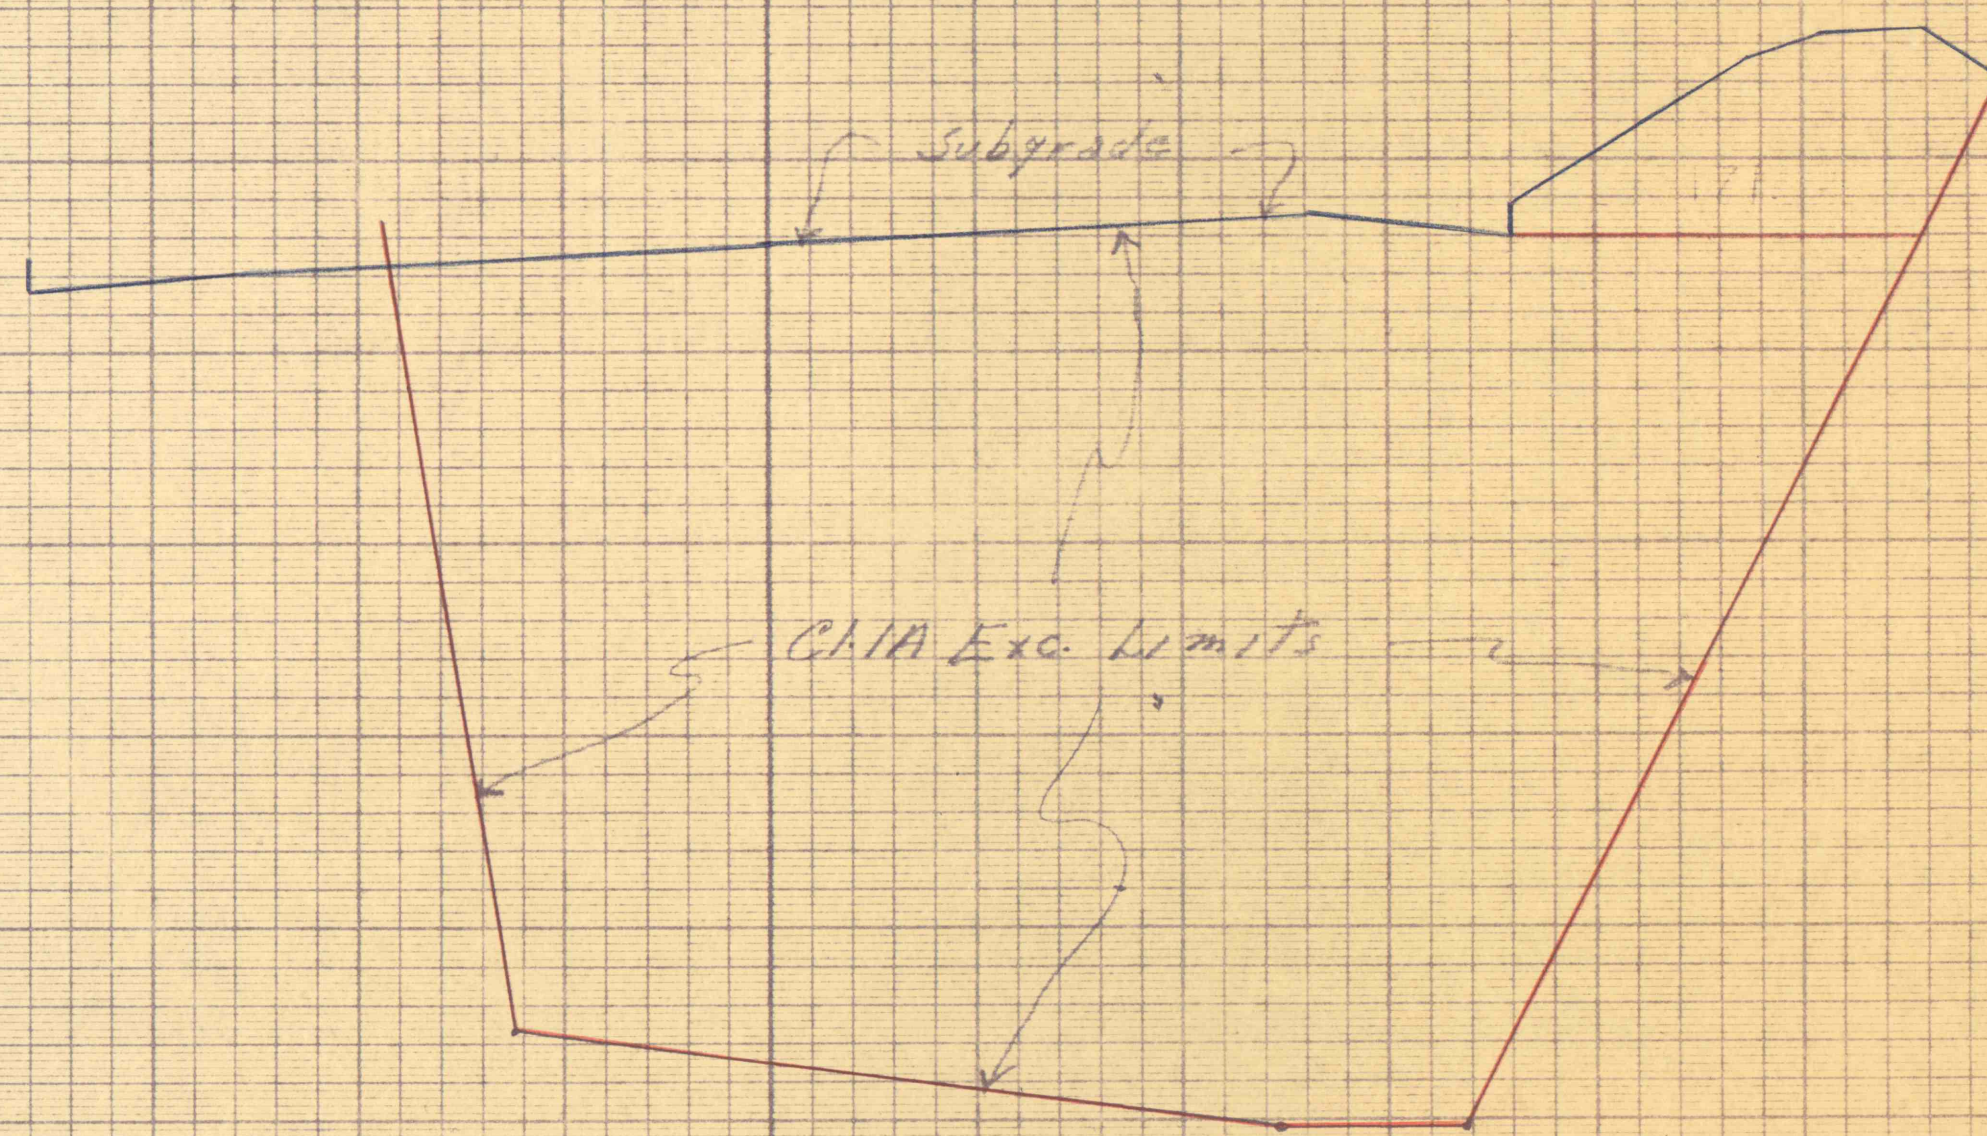

279+53.5
950

2672 2672

Application No. _____
 Route No. _____
 Original Plotted by LJI
 Checked by _____
 Template by LJI
 Area by _____
 Final Plotted by _____
 Checked by _____
 Area by LJI
 Checked by _____

40 30 20 10 0 10 20 30 40 50 60 70 80