


SCALE: 1 INCH = 10 FEET

PENNSYLVANIA
TURNPIKE COMMISSION
CROSS SECTIONS

District	County	Route	Sect	Prelim. Book No.	Final Book No.	Sheet No.
18	Lackawanna	37K		537-P-160		


80 70 60 50 40 30 20 10 0 10 20 30 40 50 60 70 80

End Class 1A Excav.
Sta. 280+80.18
Area = -0-

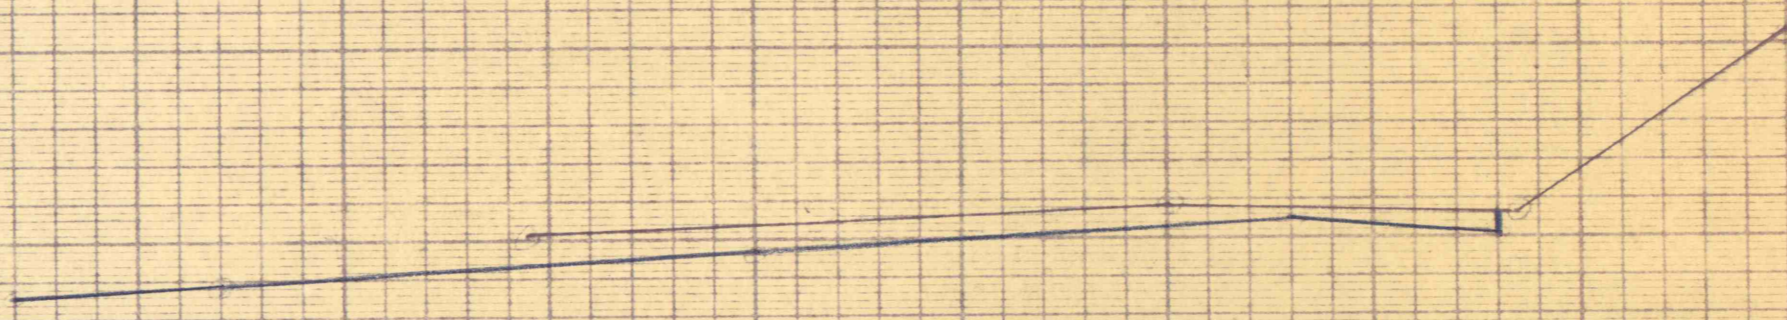

280+80.18
99.0

-0- -0-

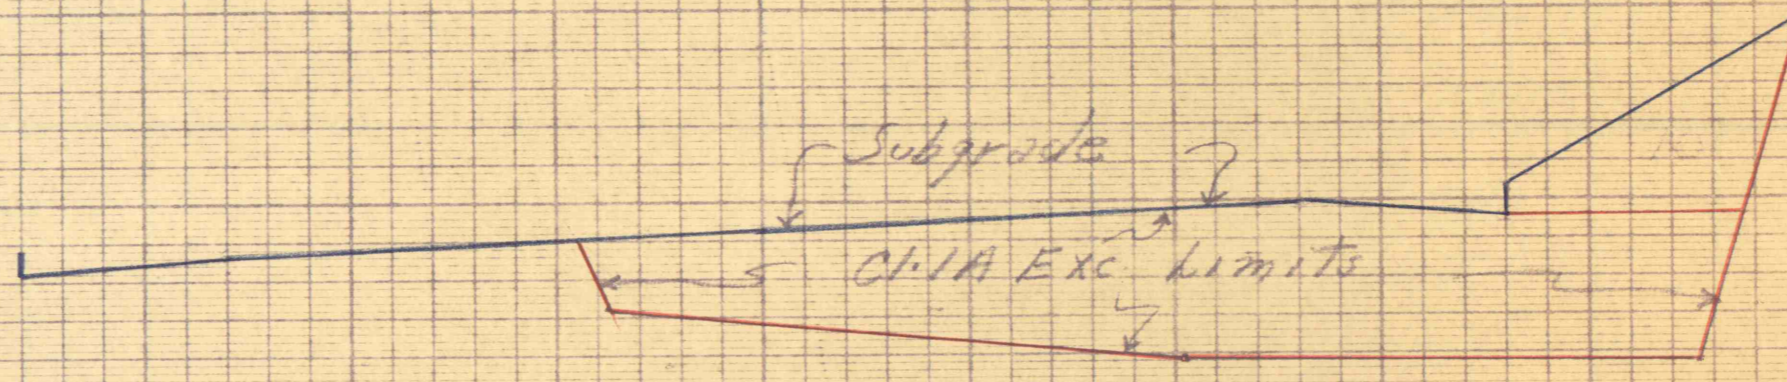

280+55
98.0

268 268

Application No. _____
 Route No. _____
 Original Plotted by **LJI**
 Checked by _____
 Template by **LJI**
 Area by _____
 Final Plotted by _____
 Checked by _____
 Area by **LJI**
 Checked by _____

40 30 20 10 0 10 20 30 40 30 20 10 0 10 20 30 40

SCALE: 1 INCH = 5 FEET