


KEY:
 Revised Original Ground _____
 P.T.C. Template _____
 Cl. 1A Excavation _____
 Additional Cl. 1 Excavation _____
 Top of Fill & Cl. 1A Exc. Backfill _____

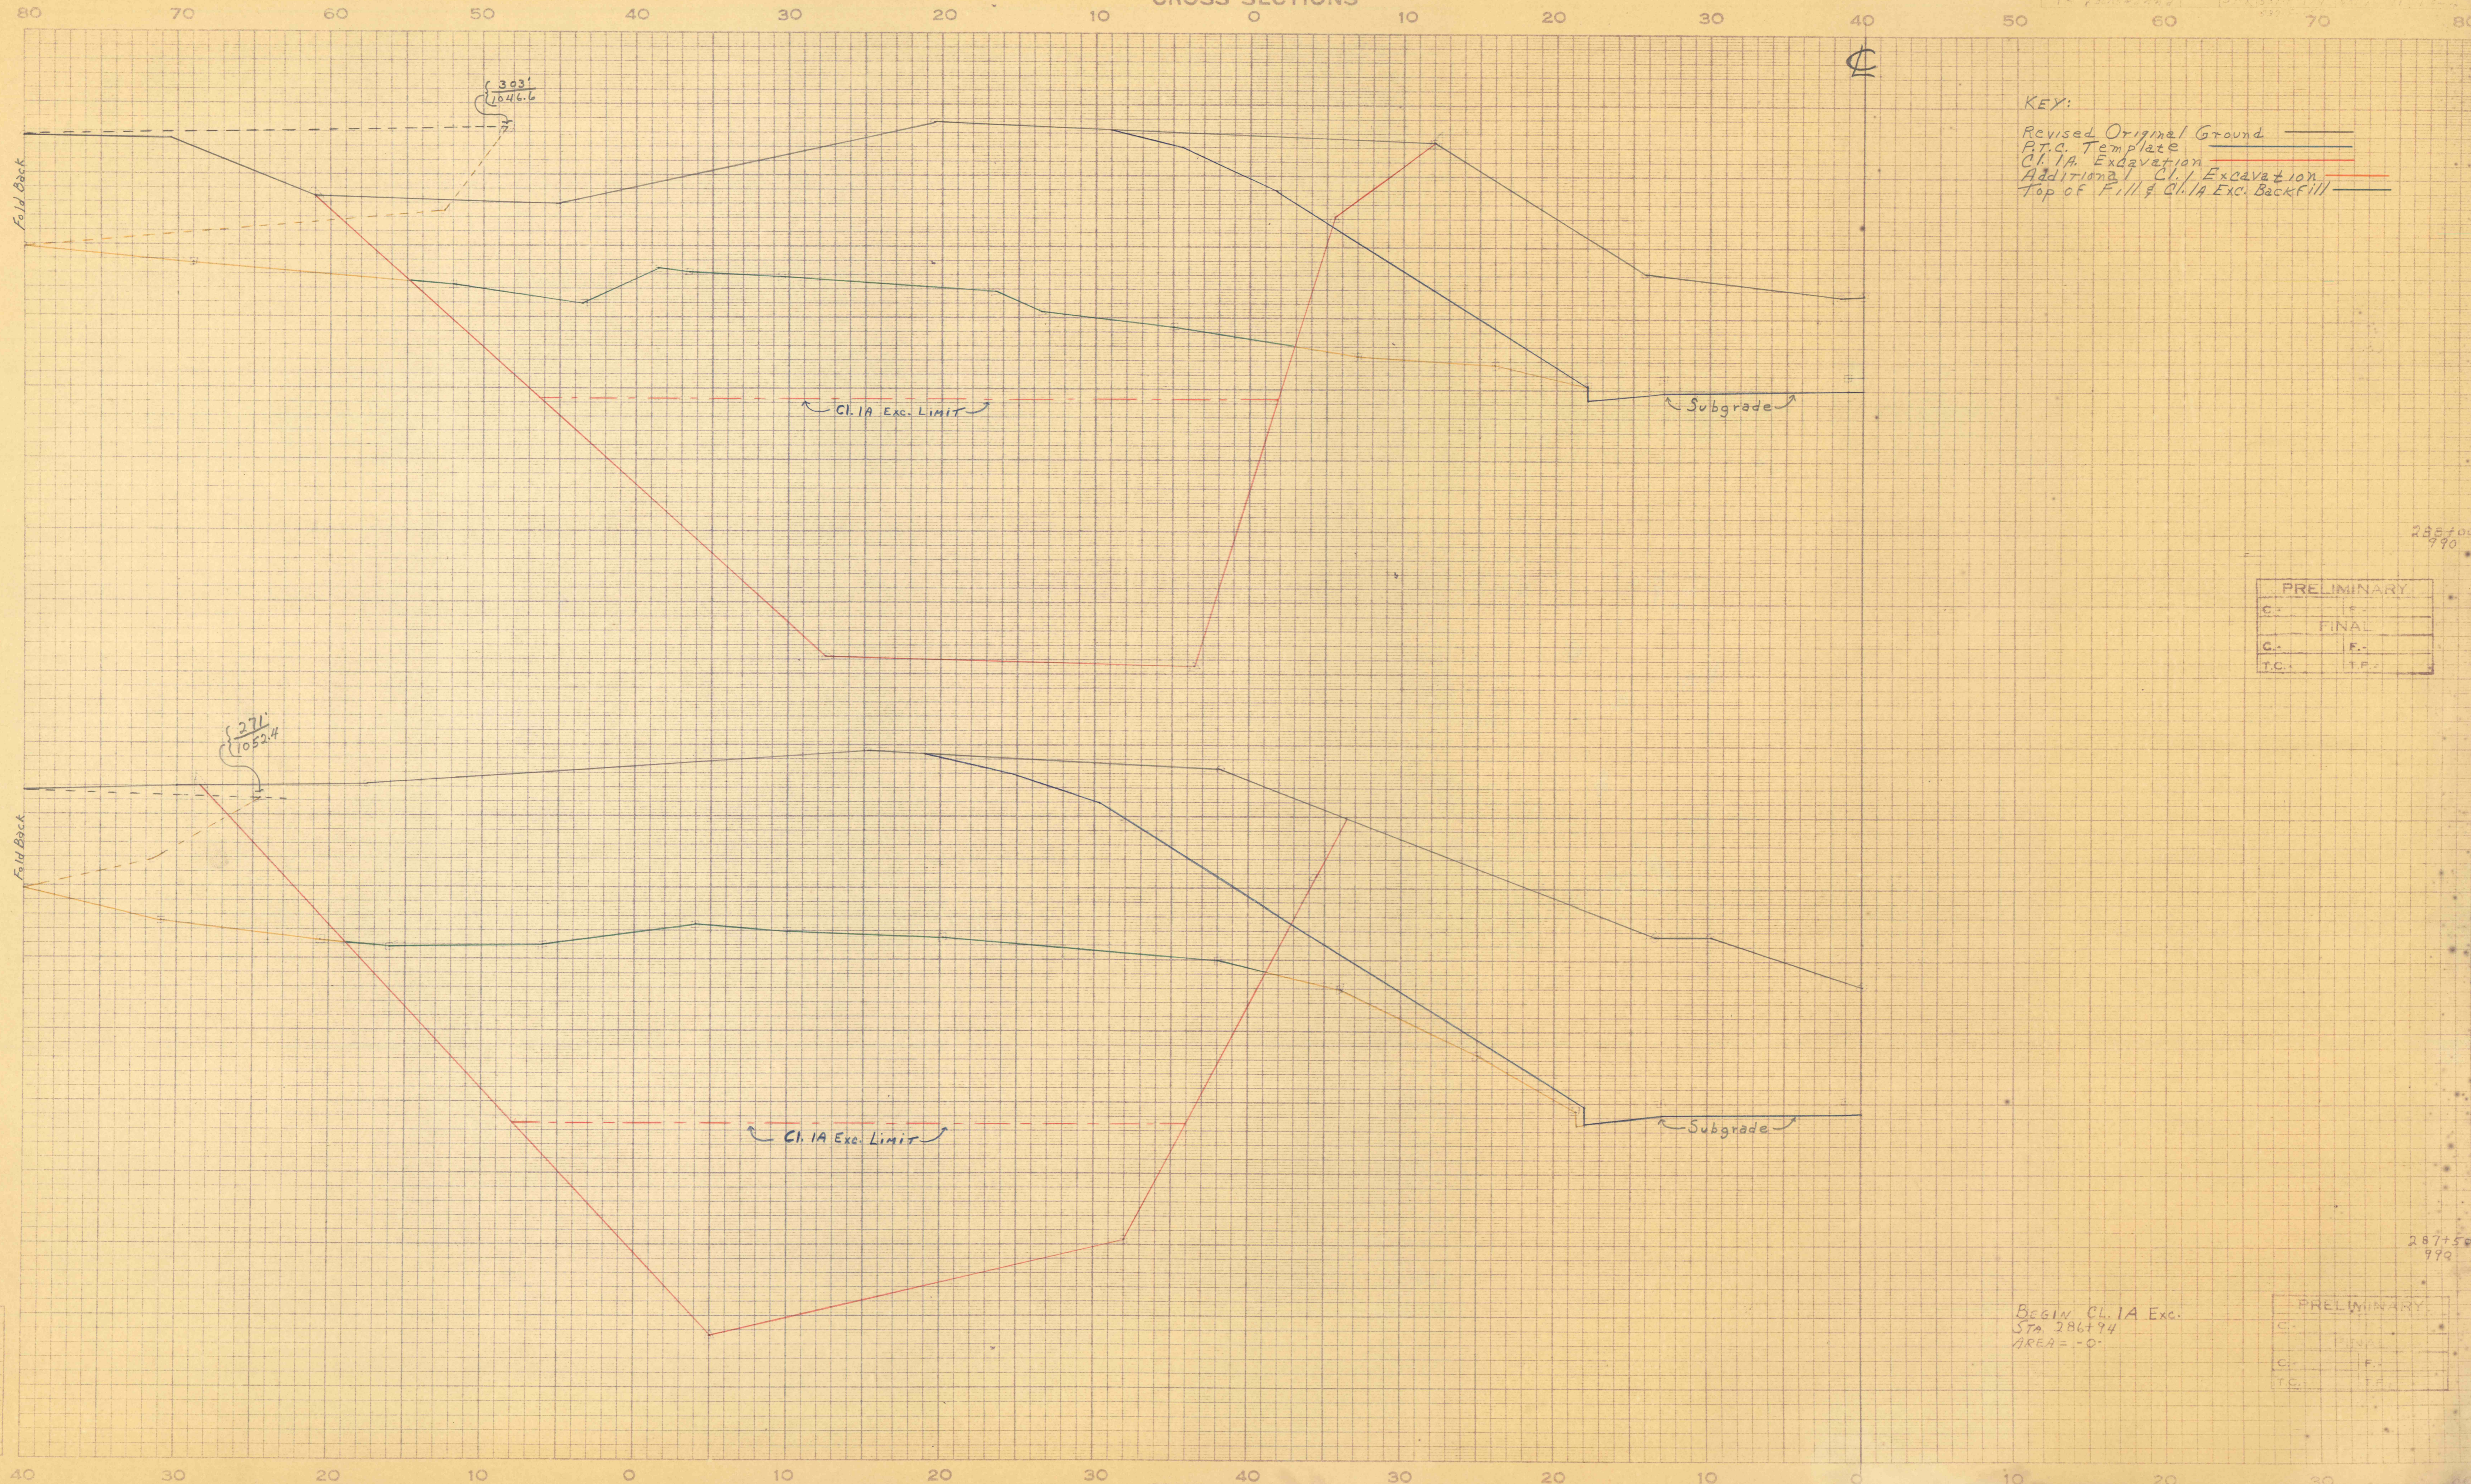

PRELIMINARY	
C.	F.
FINAL	
C.	F.
T.C.	T.F.

PRELIMINARY	
C.	F.
FINAL	
C.	F.
T.C.	T.F.

BEGIN CL. 1A Exc.
 STA 286+94
 AREA = -0-

Application No. _____
 Route No. _____
 Original Plan by _____
 Checked by _____
 Designer by _____
 Area by _____
 Plans Plotted by _____
 Checked by _____
 Area by _____
 Checked by _____