FORM No. PTC 1113

PENNSYLVANIA
TURNPIKE COMMISSION
CROSS SECTIONS

SCALE: 1 INCH = 10 FEET

CL 1A EXCAVATION

District	County	Route	Sect.	Prelim. Book No.	Final Book No.	Sheet No.
18	Lackawanna		37-K	537-P-154	637-F-131	2 of 4

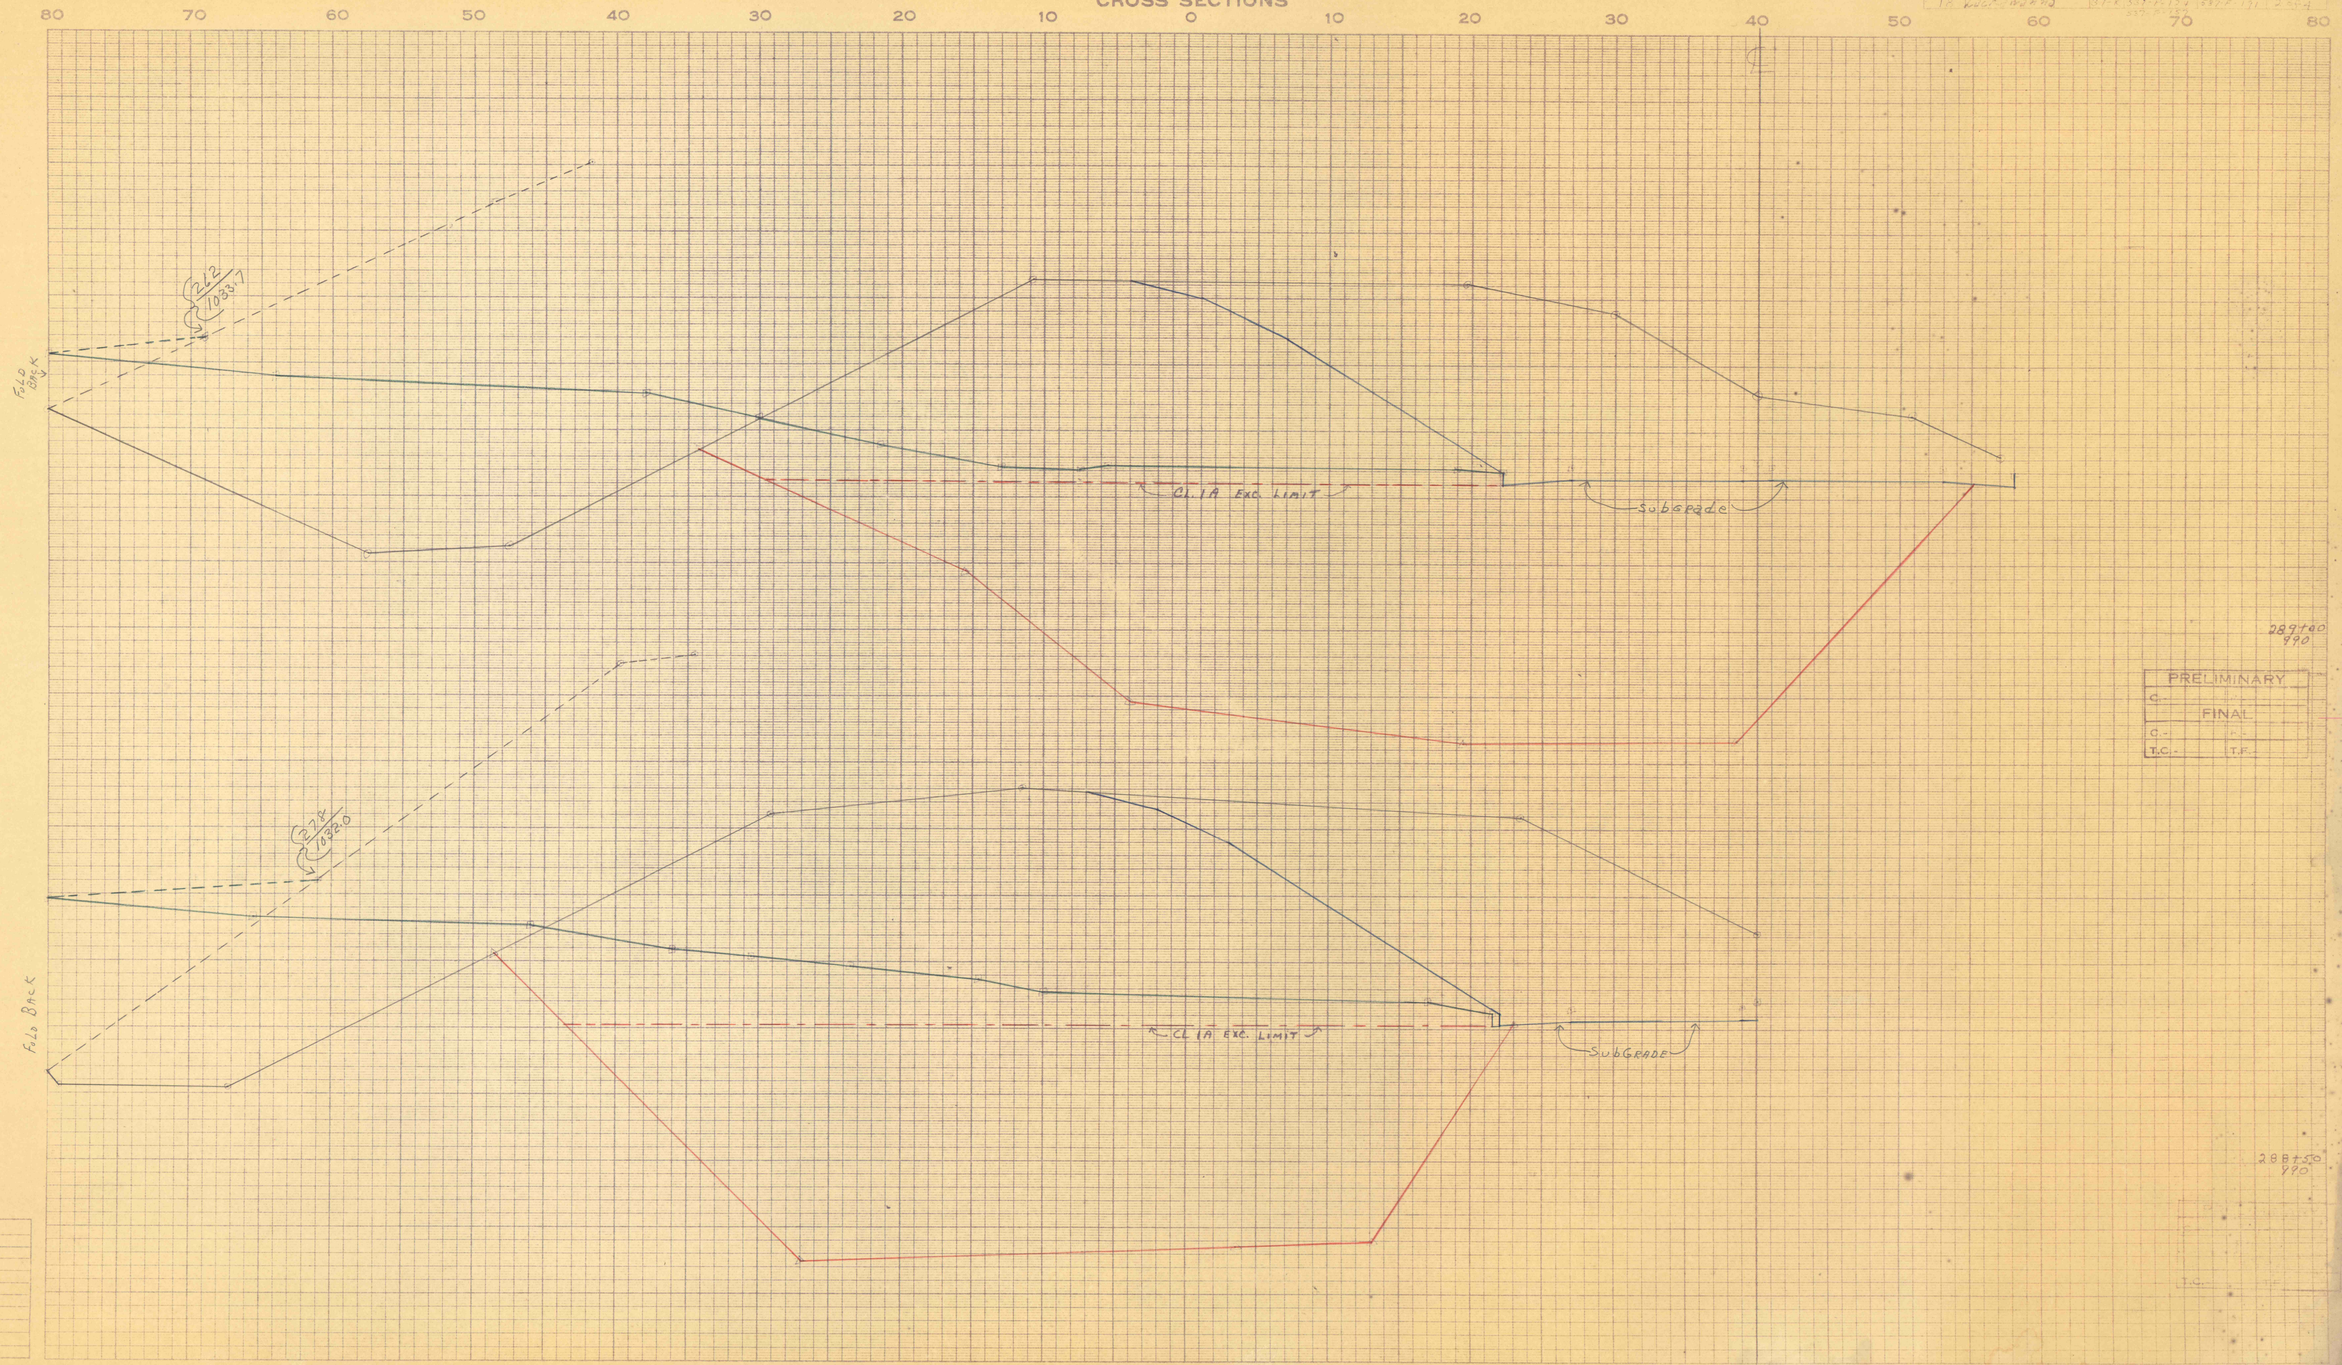

SCALE: 1 INCH = 5 FEET

PRELIMINARY
C.-
FINAL
C.-
T.C.- T.F.-

Application No.
Route No.
Original Platted by
" Checked by
Template by
Area by
Finals Platted by
" Checked by
Area by
" Checked by