


1/8" PLAN.

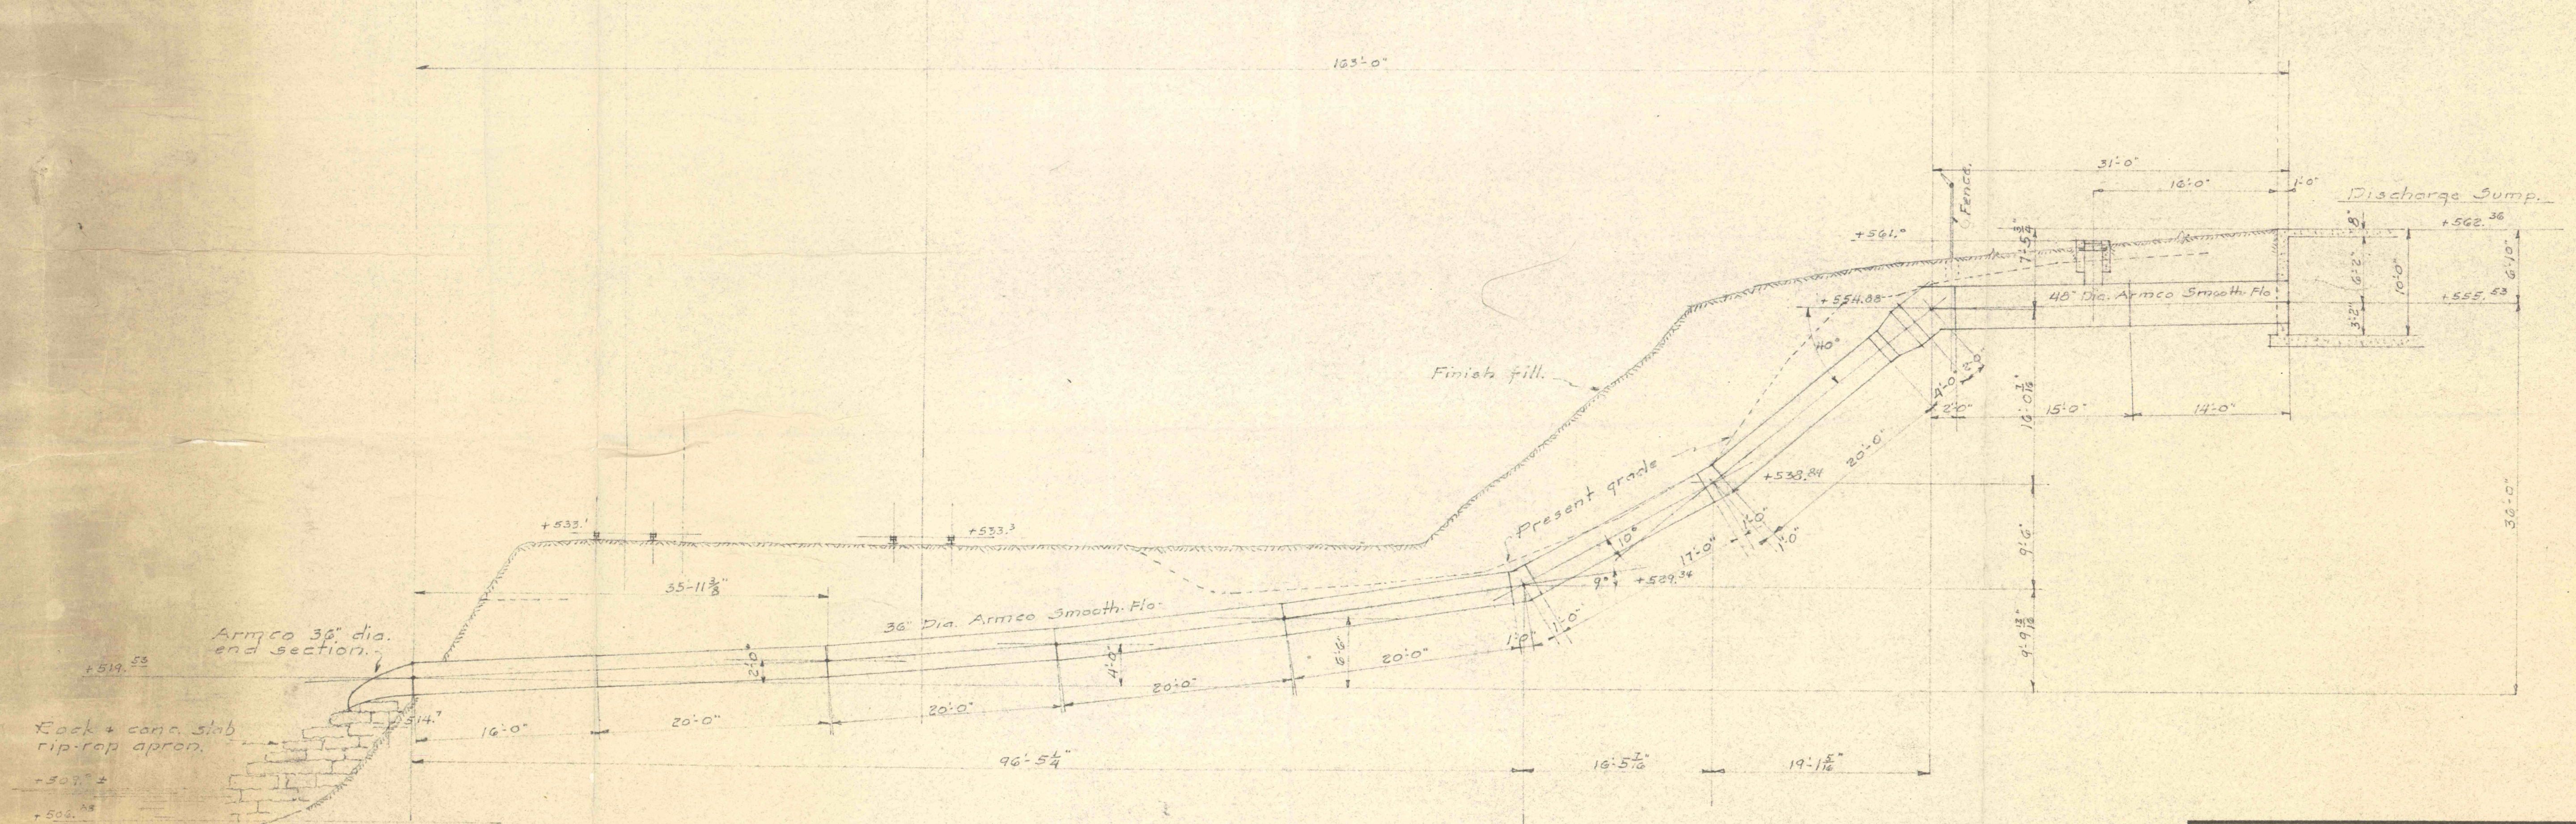

1/8" SECTION.

For original layout for Discharge Pipe see Job 628, drawing #1 as prepared by Roushey & Smith Engineers, Kingston, Pa.

For details of pipe and fittings see Armeo Drainage & Metal Products, Inc. drawing A.E. 827, C.E. 678 and C.E. 651.

BUTTONWOOD COLLIERY.
FLOOD CONTROL PROJECT #13, PHASE B
REVISED LOCATION FOR DISCHARGE PIPE

GLEN ALDEN CORPORATION Wilkes-Barre, Pa.
SCALE: As noted. CONSTRUCTION ENGINEERS

APPROVED	DRAWN BY C.W.C. 11/1/58
Const. Engr. Lic. 11/21/58	TRACED BY
	CHECKED BY
S 2578	