




1/2 NORTH ELEVATION

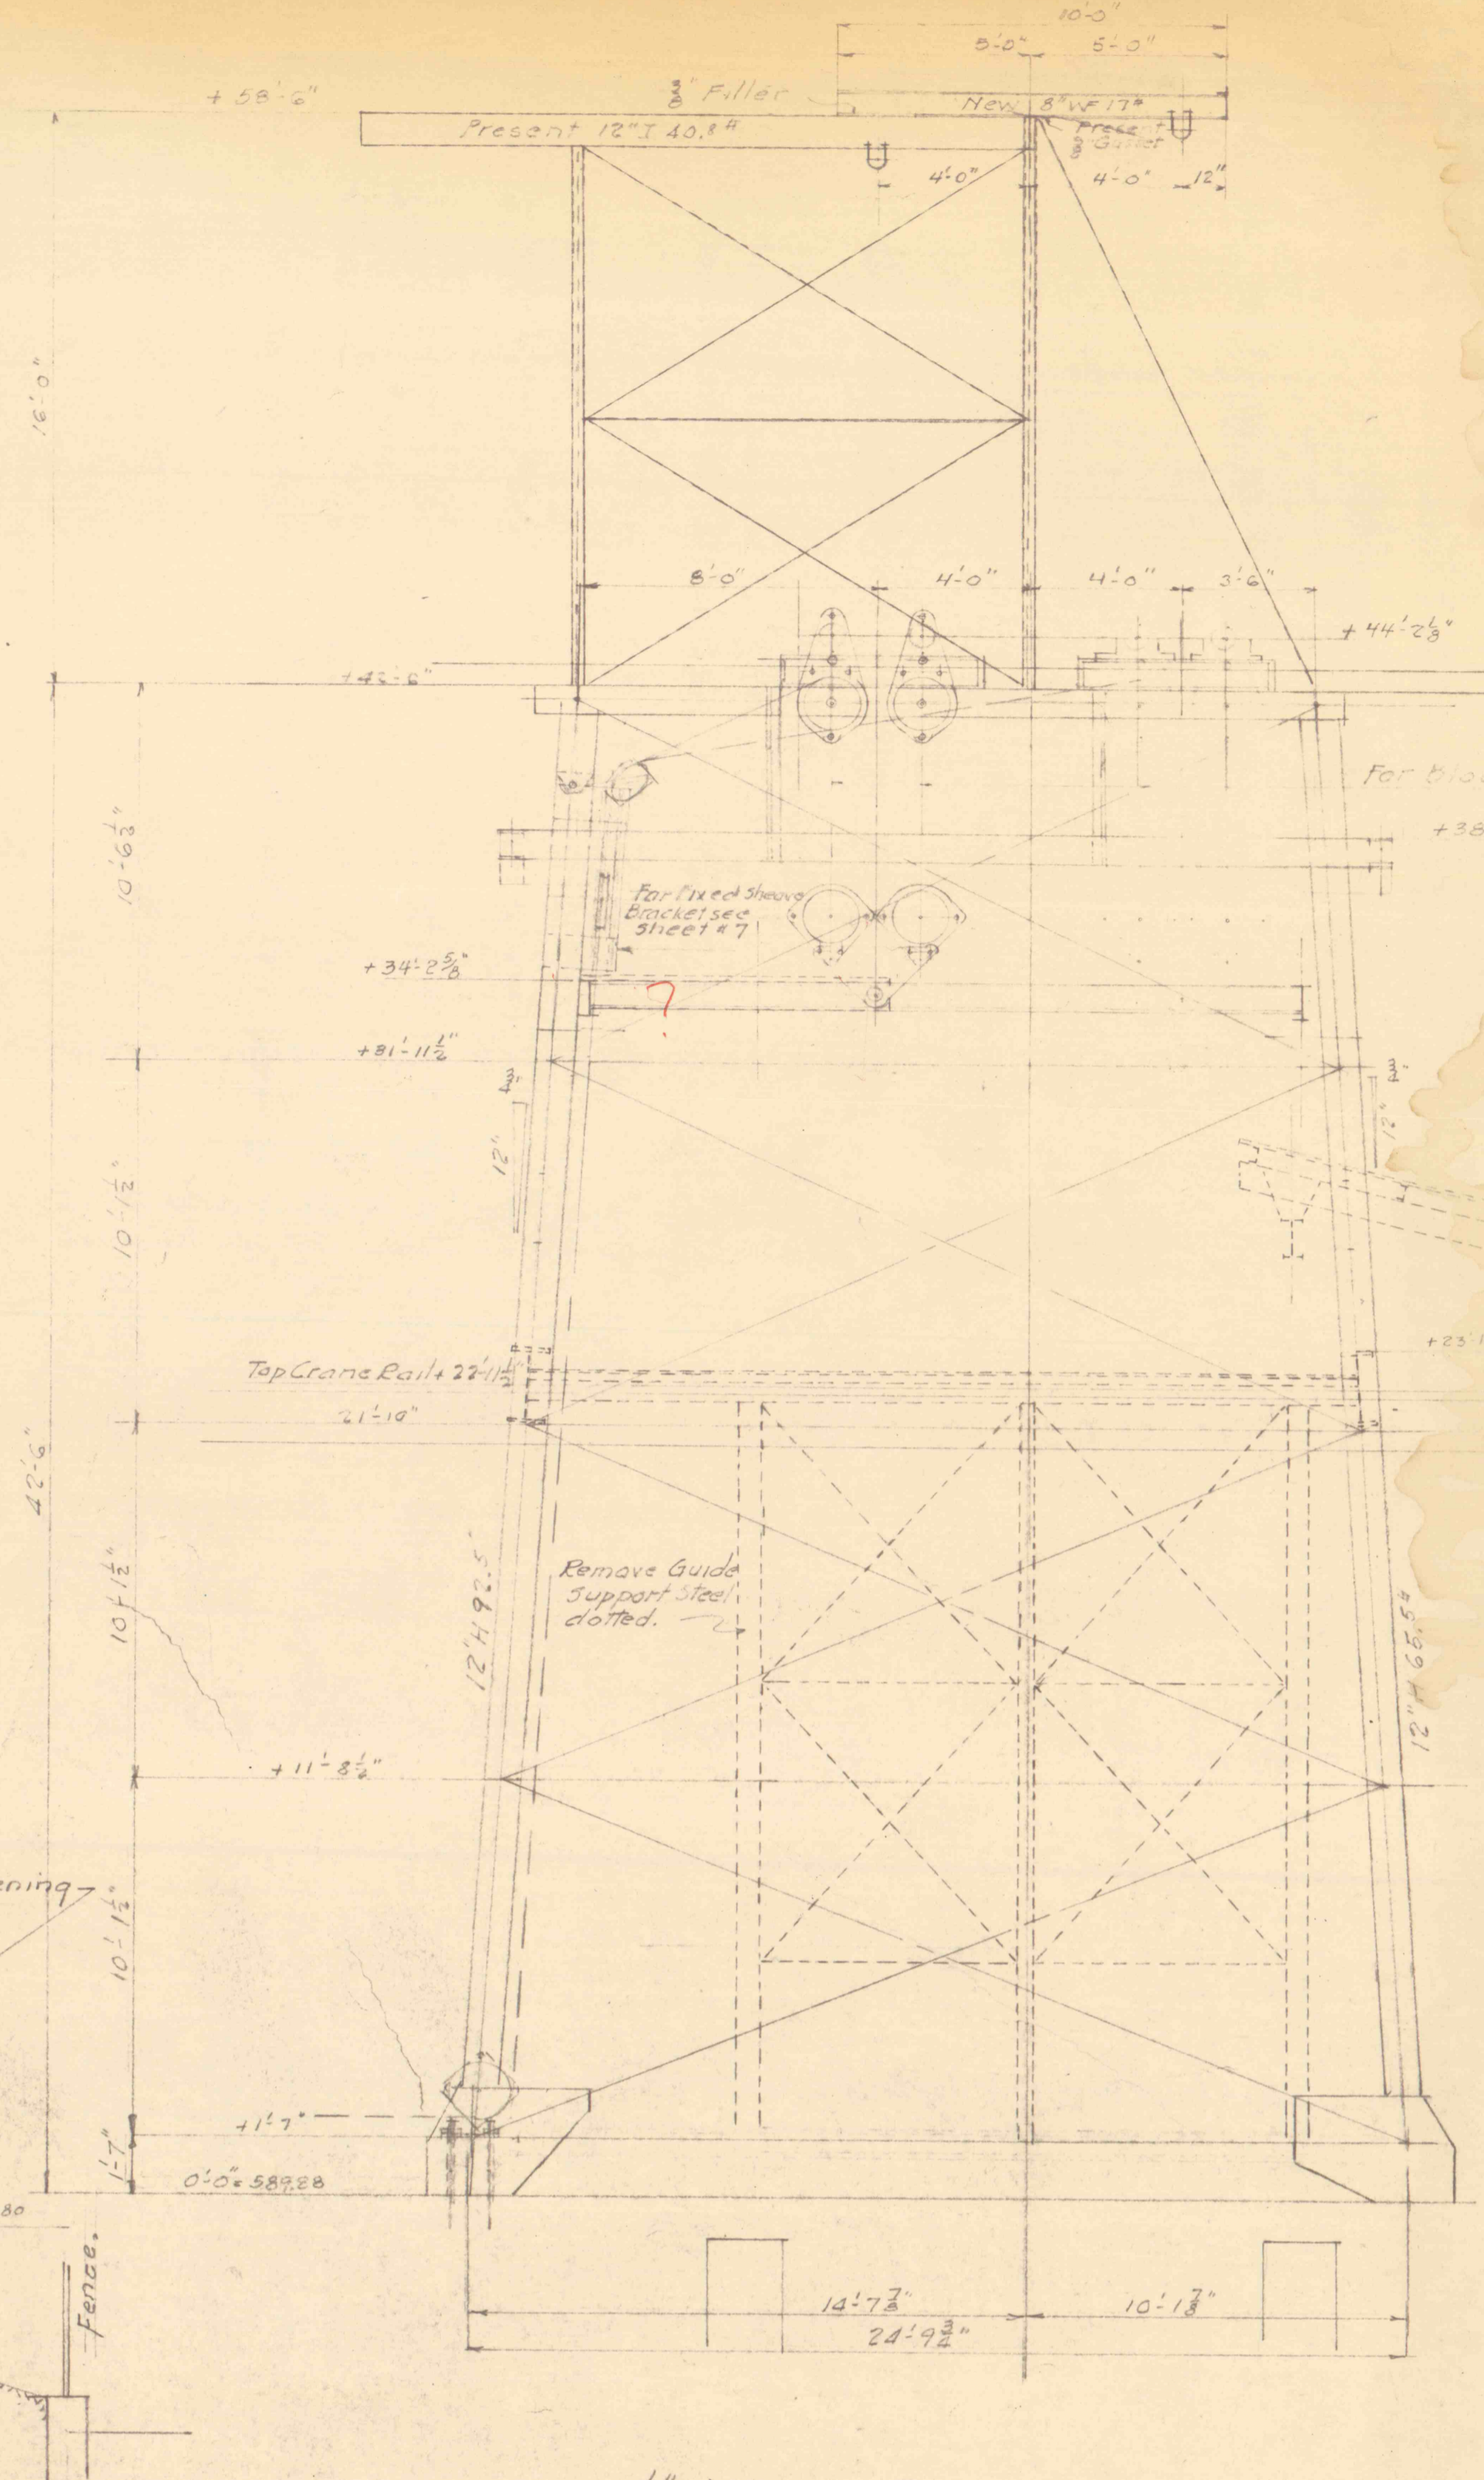


1/2 WEST ELEVATION

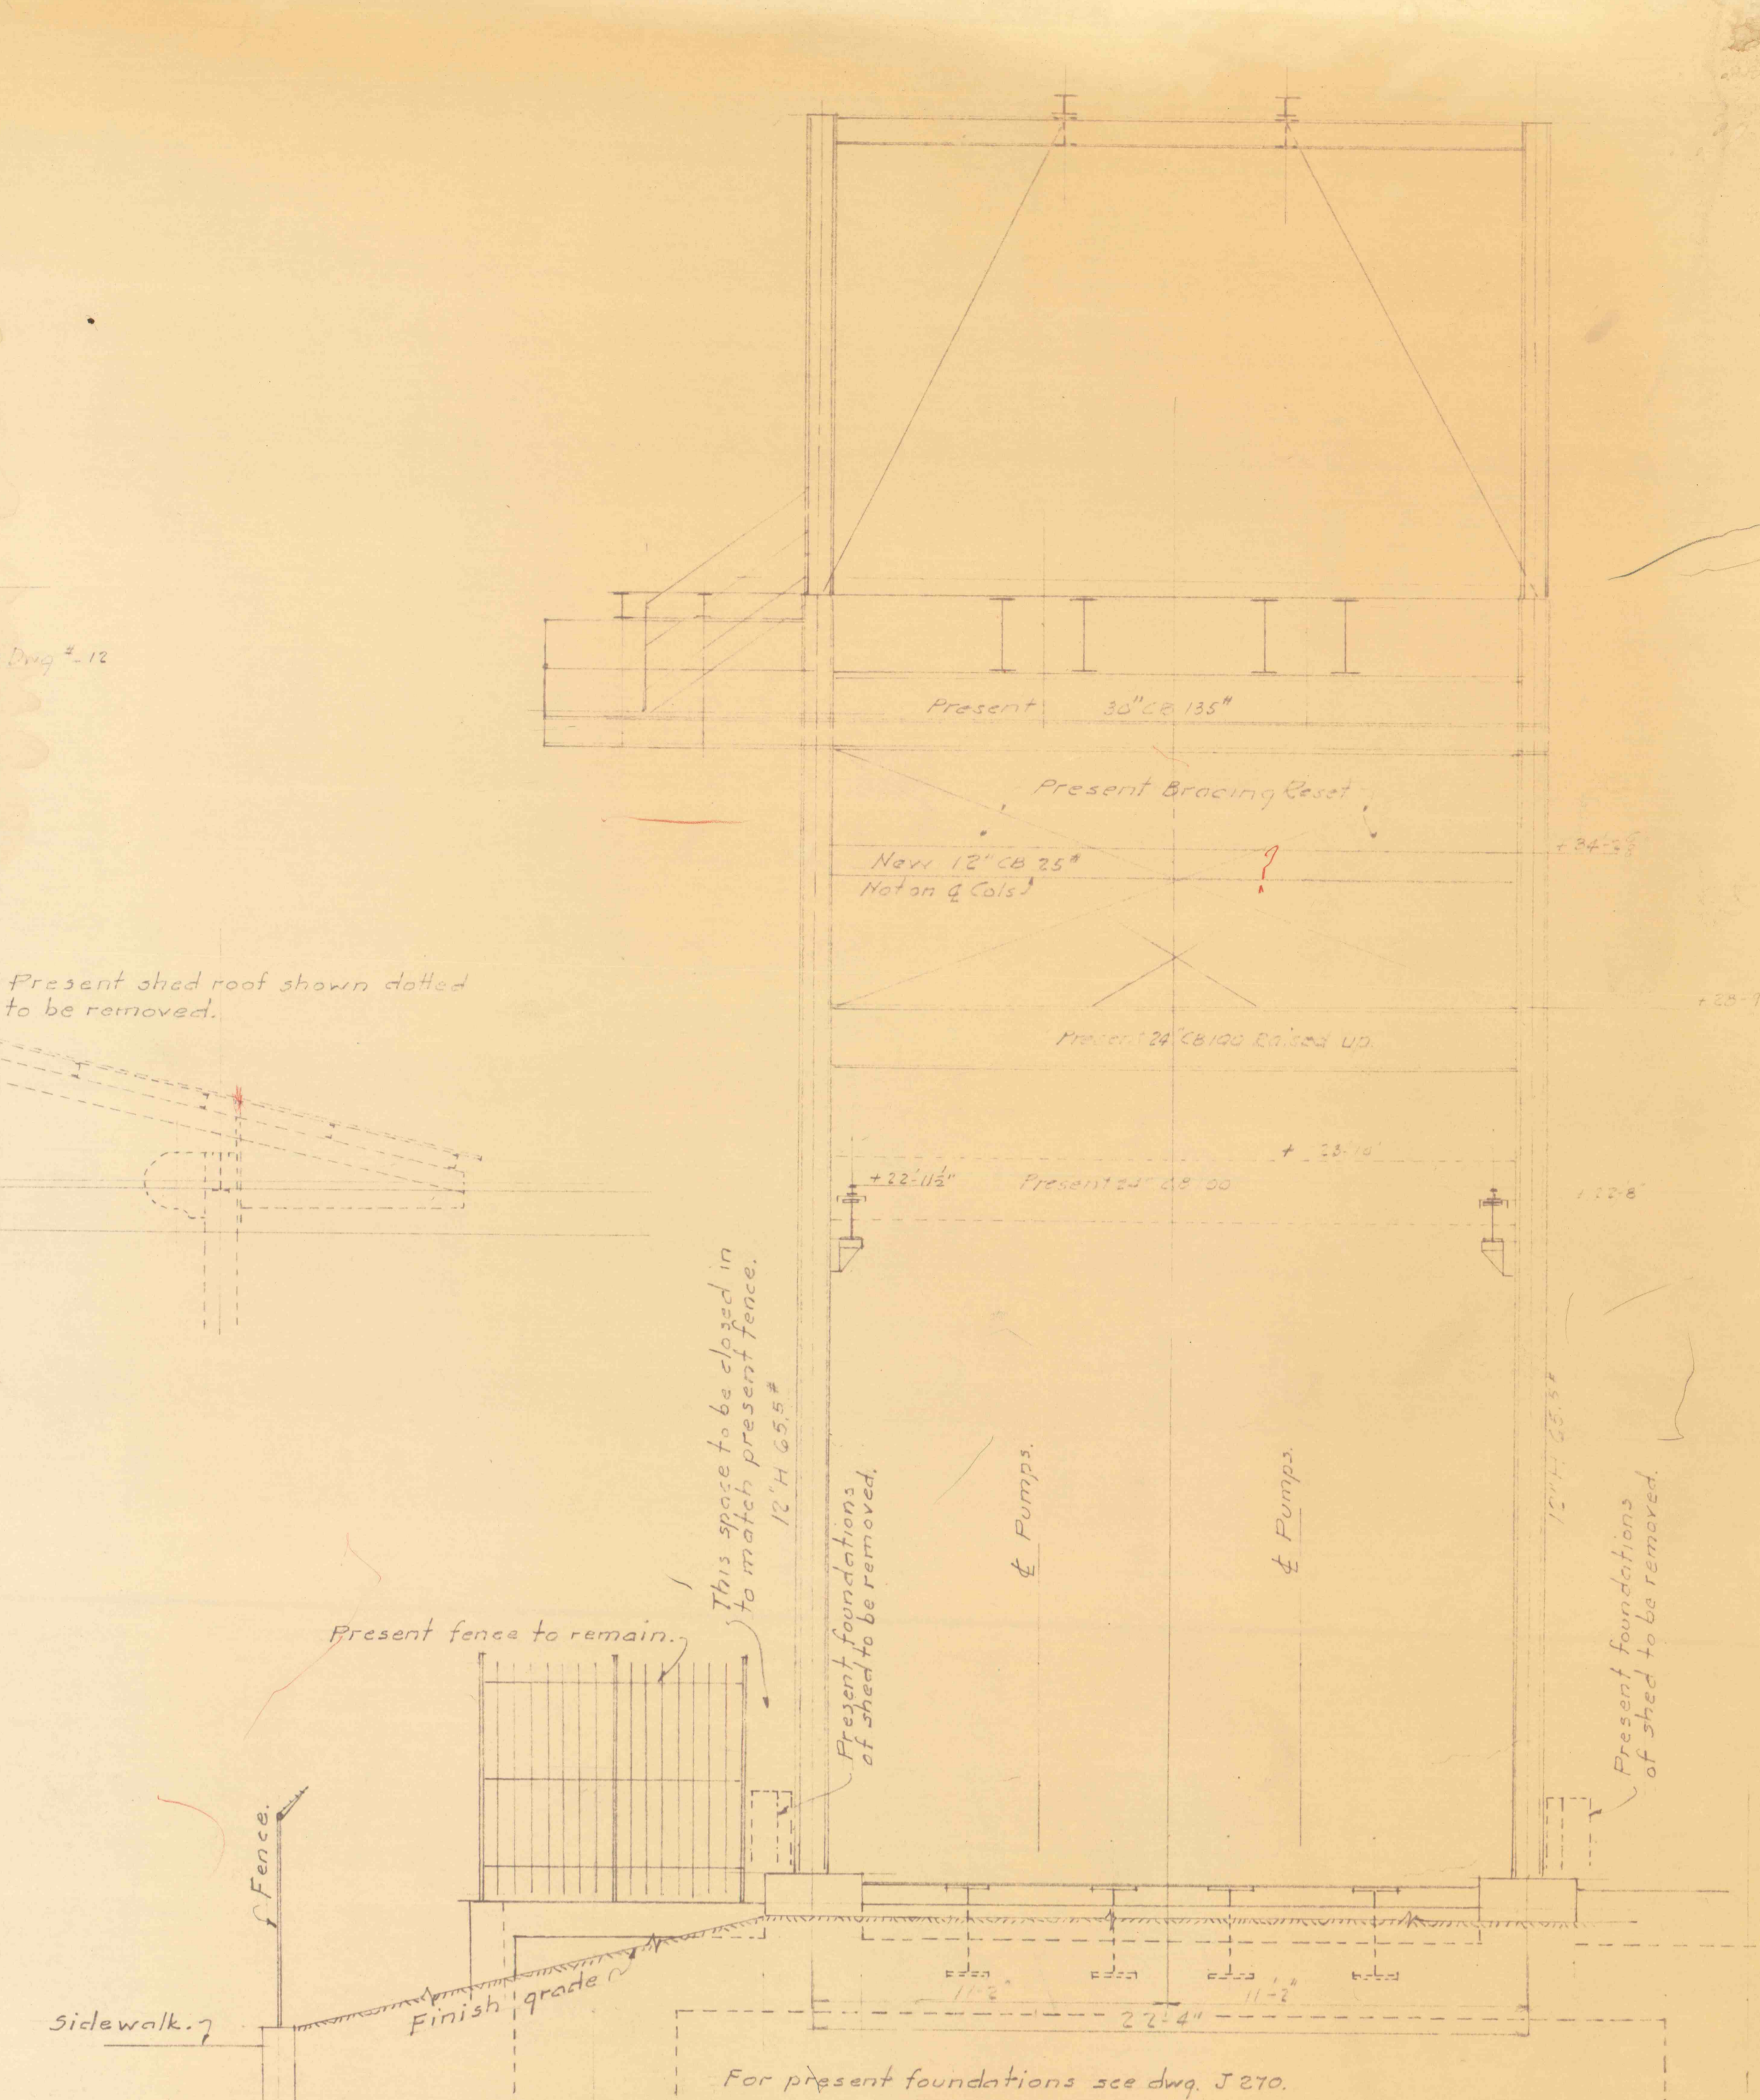


1/2 SOUTH ELEVATION

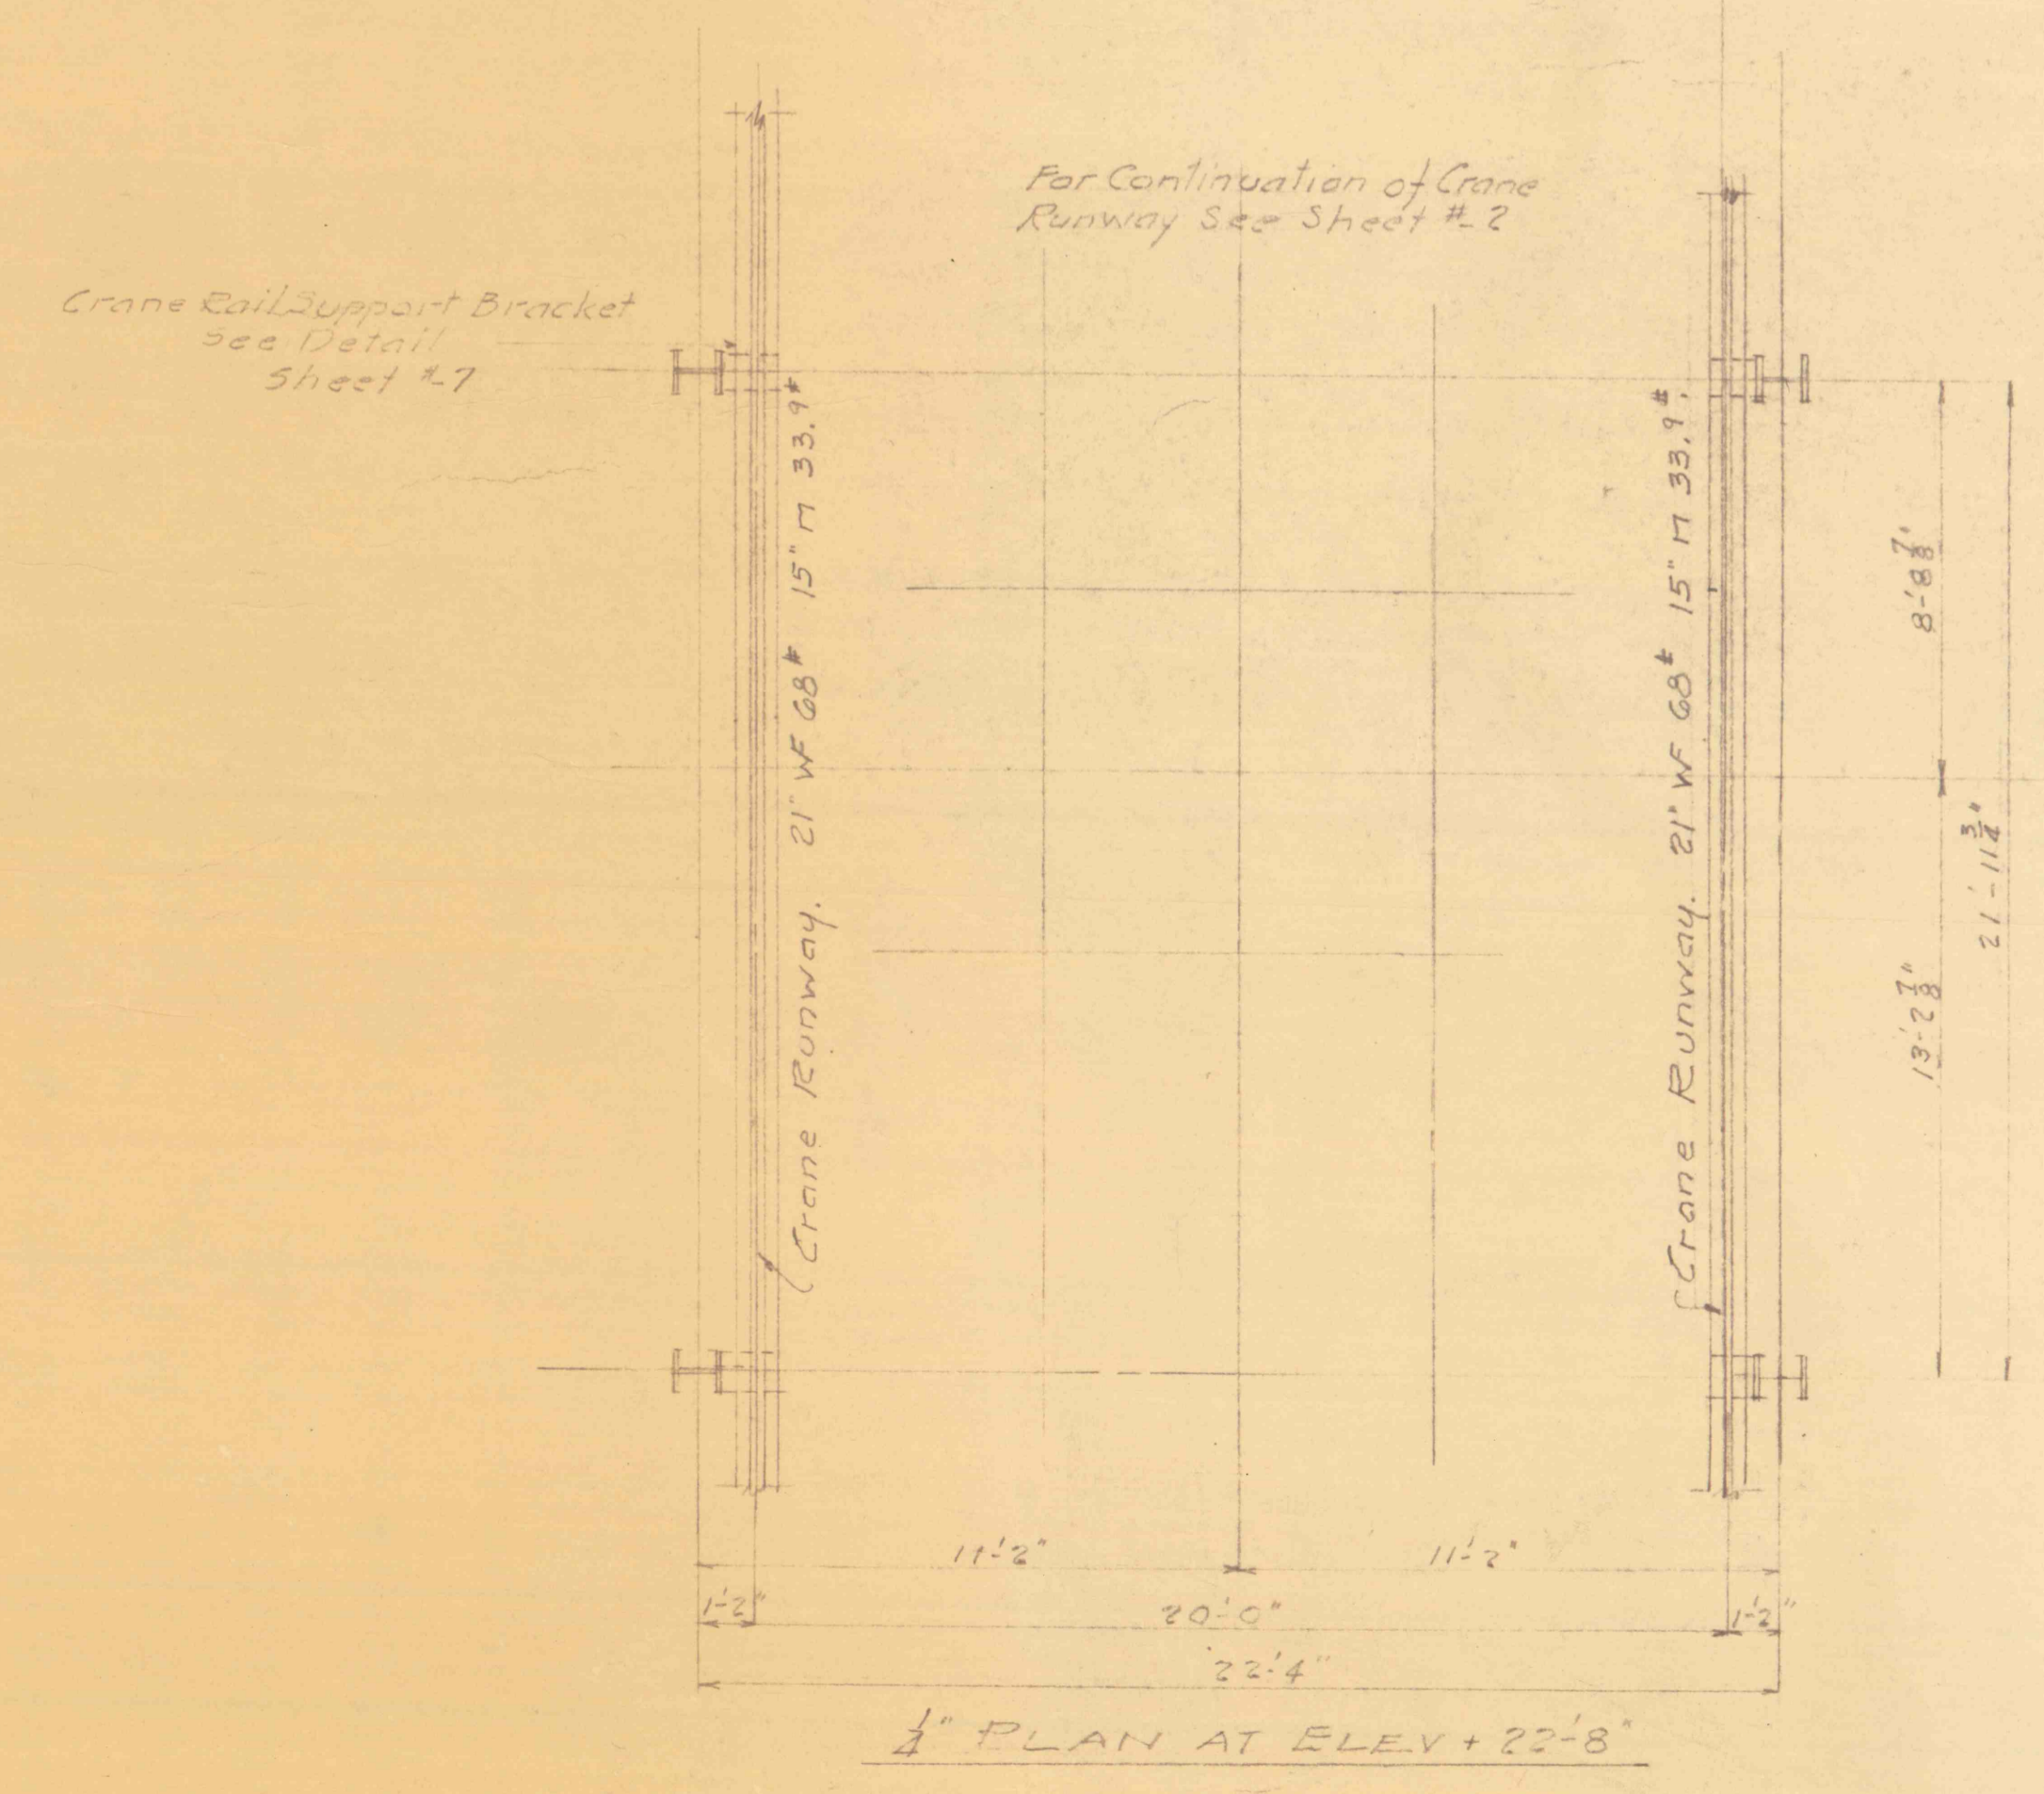


1/2 PLAN AT ELEV +22'-8"

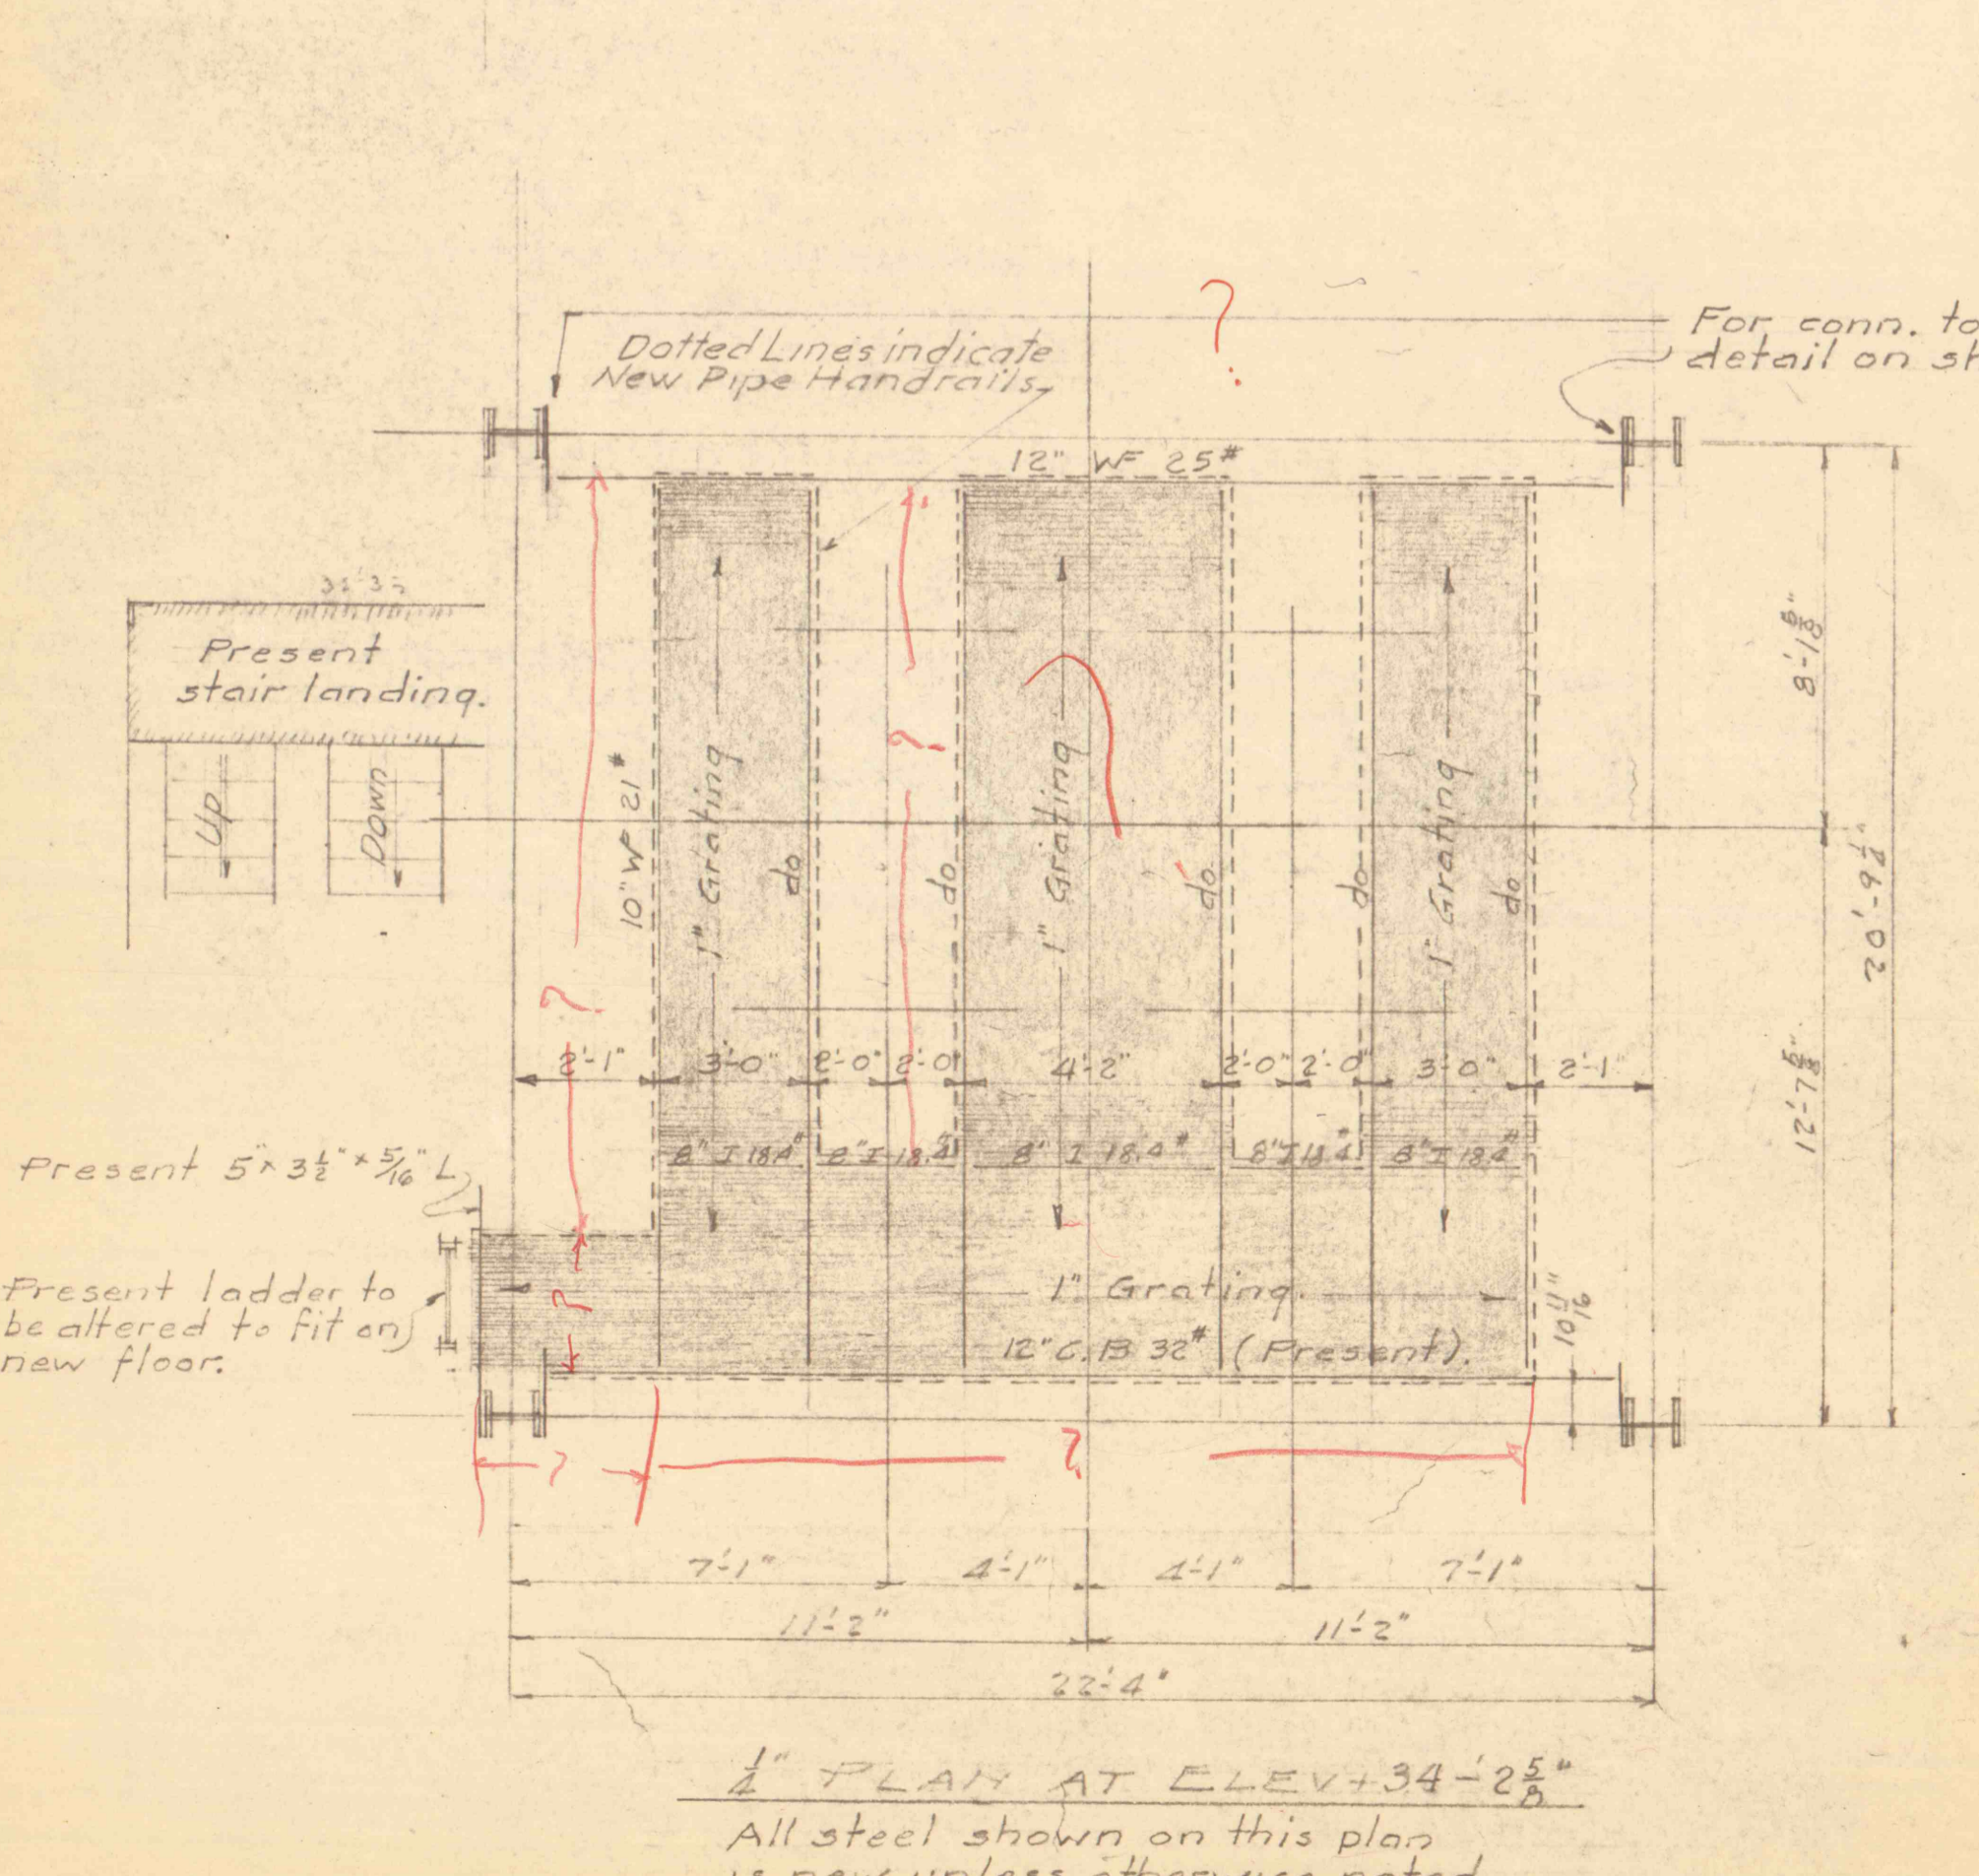


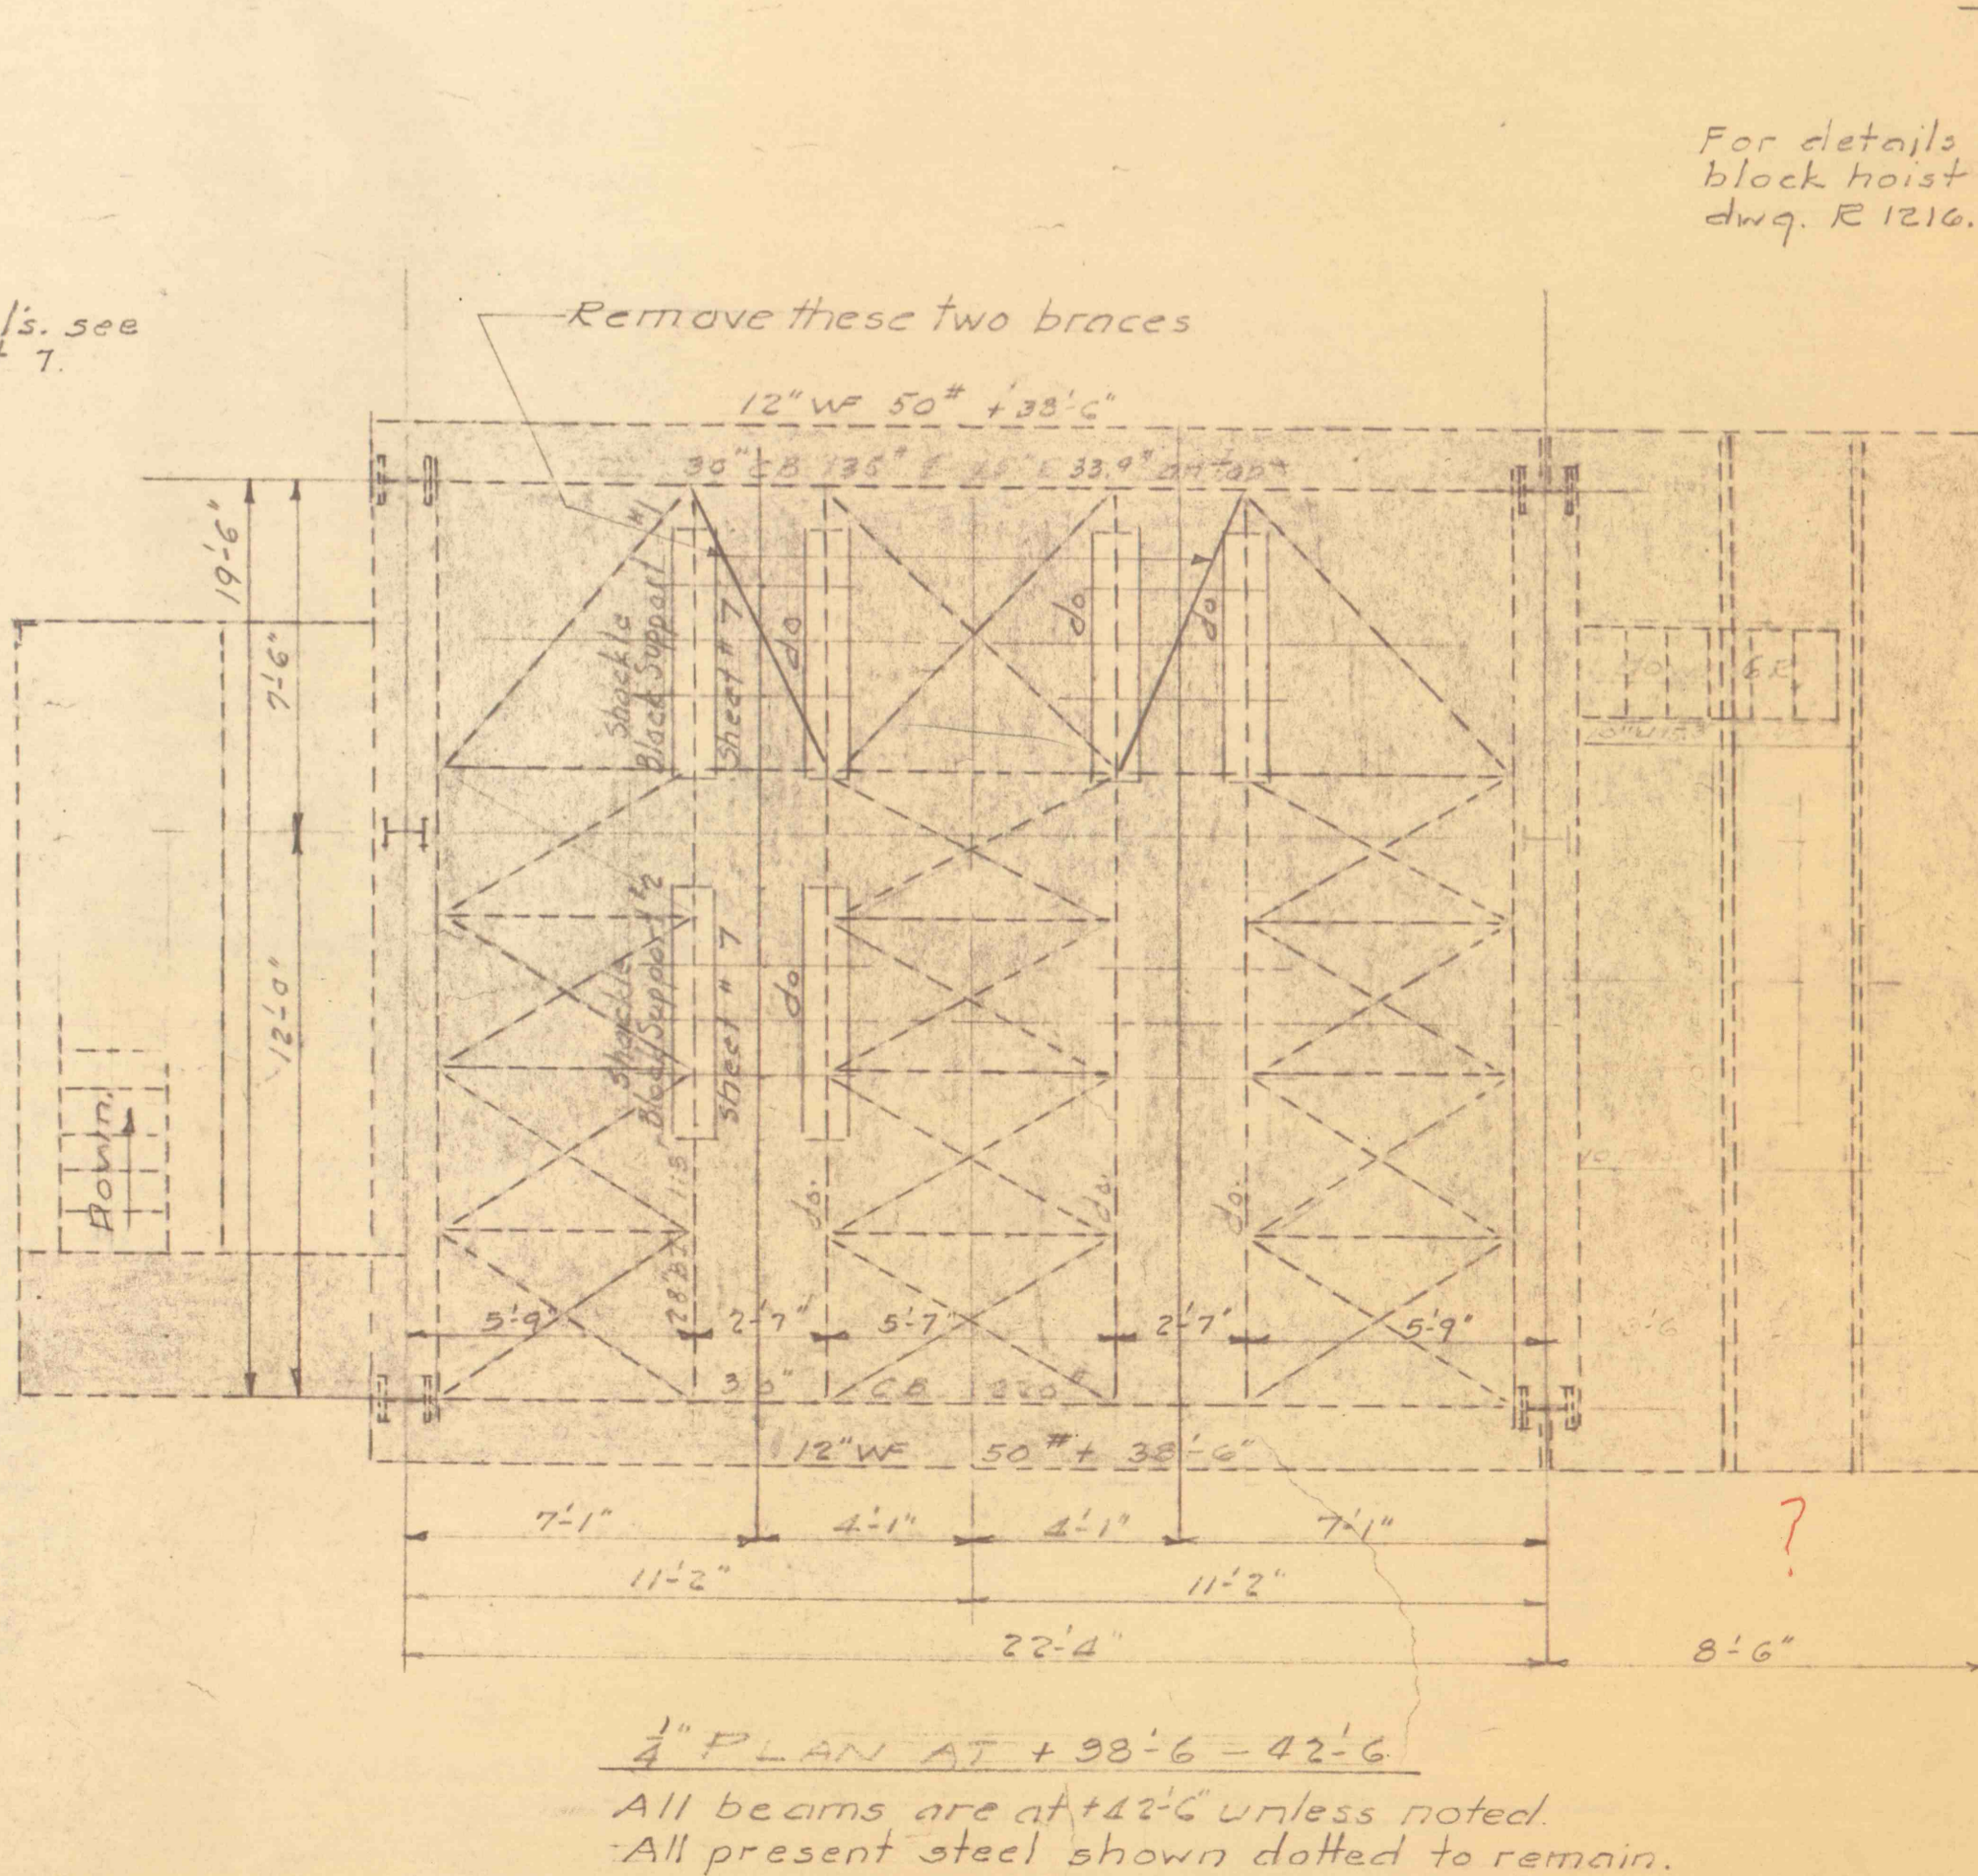


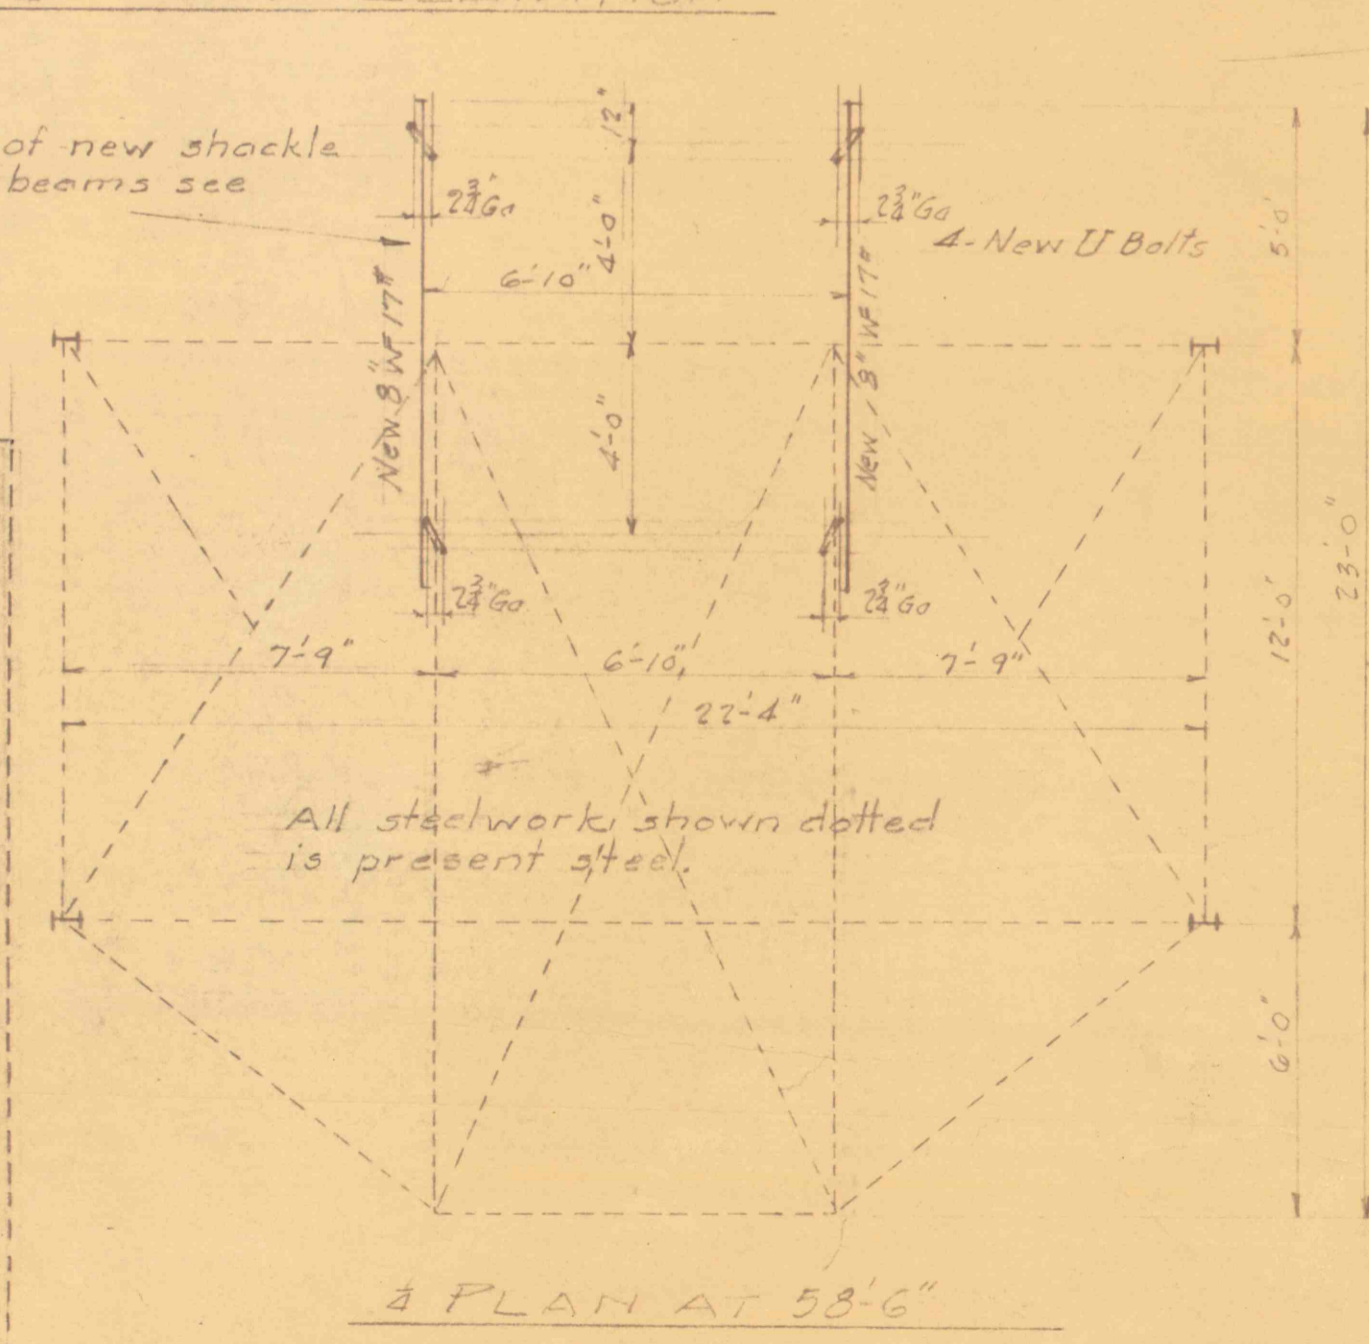

3/4 PLAN AT 58'-6"

STRUCTURAL STEEL
 14 Sheets Sheet 9
 30 WILKES-BARRE #5 COLLIERY
 FLOOD CONTROL PROJ. #26 PHASE "B"
 PA. DEPT. OF MINES & MINERAL INDUSTRIES
GLEN ALDEN CORPORATION Wilkes-Barre, Pa.
 SCALE: As noted. CONSTRUCTION ENGINEERS
 APPROVED: Const. Engr. G.W.C. 11/18/59
 DRAWN BY: E.W.E. 6.11.58 12-17-57
 TRACED BY:
 CHECKED BY:
R1215

For present head frame etc. see dwgs. J270. to J274 incl.