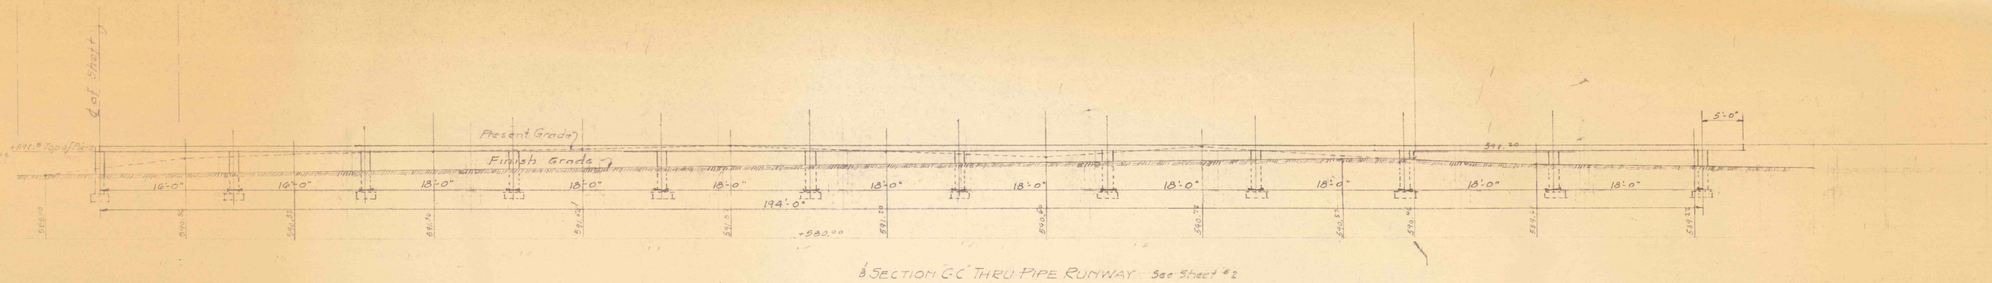

℄ SECTION C-C THRU PIPE RUNWAY See Sheet #2

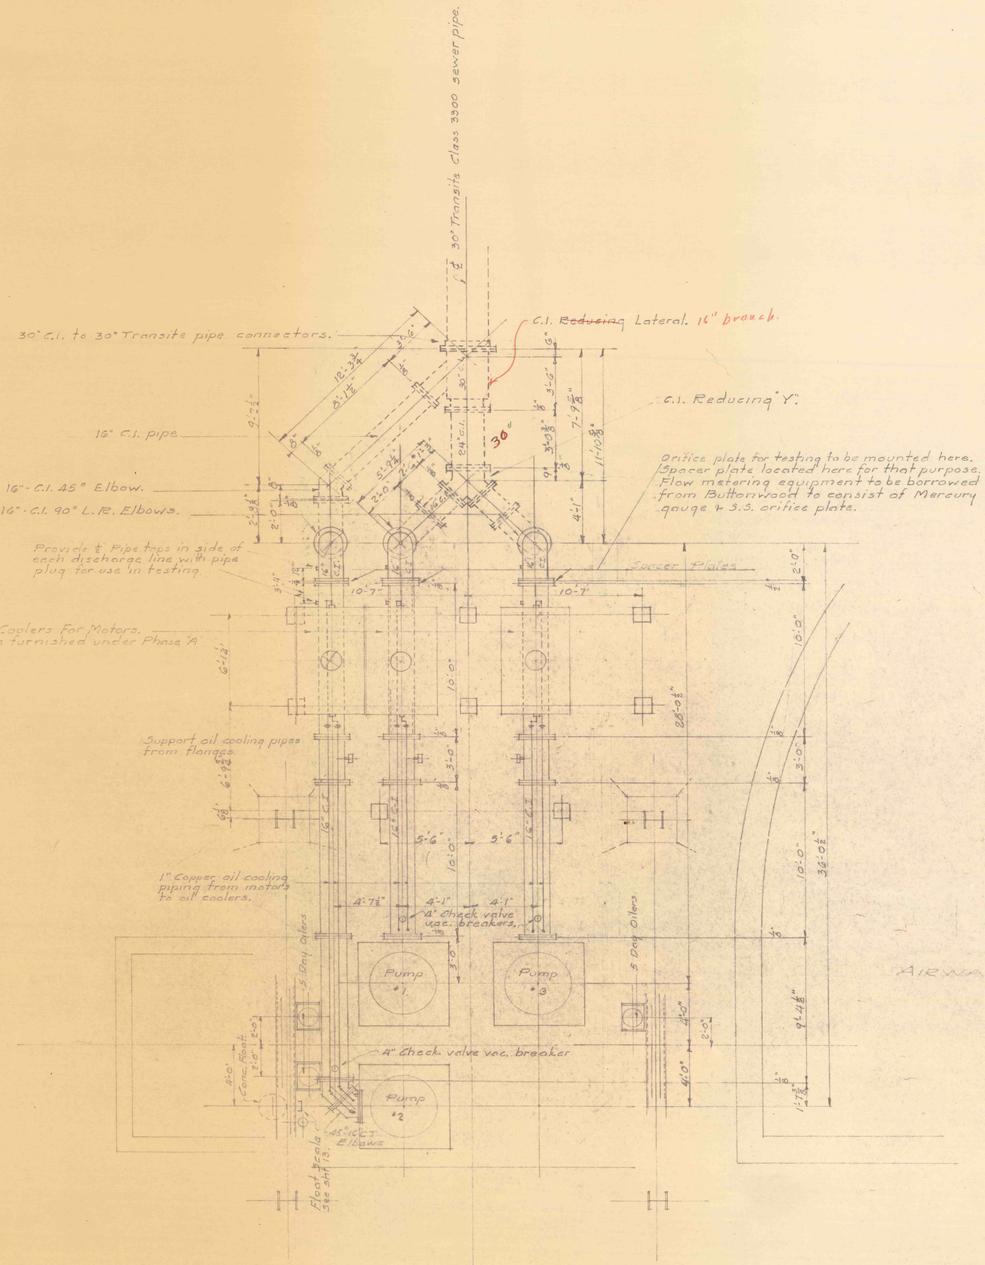

AIRWAY

¼" PLAN SHOWING PIPING FROM PUMPS.
SECT. A.

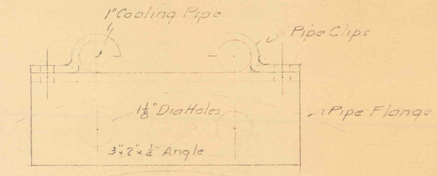

1½" DETAIL OF COOLING PIPE SUPPORTS

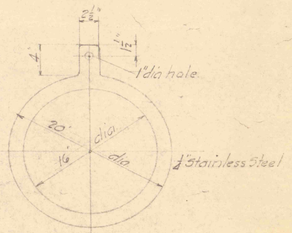

1½" DETAIL OF SPACER PLATE
3 - Req'd

BRACKET FOR MOUNTING 5 DAY OILER
3 Req'd.

 

PIPING DIAGRAM FOR 5 DAY OILERS.
3 Req'u.

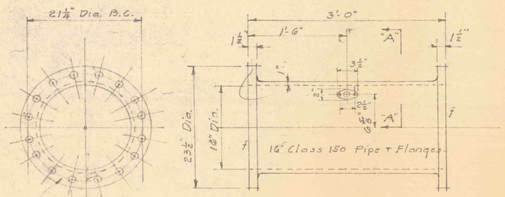

CAST IRON PIPE
3 Req'u.

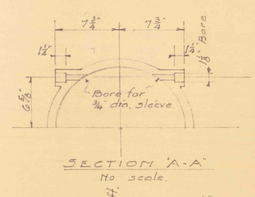

SECTION 'A-A'
No scale.

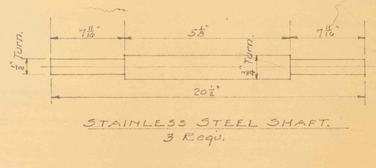

STAINLESS STEEL SHAFT.
3 Req'd.

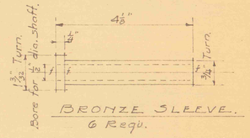

BRONZE SLEEVE.
6 Req'd.

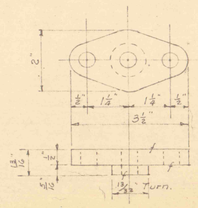

BRONZE GLAND
No scale. 6 Req'd.

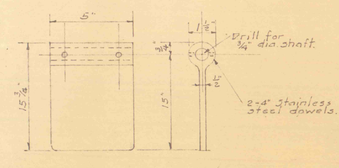

BRONZE FLAP
No scale. 3 Req'd.

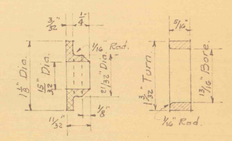

SOFT LEATHER WASHER
12 Req'd.

BRONZE SPACER
12 Req'd.

FLOW SWITCH.
4 Req'd.

DISCHARGE PIPING - SECT. A

14 Sheets Sheet 8

50. WILKES BARRE "5 COLLIERY FLOOD CONTROL PROJ." "26 PHASE" "B"
PA. DEPT. OF MINES & MINERAL INDUSTRIES

GLEN ALDEN CORPORATION Wilkes-Barre, Pa.
SCALE: As noted. CONSTRUCTION ENGINEERS

APPROVED	DRAWN BY E.W.C. 12-17-52
Const. Engr. E.W.C. 12/18/52	TRACED BY
	CHECKED BY

R 121