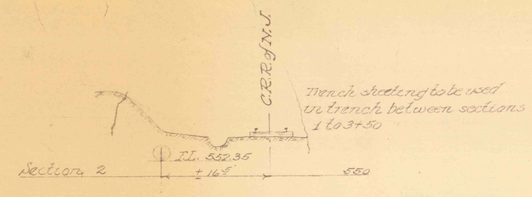

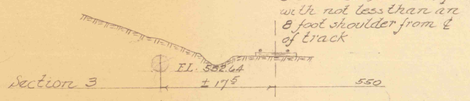

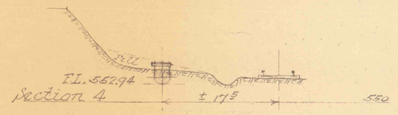

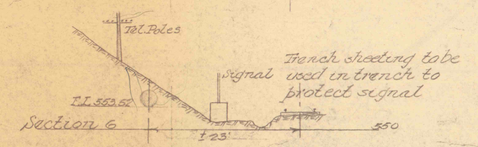

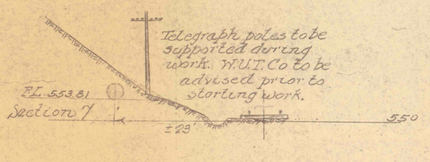

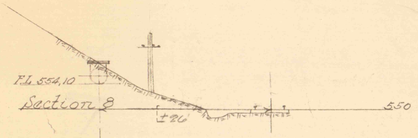

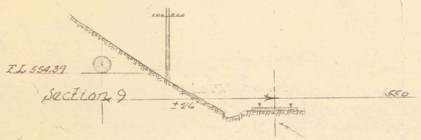

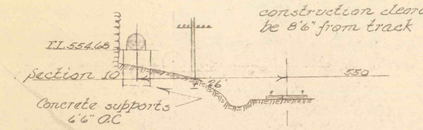

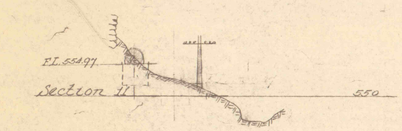

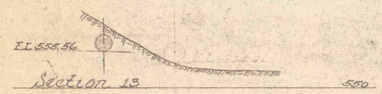

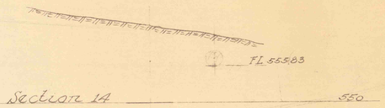

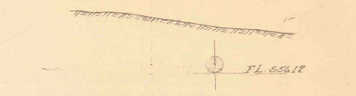

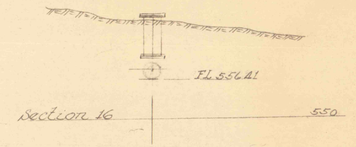

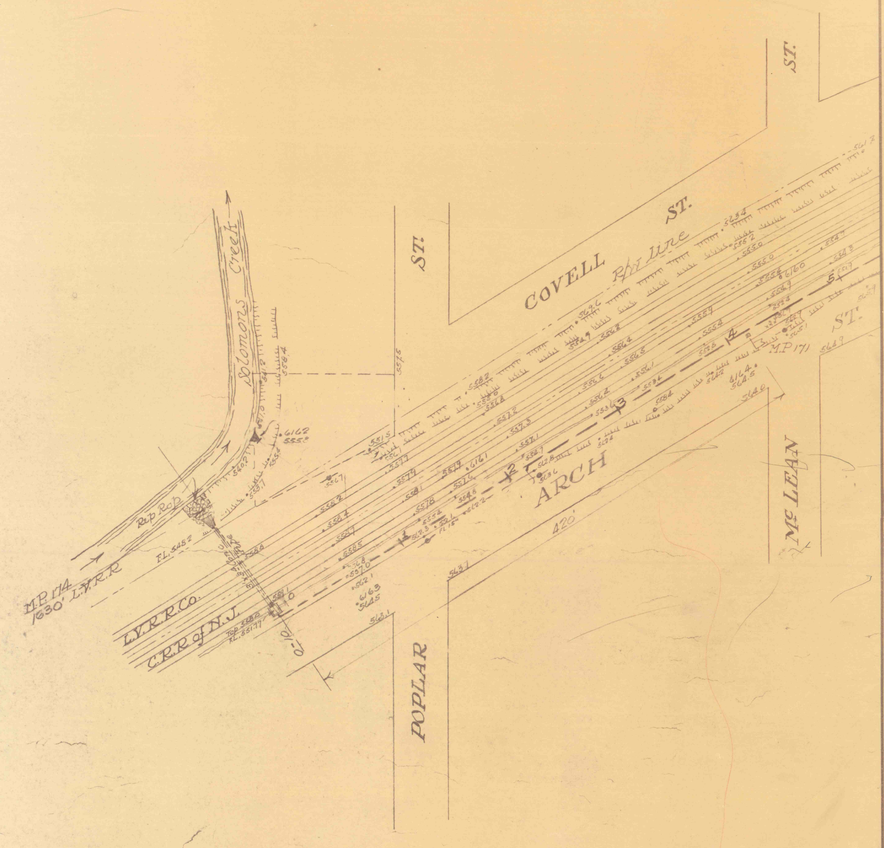

Sections thru proposed 30" pipe Scale 1"=10'

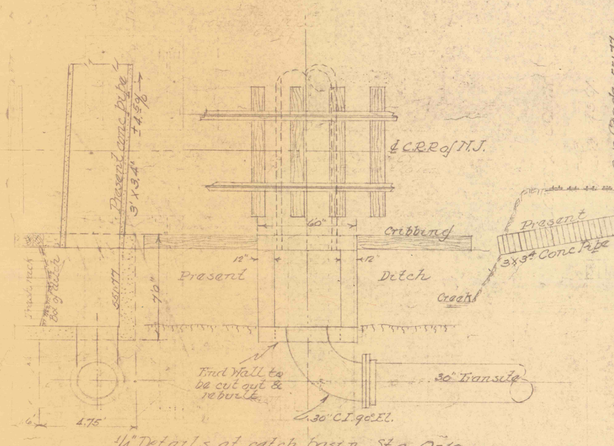

½" Details at catch basin Sta 0-10

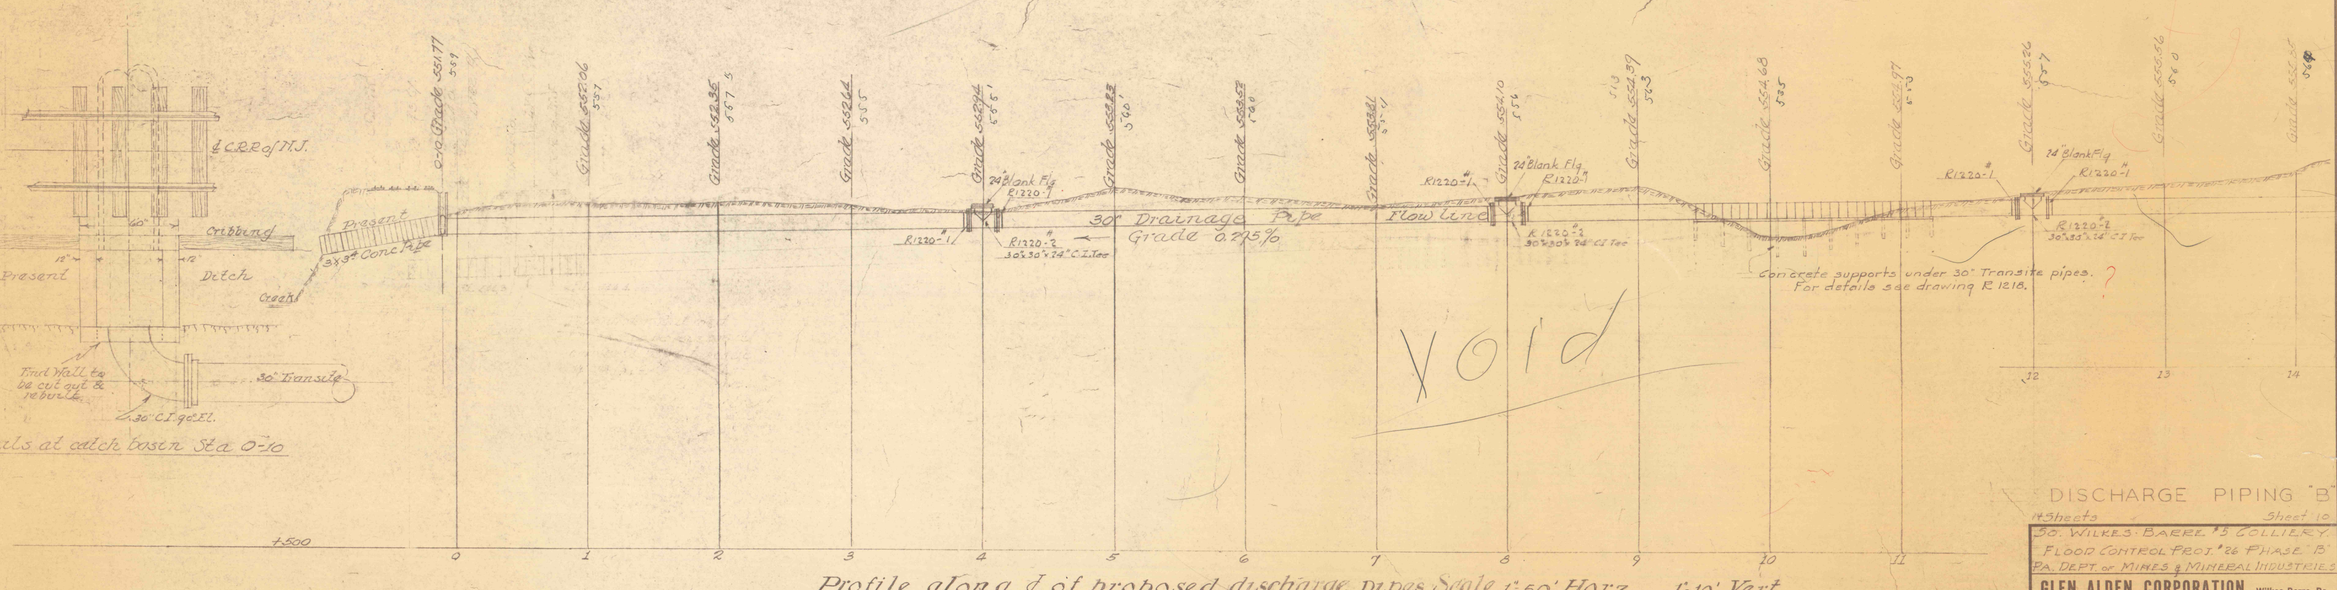

Profile along ℄ of proposed discharge pipes Scale 1"=50' Horz. 1"=10' Vert.

Void

DISCHARGE PIPING "B"

14 Sheets Sheet 10

So. WILKES-BARRE #5 COLLIERY
FLOOD CONTROL PROJ. #26 PHASE B
PA. DEPT. OF MINES & MINERAL INDUSTRIES

GLEN ALDEN CORPORATION Wilkes-Barre, Pa.
SCALE: As noted. CONSTRUCTION ENGINEERS

APPROVED	DRAWN BY M.D.D. 12-17-59
Const. Engr. CWP, #18649	TRACED BY
	CHECKED BY
	R 1219