


NO. 3 - DUNMORE ST.

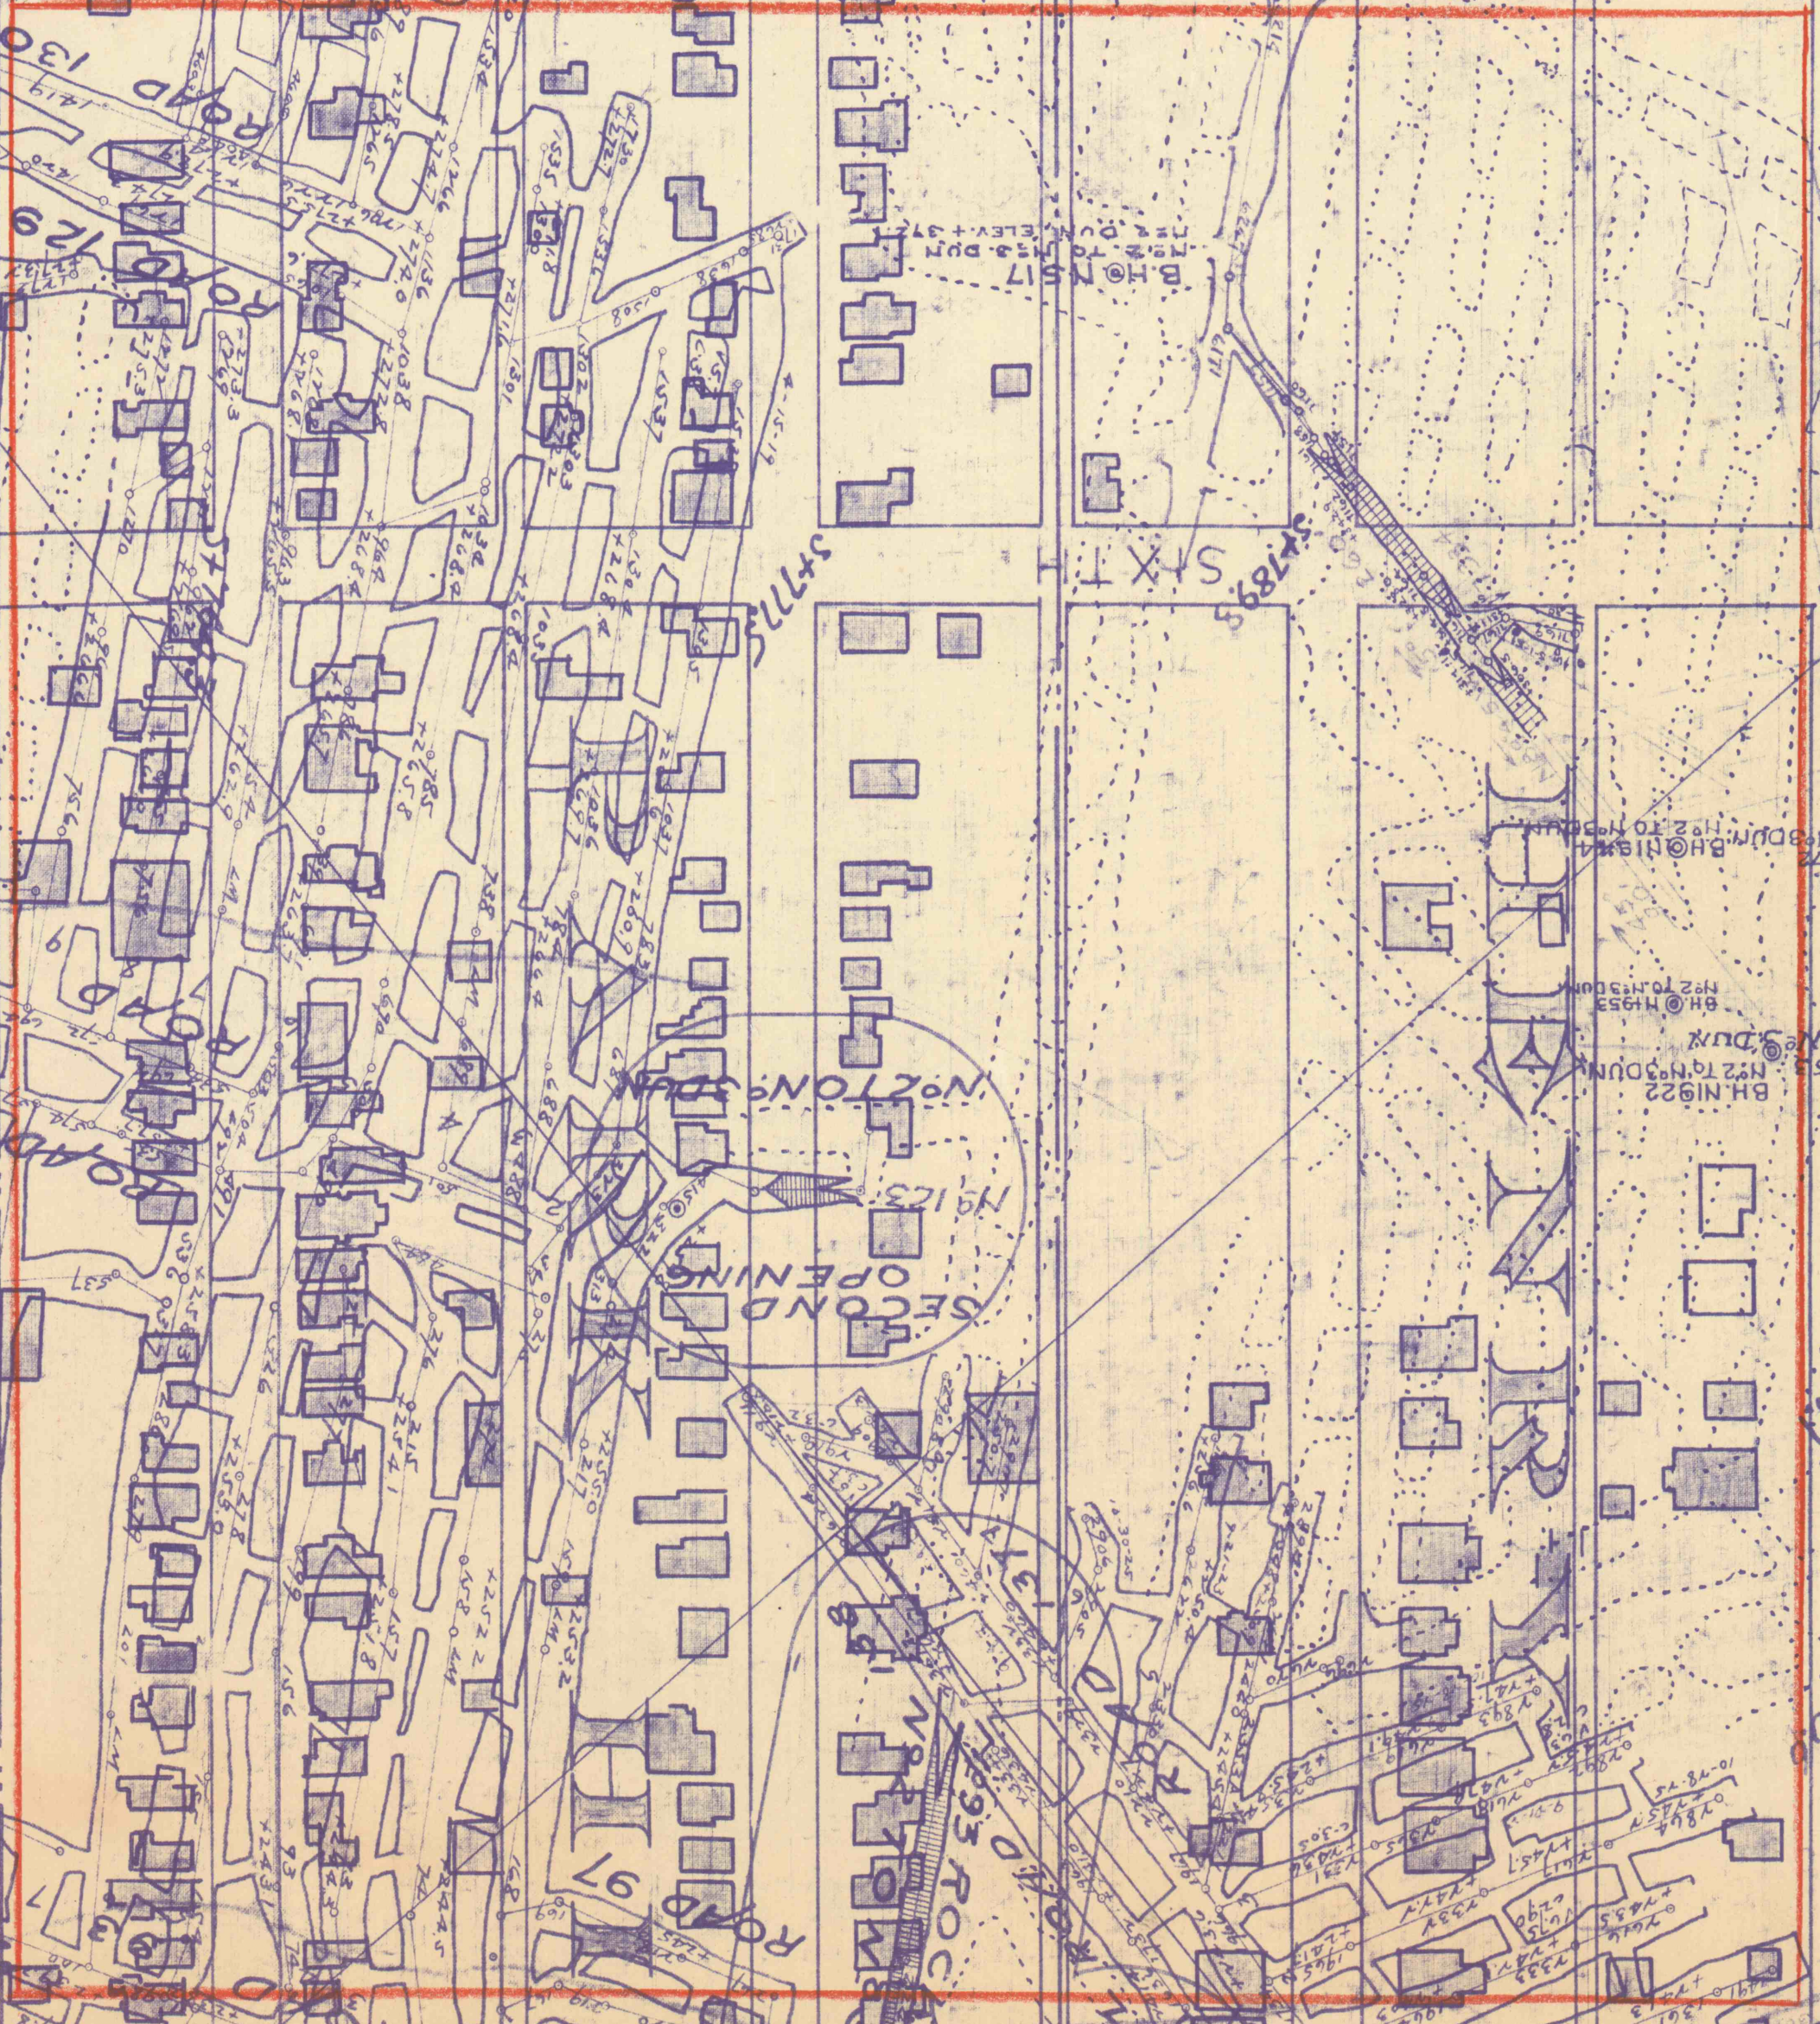

SECOND  
OPENING

33 ROCK  
ROAD







