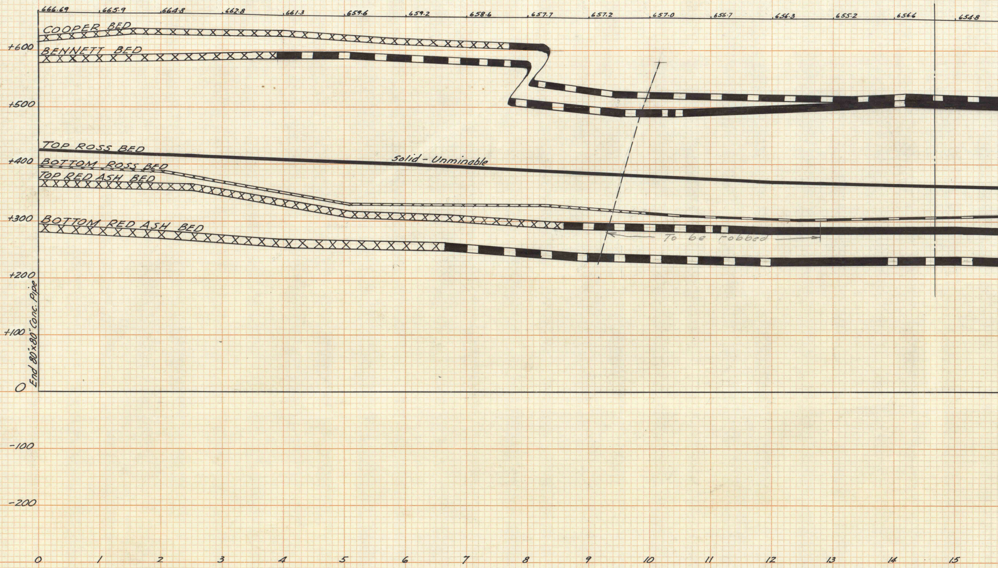
666.69
665.9
664.8
662.8
661.3
659.6
659.2
658.6
657.7
657.2
657.0
656.7
656.3
655.2
656.6
654.8
COOPER BED
BENNETT BED
TOP ROSS BED
Solid - Unminable
BOTTOM ROSS BED
TOP RED ASH BED
BOTTOM RED ASH BED
To be robbed
+600
+500
+400
+300
+200
+100
0
-100
-200
End 80"x80" Conc. Pipe
0
1
2
3
4
5
6
7
8
9
10
11
12
13
14
15

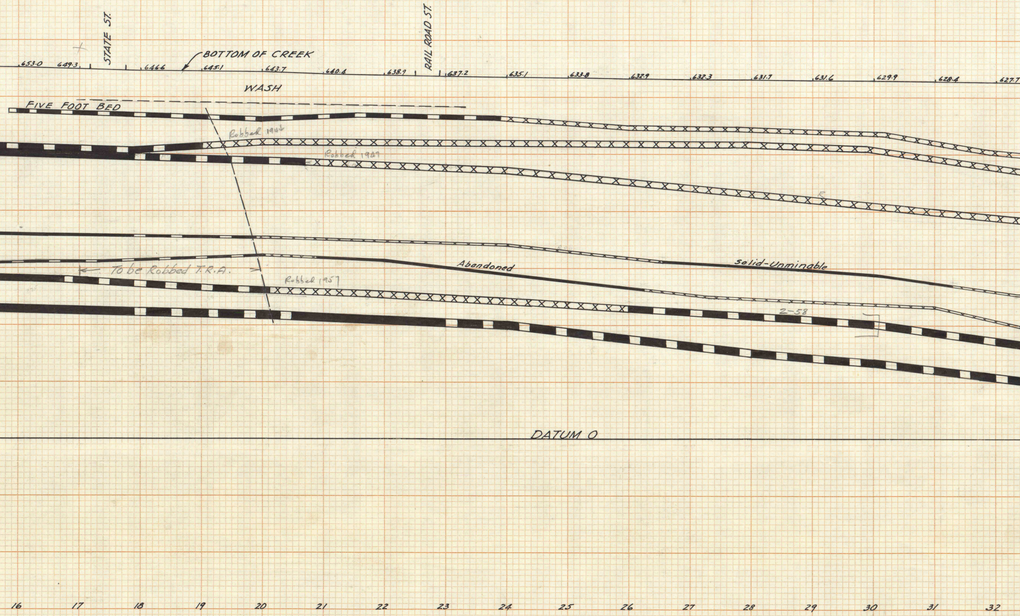
STATE ST.
RAIL ROAD ST.
BOTTOM OF CREEK
653.0
649.3
646.6
645.1
643.7
640.4
638.9
637.2
635.1
633.8
632.9
632.3
631.7
631.6
629.9
628.4
627.7
WASH
FIVE FOOT BED
Robbed 1944
Robbed 1947
To be Robbed T.R.A.
Abandoned
Solid-Unminable
Robbed 1957
2-58
DATUM 0
16
17
18
19
20
21
22
23
24
25
26
27
28
29
30
31
32

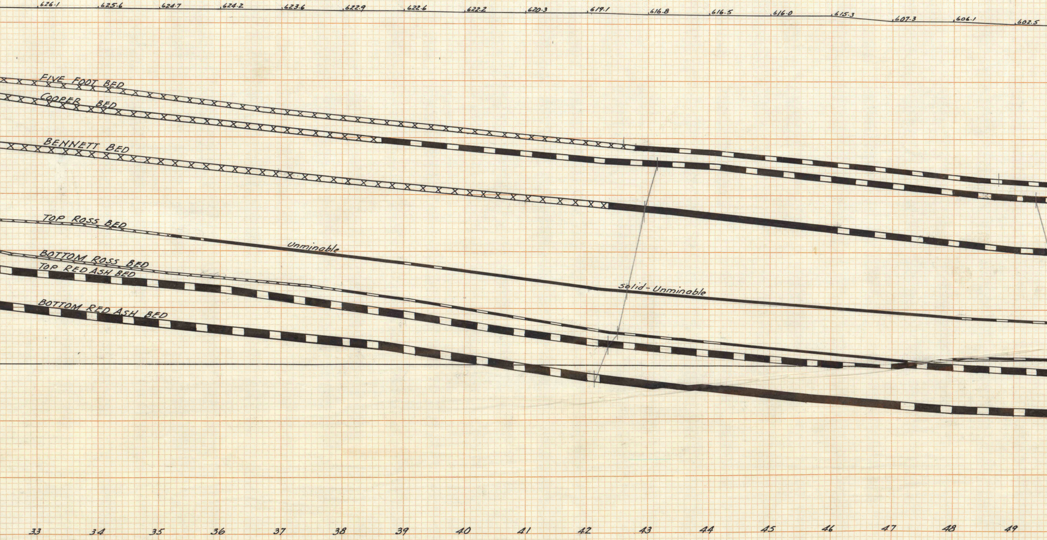
626.1
625.6
624.7
624.2
623.6
622.9
622.6
622.2
620.3
619.1
616.8
616.5
616.0
615.3
607.3
606.1
602.5
FIVE FOOT BED
COOPER BED
BENNETT BED
TOP ROSS BED
Unminable
BOTTOM ROSS BED
TOP RED ASH BED
Solid-Unminable
BOTTOM RED ASH BED
33
34
35
36
37
38
39
40
41
42
43
44
45
46
47
48
49

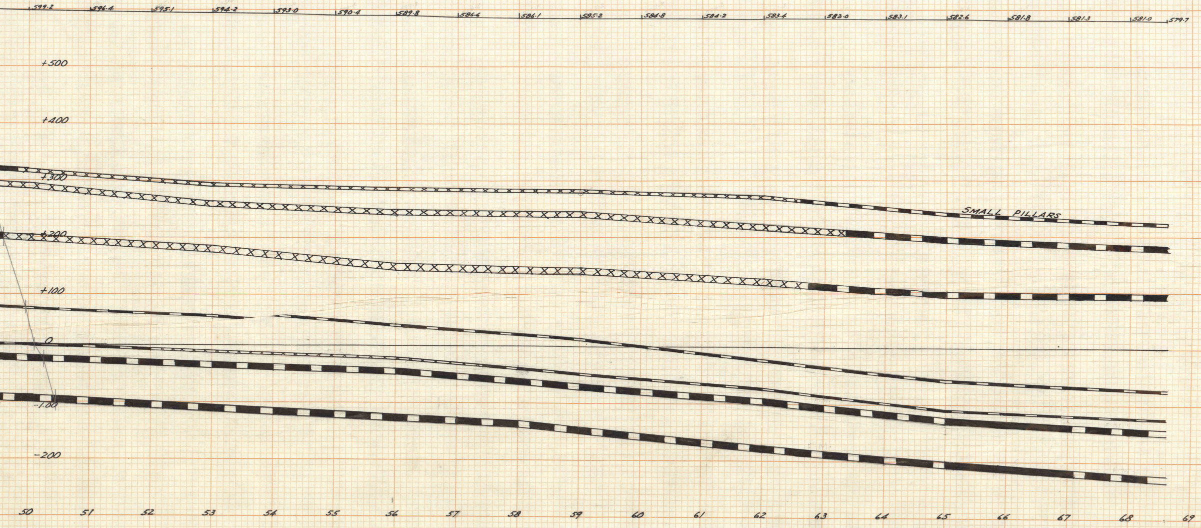
599.2
596.4
595.1
594.2
593.0
590.4
589.8
586.6
586.1
585.2
584.8
584.2
583.4
583.0
583.1
582.6
581.8
581.3
581.0
579.7
+500
+400
+300
+200
+100
0
-100
-200
SMALL PILLARS
50
51
52
53
54
55
56
57
58
59
60
61
62
63
64
65
66
67
68
69