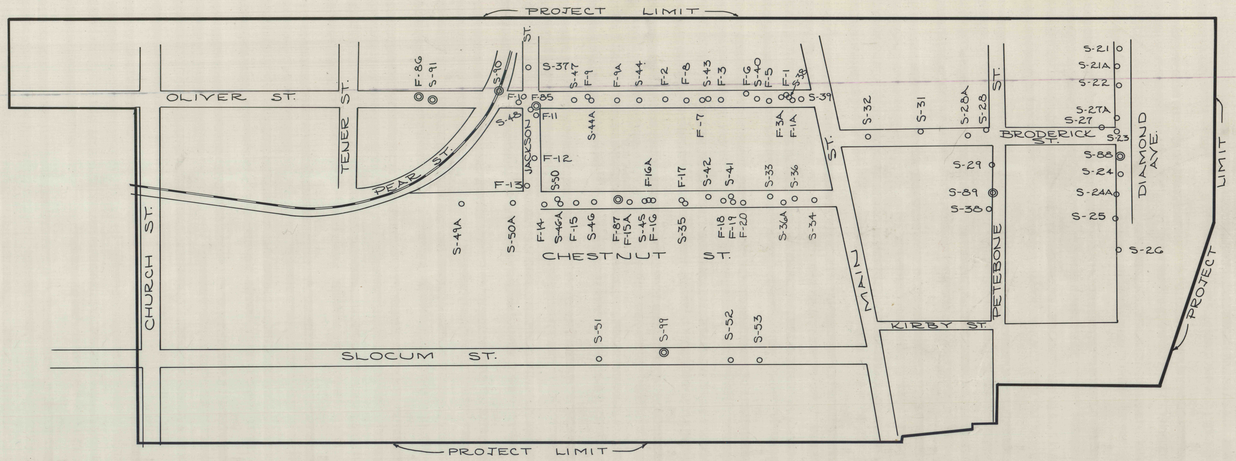

SURFACE FEATURES
SCALE: 1" = 100'

PROJECT ASP-15
EXPLORATORY BOREHOLES
ABANDONED HARRY E. COLL'Y
OLIVER ST. AREA
SWOYERSVILLE BOROUGH
LUZERNE COUNTY
PENNSYLVANIA

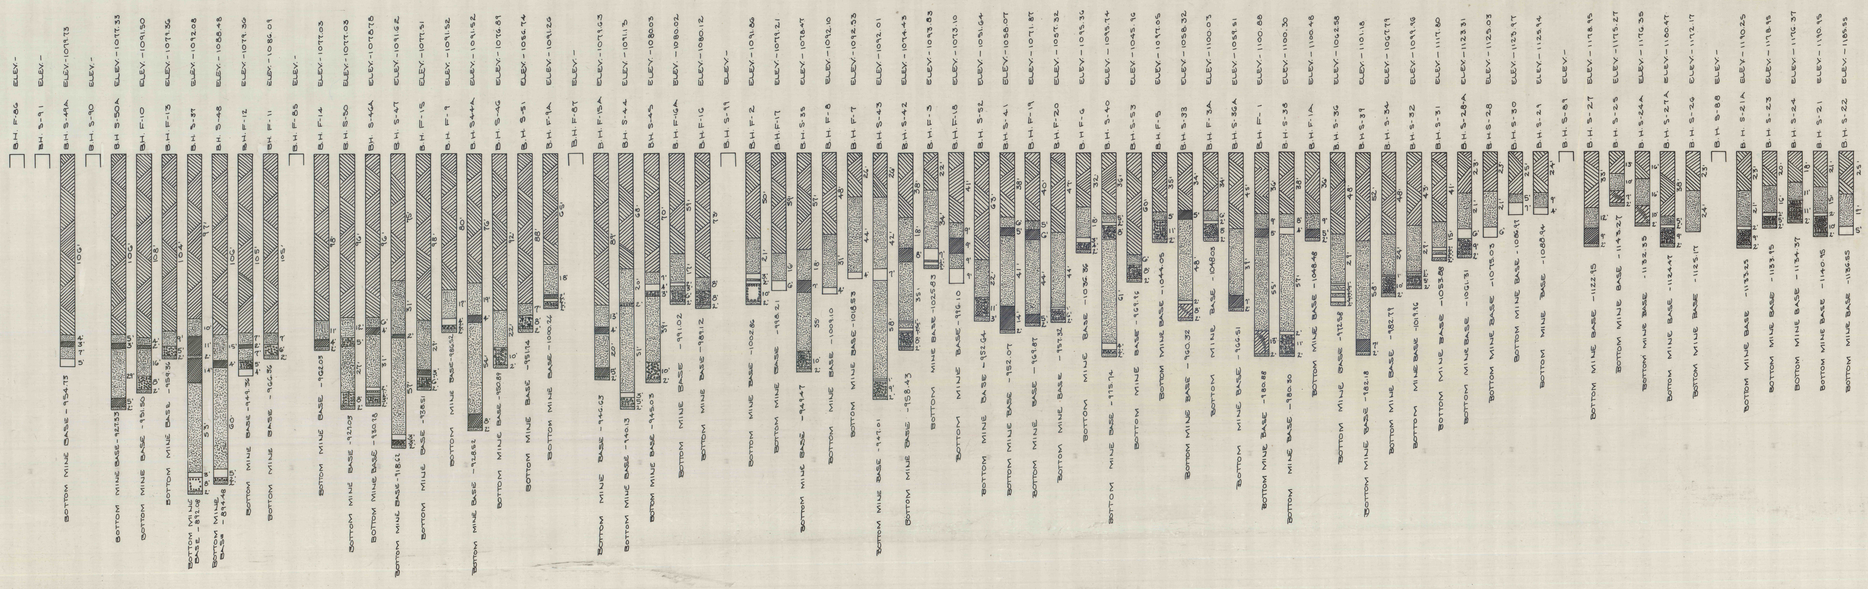

LEGEND

- WASH
- ROCK (SOLID)
- BROKEN ROCK
- COAL
- OPEN
- BROKEN ROCK & TIMBER
- BROKEN COAL
- BROKEN ROCK & OPEN
- BROKEN ROCK & COAL

SCALE:
VERT: 1" = 20'

NOTE: ALL ELEVATIONS REFER TO MINE BASE