


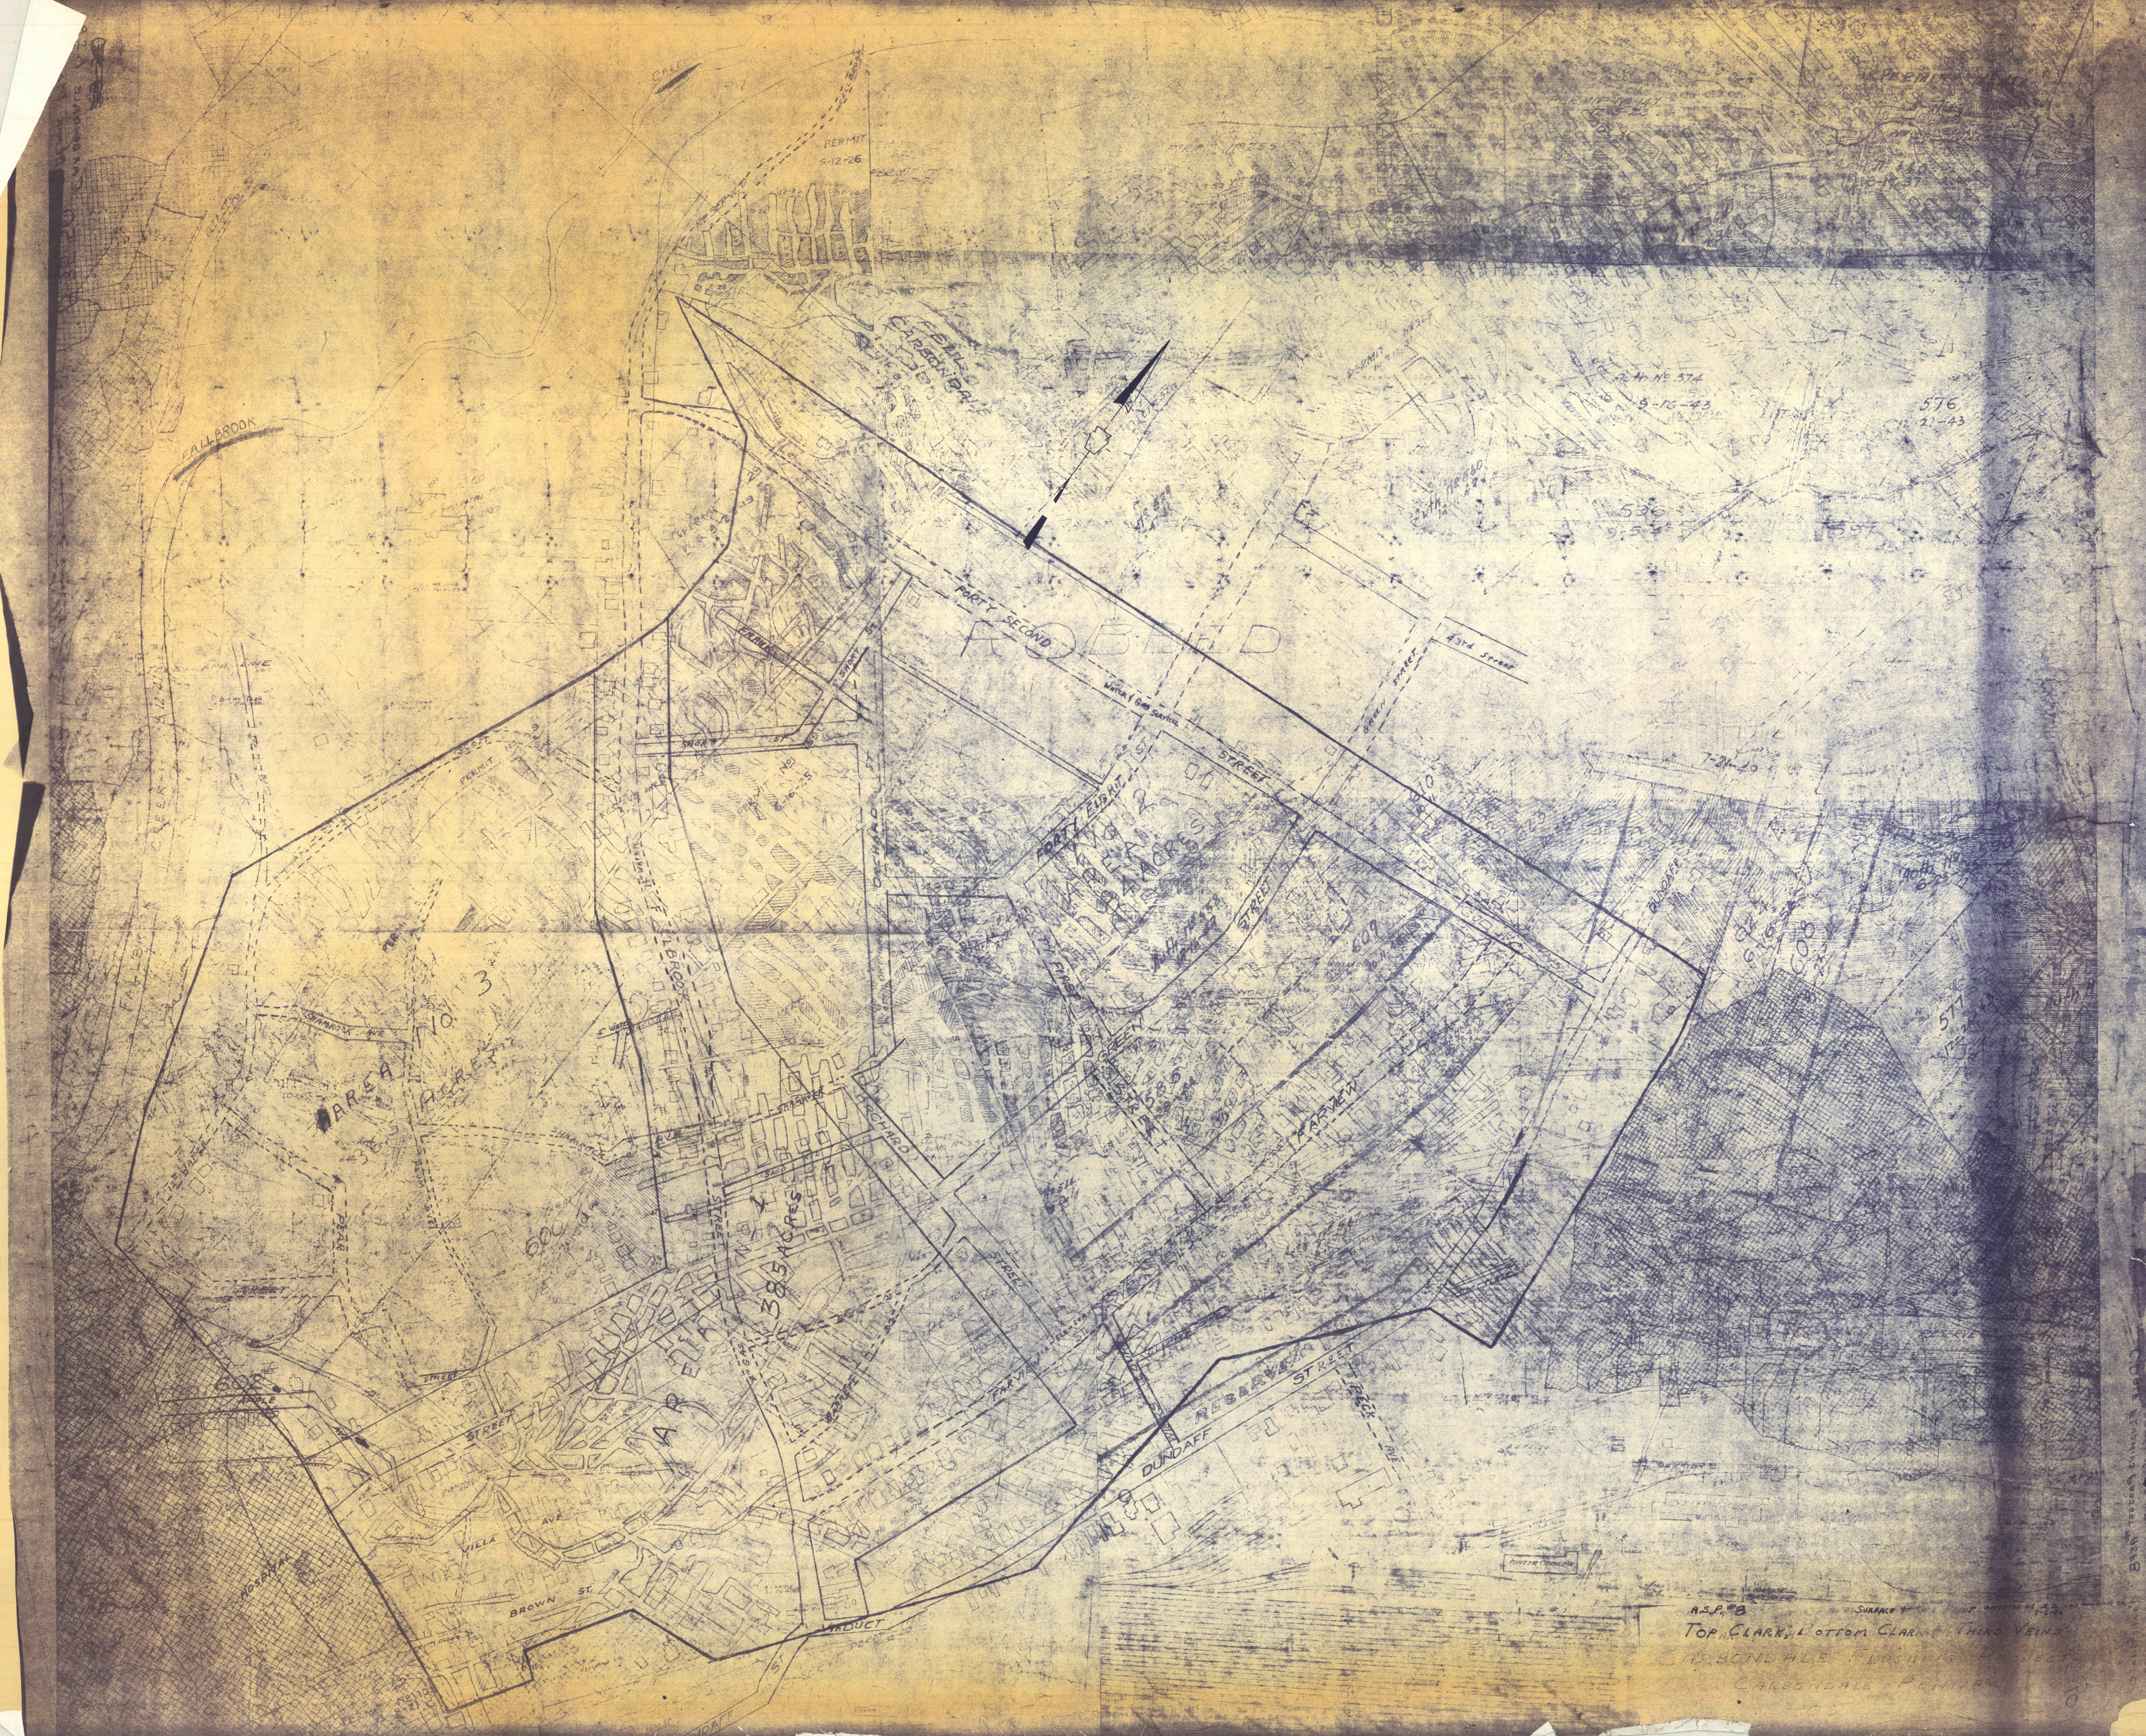

ASP. B
TOP CLARK, BOTTOM CLARK, THIRD VEINS
CARBON DALE, PENNSYLVANIA
CARBON DALE, PENNA.