


SECTION No 5
100 EASTWICK VEIN

No 16 TOP BALTIMORE VEIN

NOTTINGHAM & GAYLORD TOP BALTIMORE

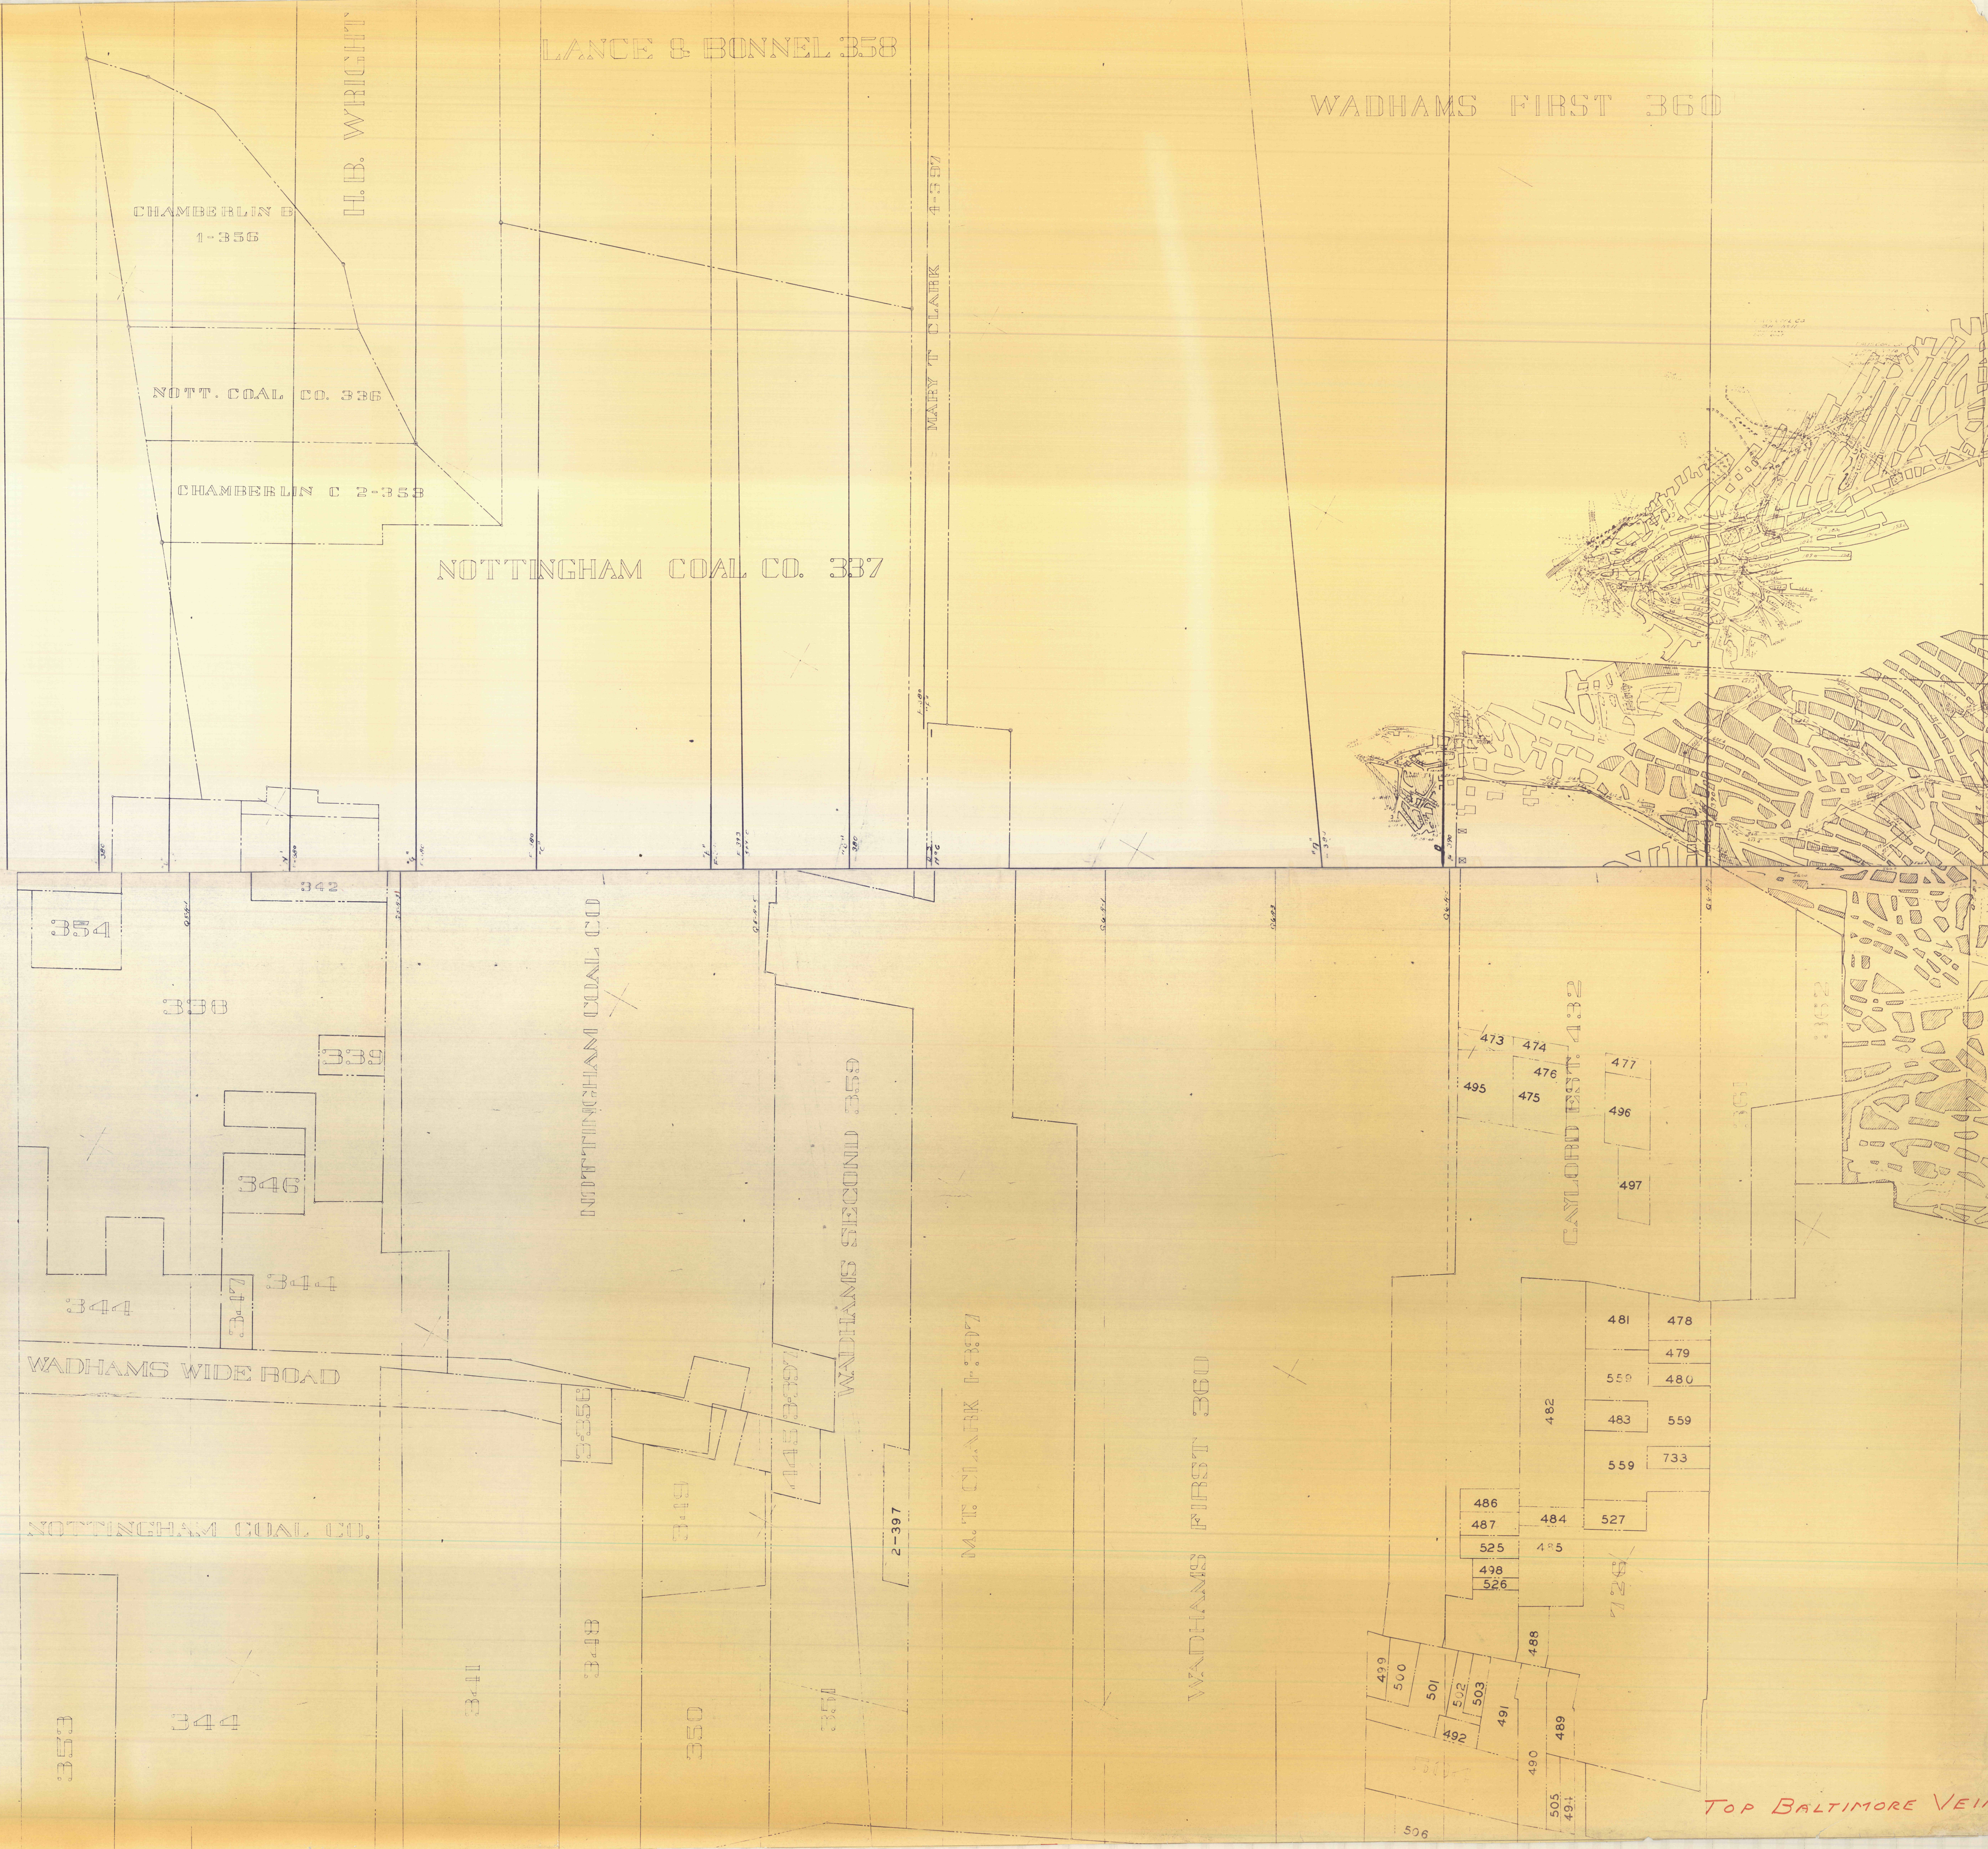

LANCE & BONNEL 358

WADHAMS FIRST 360

H.B. WRIGHT

CHAMBERLIN B
1-356

NOTTINGHAM COAL CO. 336

CHAMBERLIN C 2-358

NOTTINGHAM COAL CO. 337

MARY T CLARK 4-397

334

338

339

346

344

347

344

WADHAMS WIDE ROAD

NOTTINGHAM COAL CO.

353

344

341

348

350

351

NOTTINGHAM COAL CO.

WADHAMS SECOND 359

M. T. CLARK 4-397

2-397

WADHAMS FIRST 360

GAYLORD EST. 432

473	474	477
495	475	496
		497

481	478
482	479
559	480
483	559
559	733
486	484
487	527
525	485
498	
526	

499	488
500	490
501	489
502	491
503	
492	
506	
491	
490	
505	
494	

TOP BALTIMORE VEIN