


D-12

C-15

100

C-15

D-12

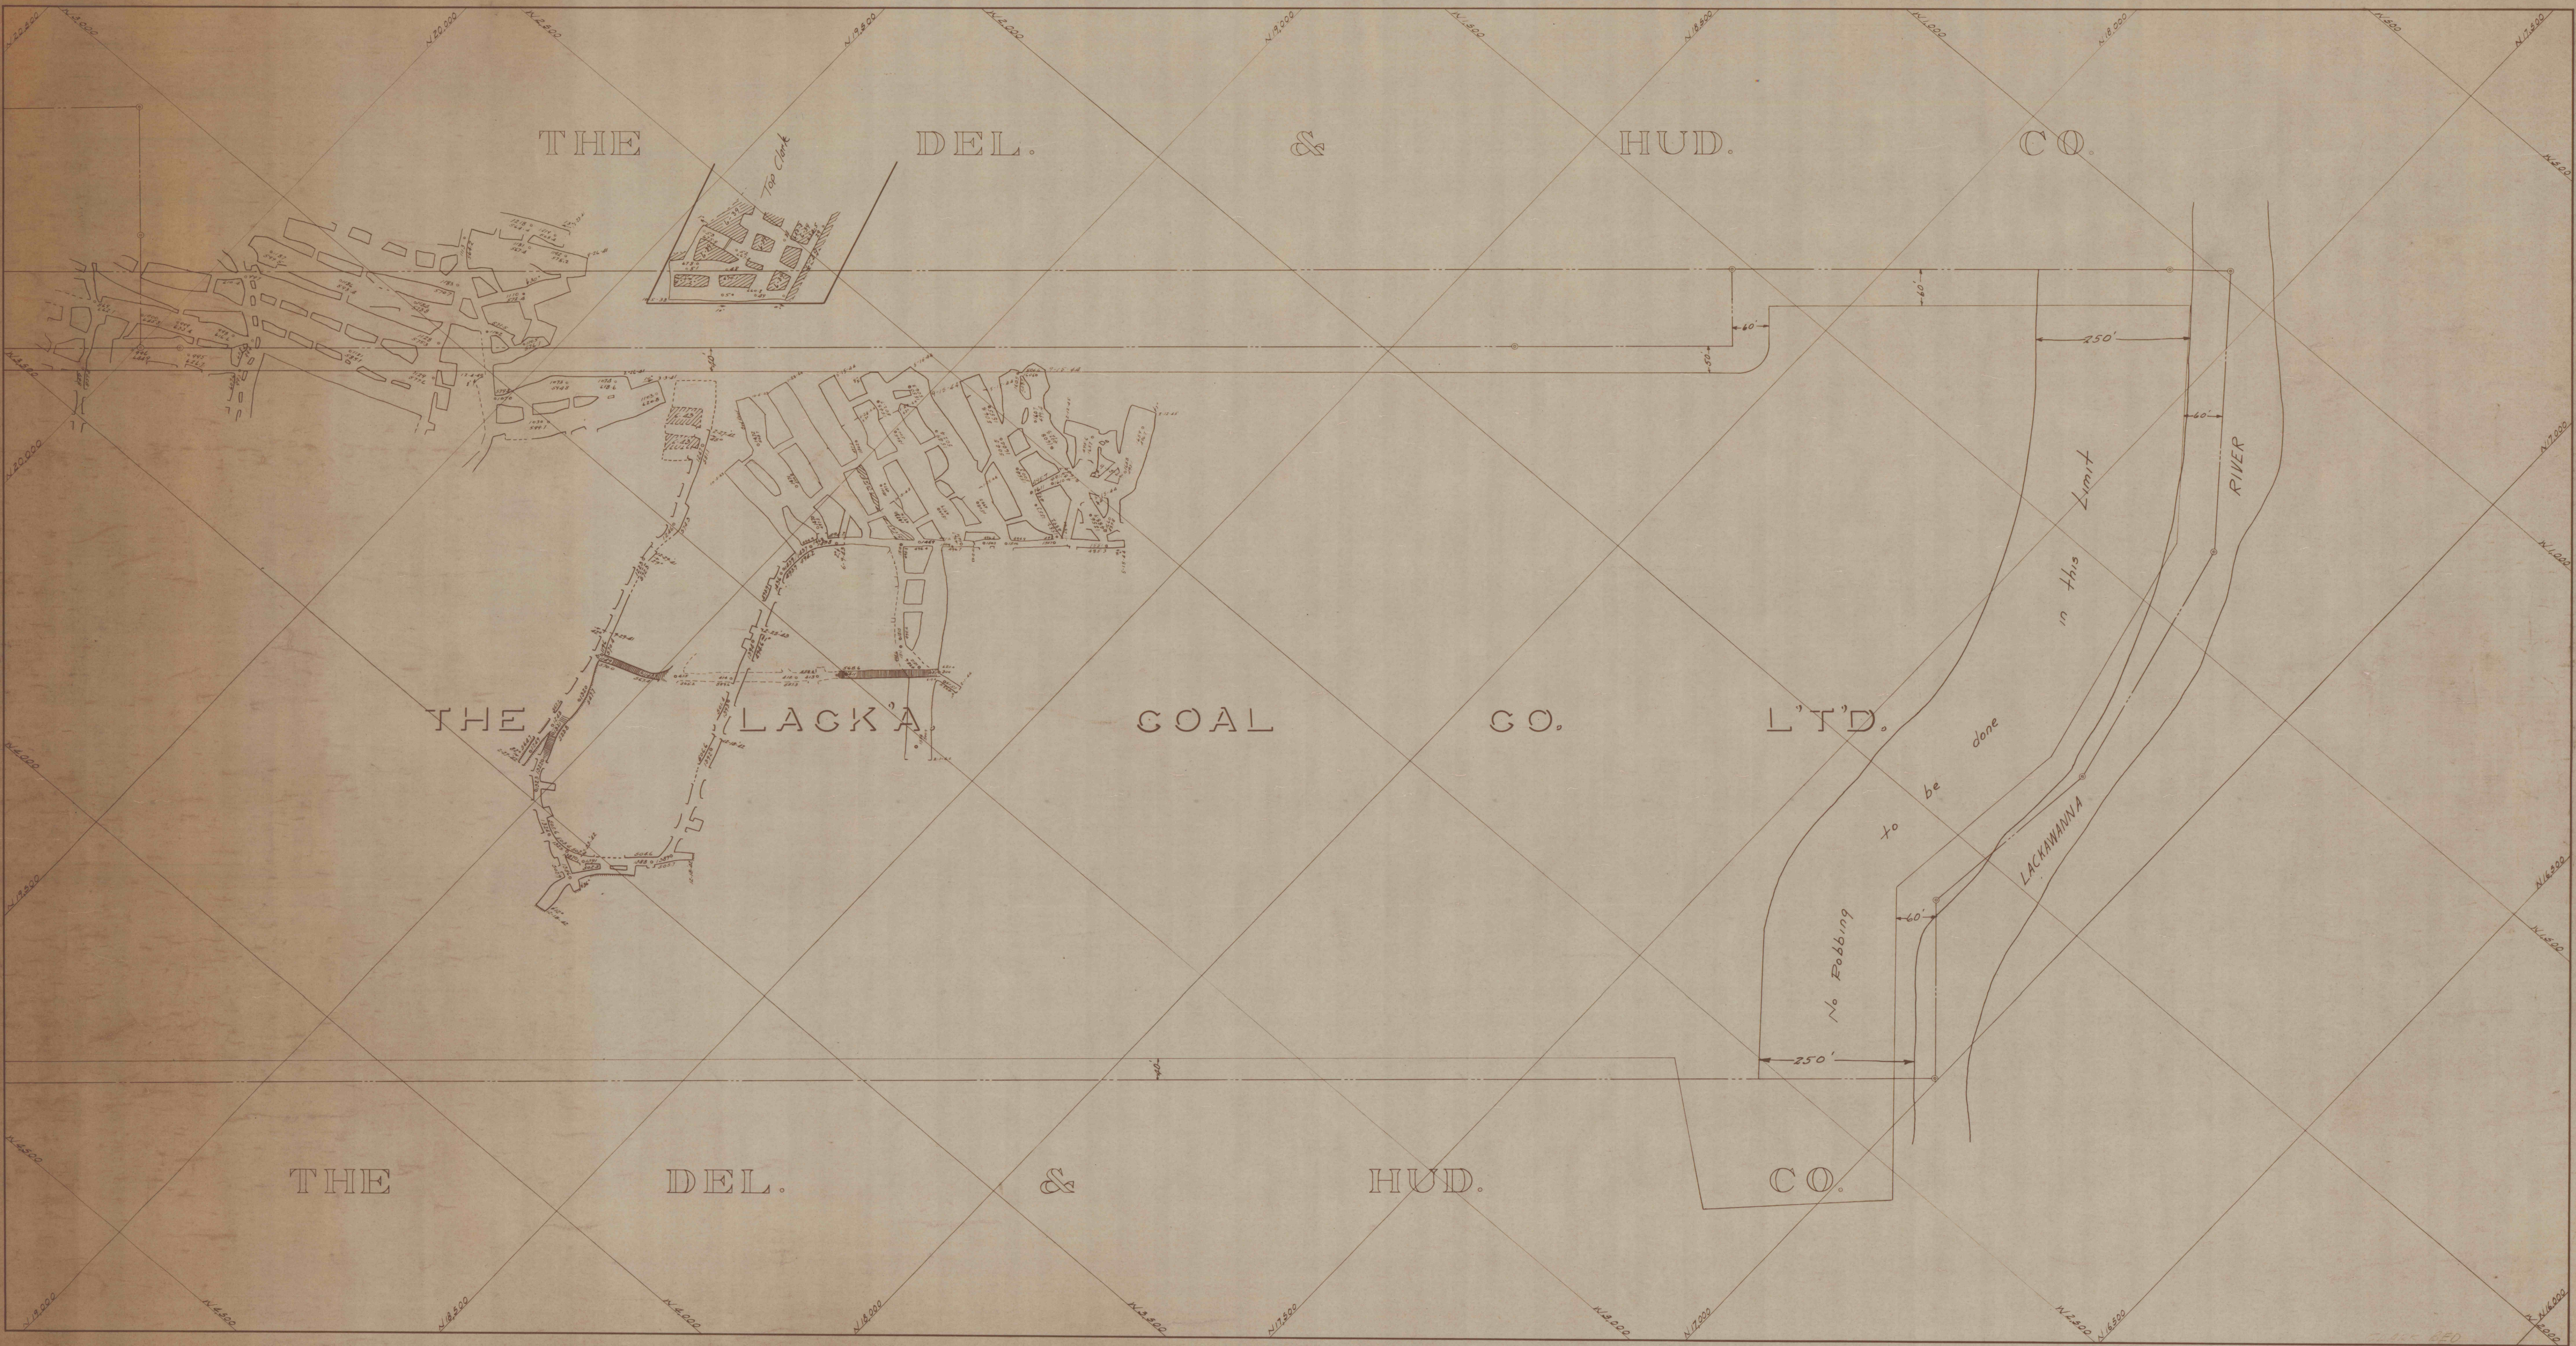

C-15

C-15