Q-5-B-6

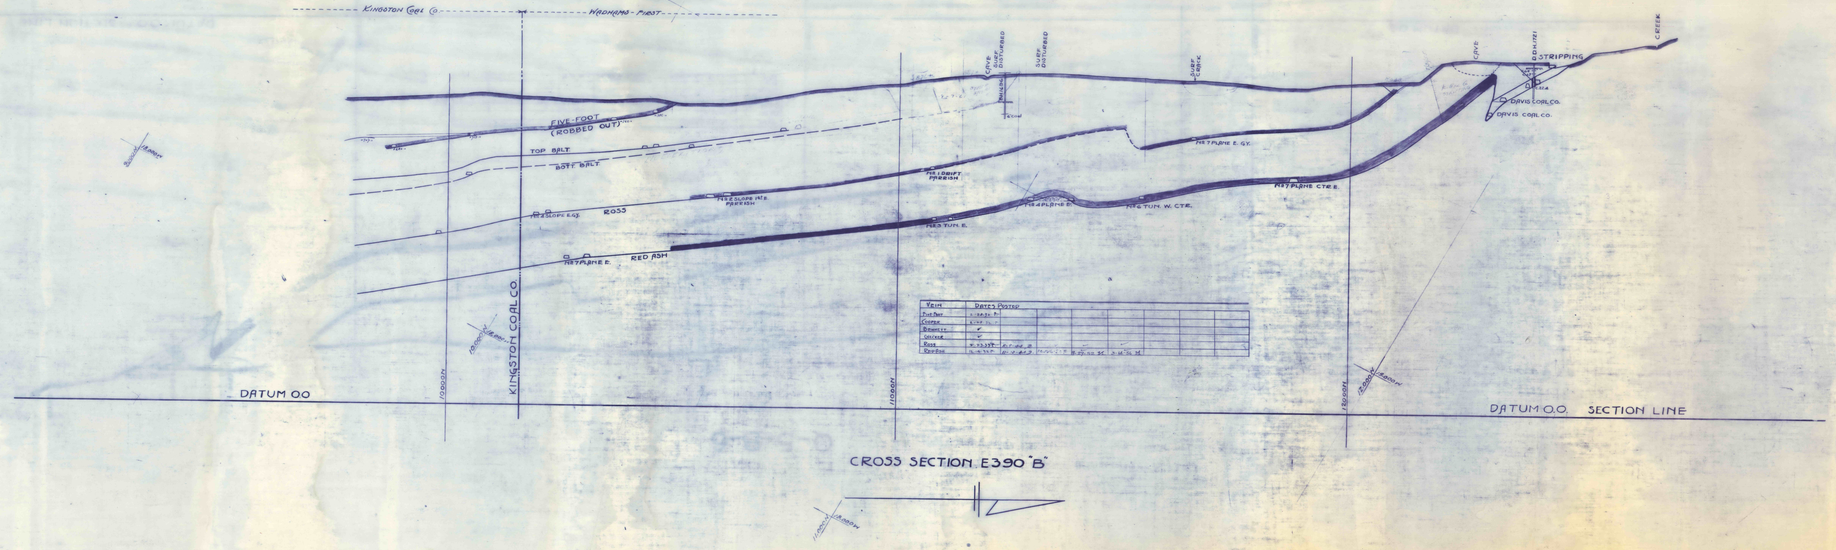

CROSS SECTION E390 "B"

E-390-B Q-2-B-6