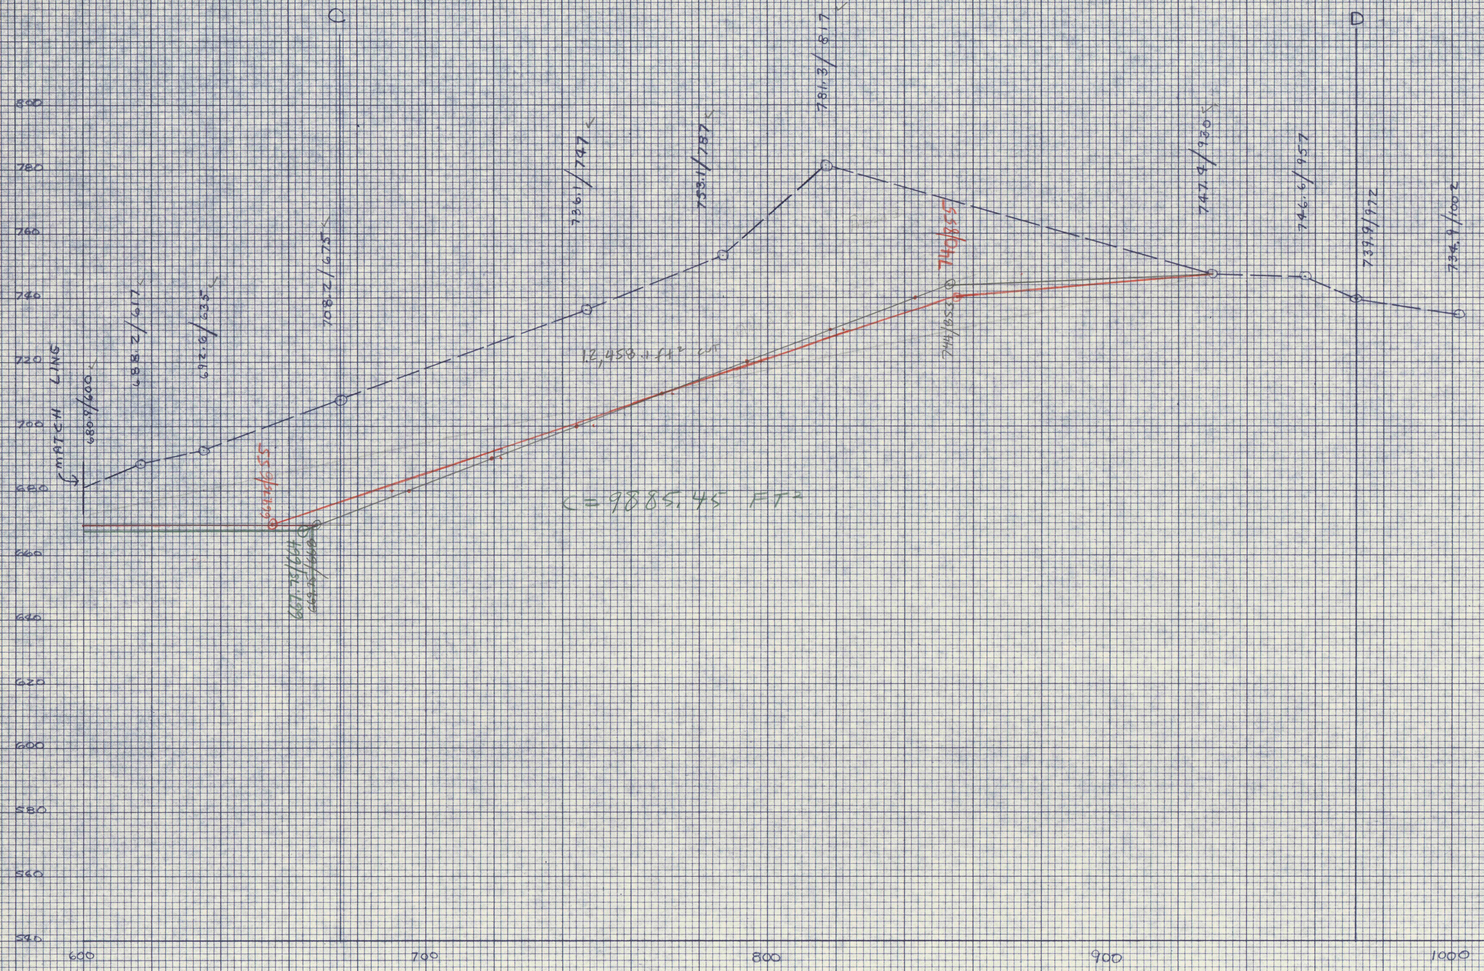
C
D
