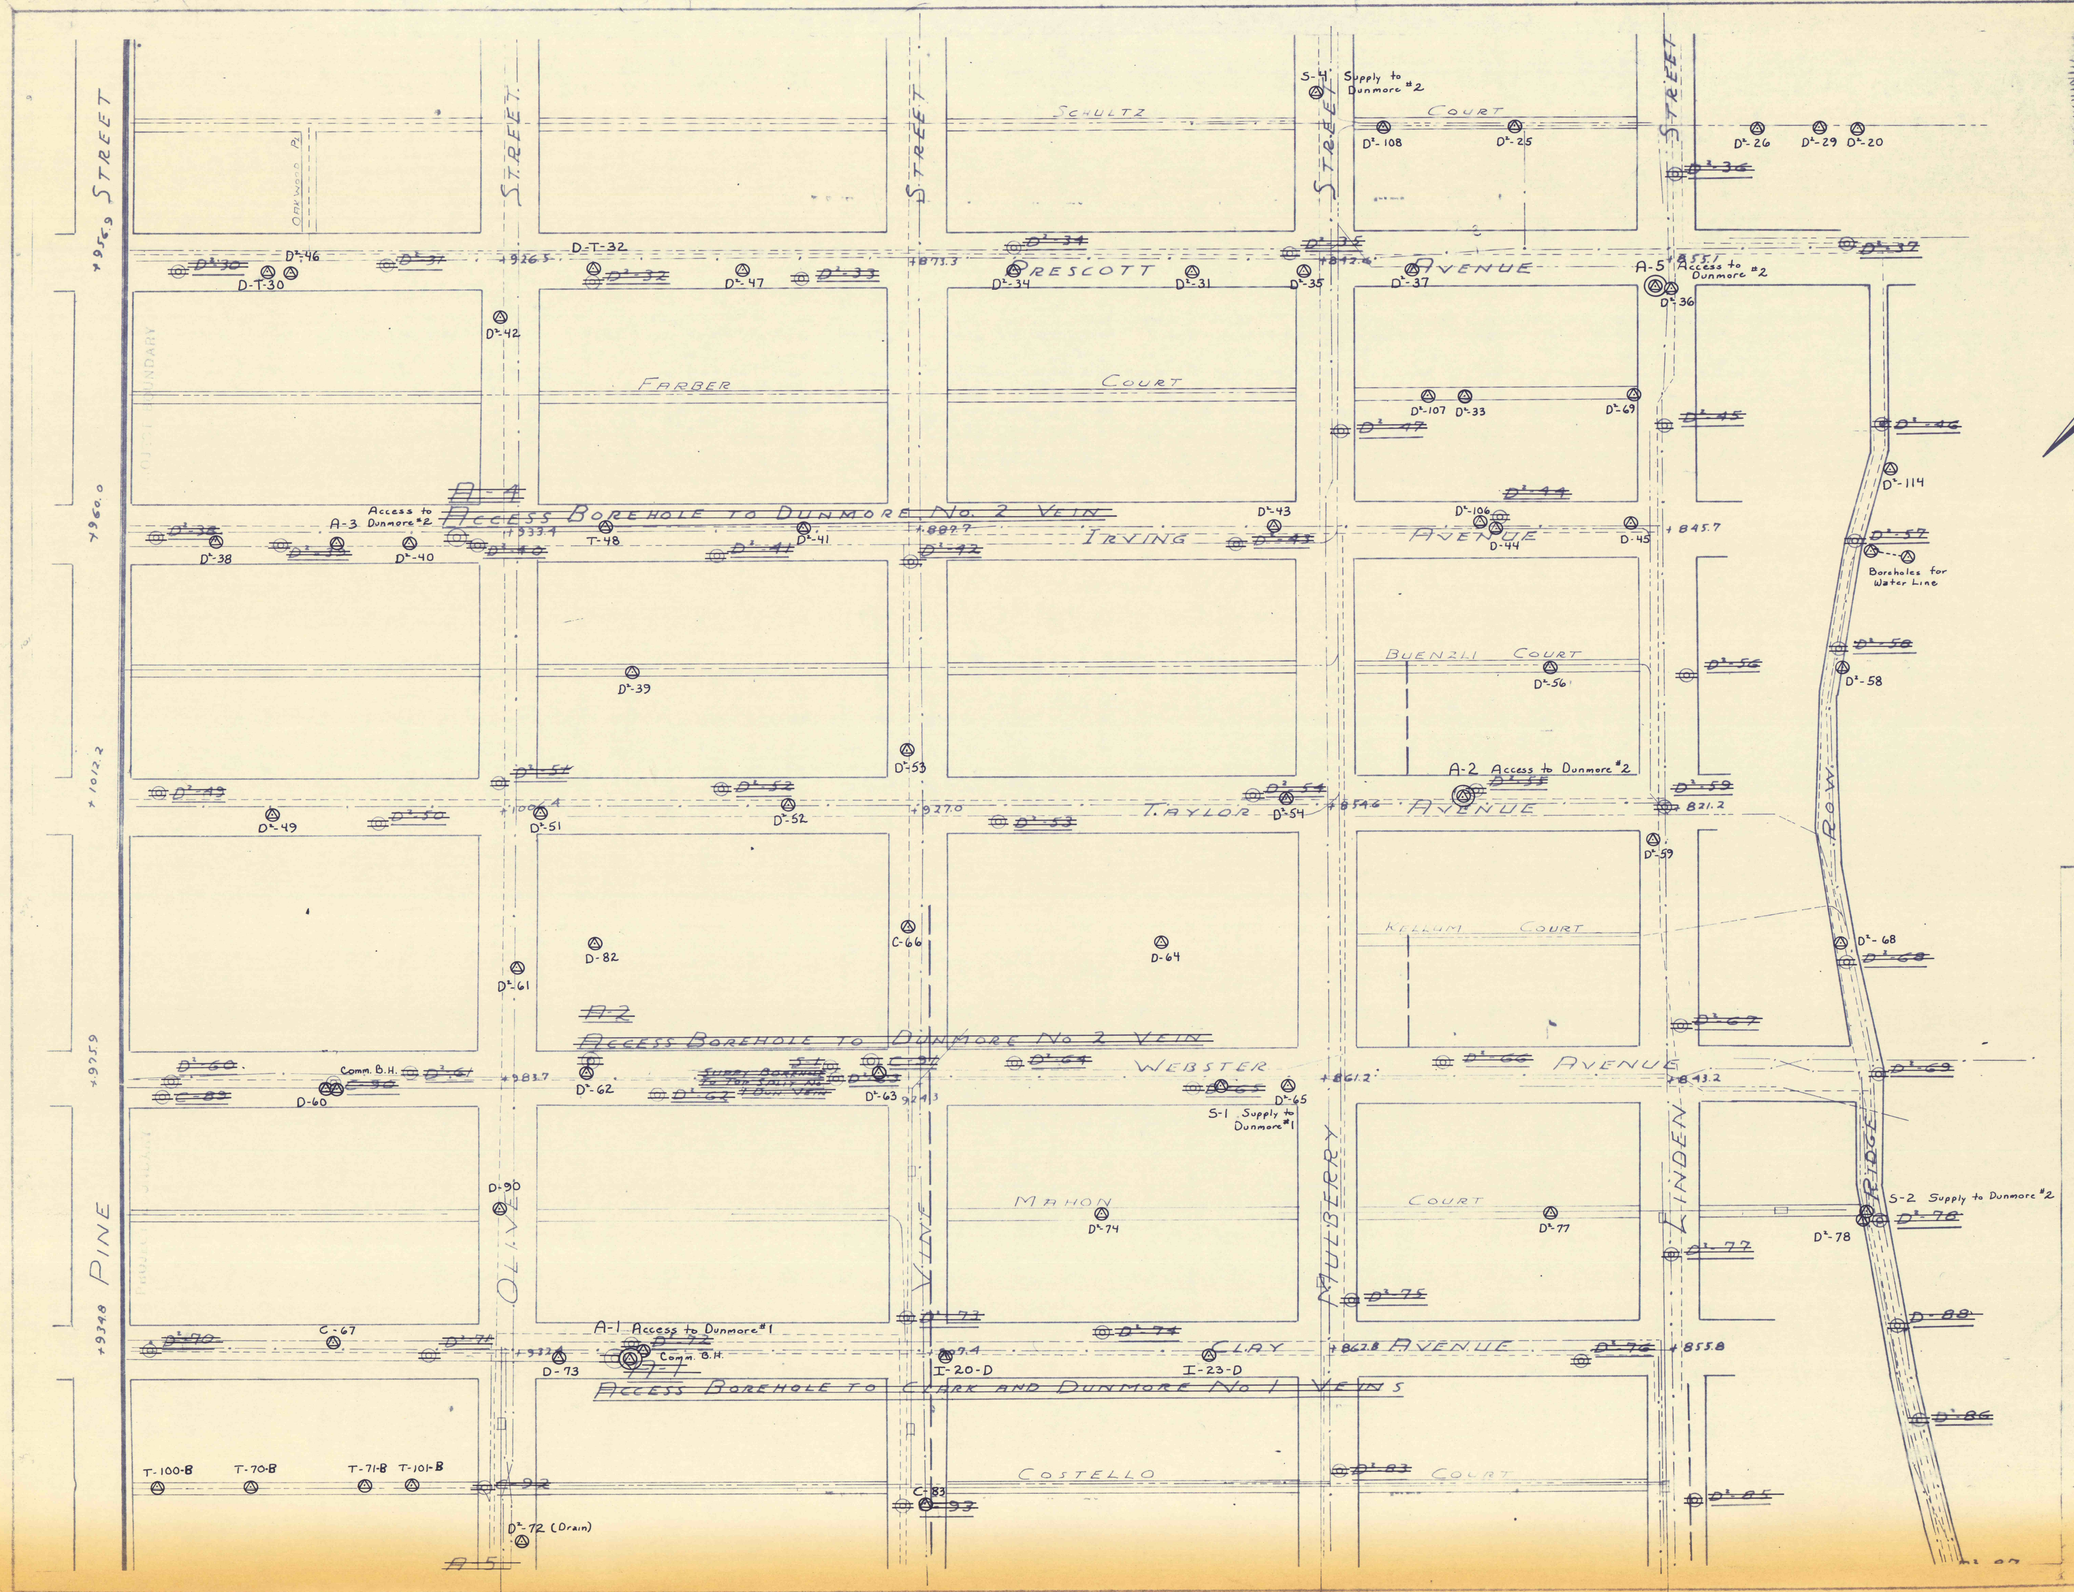

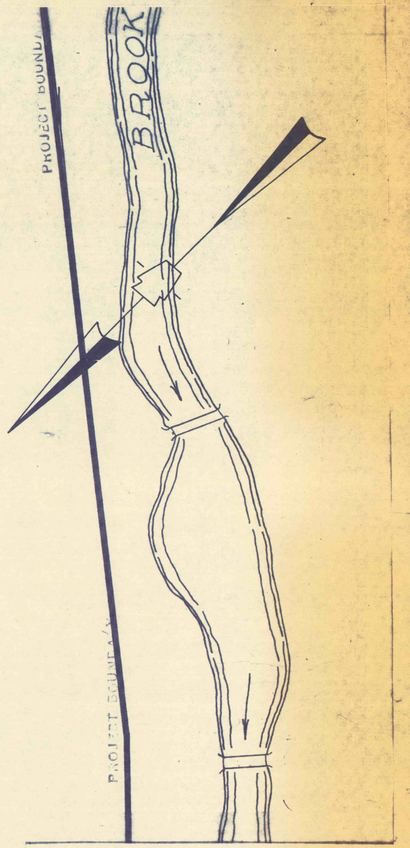

B - Blind Flush Borehole
I - Injection Borehole
Δ - Relocated or Additional
⊕ - Deleted Borehole

NO	DATE	REVISION	APPR

S. E. Kyle for V. M. Beard

(SEALS)

COMMONWEALTH OF PENNSYLVANIA
DEPARTMENT OF ENVIRONMENTAL RESOURCES
OFFICE OF RESOURCES MANAGEMENT

PROJECT NO ASP-12-2

TITLE
HYDRAULIC FLUSHING PROJECT
HILL SECTION (PHASE II)
SCRANTON, LACKAWANNA COUNTY

SHEET DESCRIPTION PLAN
SURFACE (Middle Section)
PINE BROOK MINE

1" = 100'

DRAWING
2 of 14