


PINEBROOK COLLIERY
CLARK VEIN



<input checked="" type="checkbox"/> - Relocated or Additional <input checked="" type="checkbox"/> - Deleted Boreholes	
NO. DATE	REVISION
SUBMITTED	
(SEALS) COMMONWEALTH OF PENNSYLVANIA DEPARTMENT OF ENVIRONMENTAL RESOURCES OFFICE OF RESOURCES MANAGEMENT	
PROJECT NO ASP-12-2	
TITLE	
HYDRAULIC FLUSHING PROJECT HILL SECTION (PHASE II) SCRANTON, LACKAWANNA COUNTY	
SHEET DESCRIPTION PLAN	
CLARK VEIN (South-Section) PINE BROOK MINE	
SCALE	DRAWING NO.
1" = 100'	4 of 14

Control Flushing
 Blind Flushing

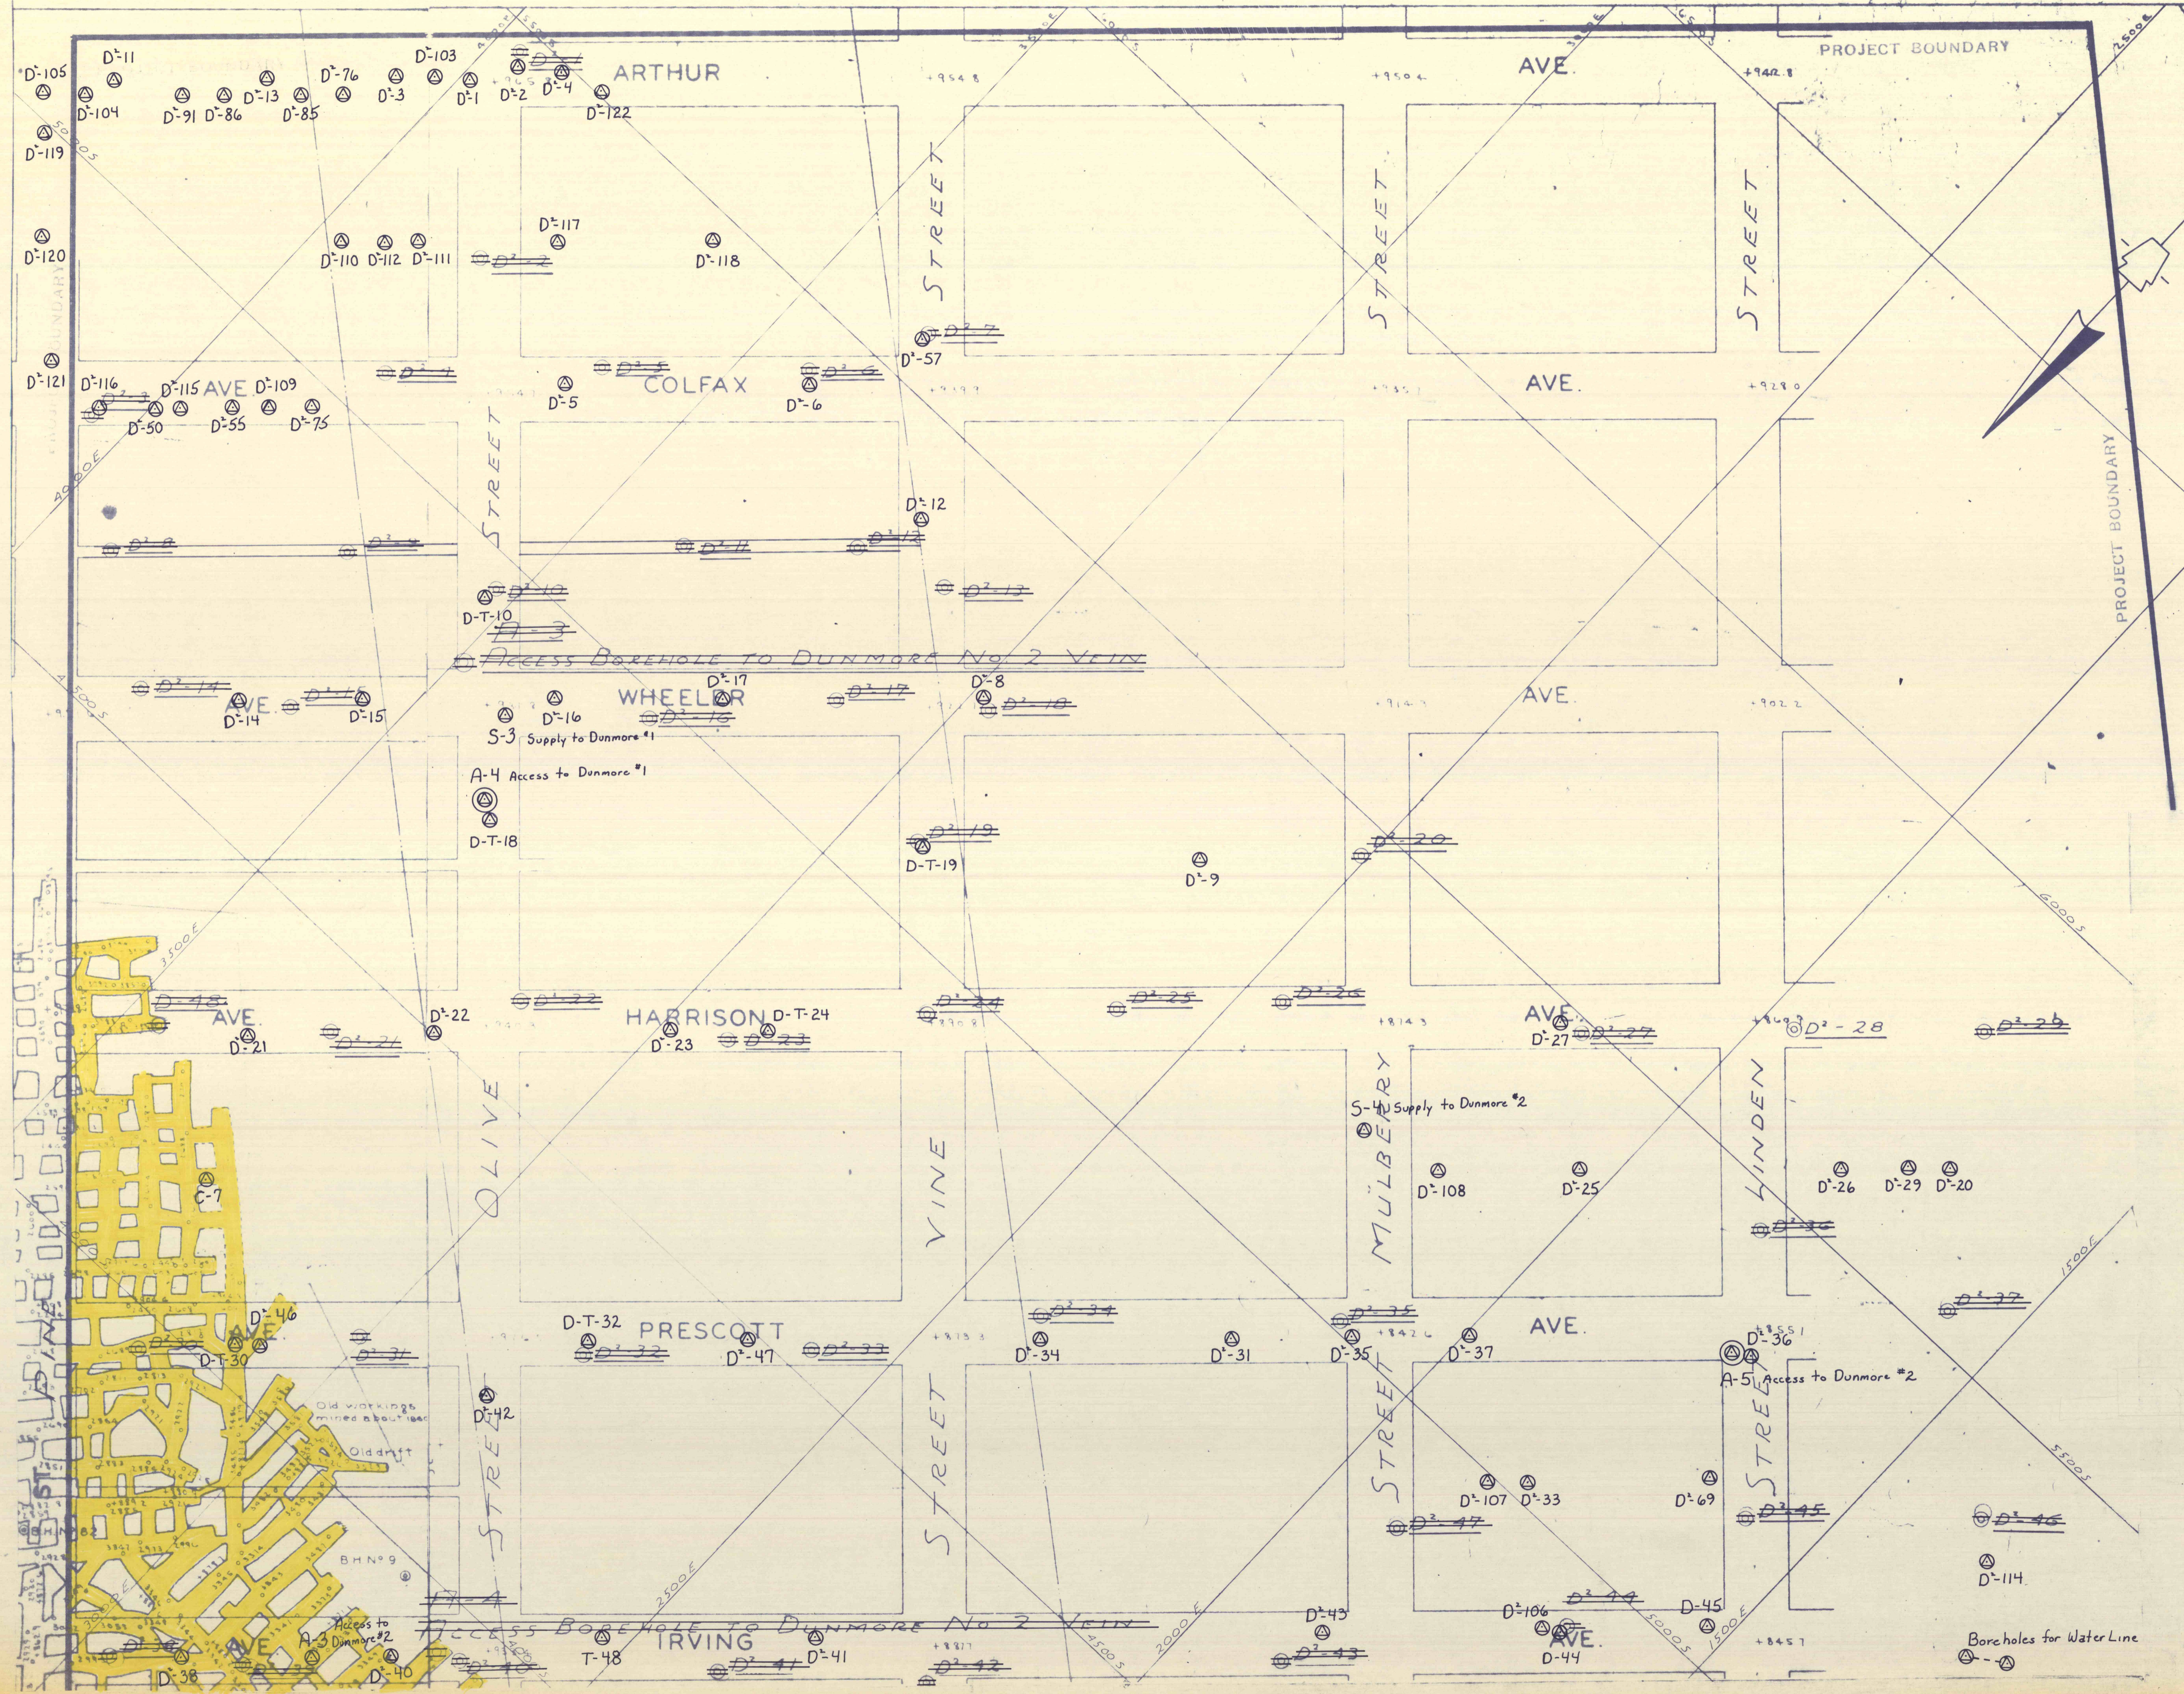