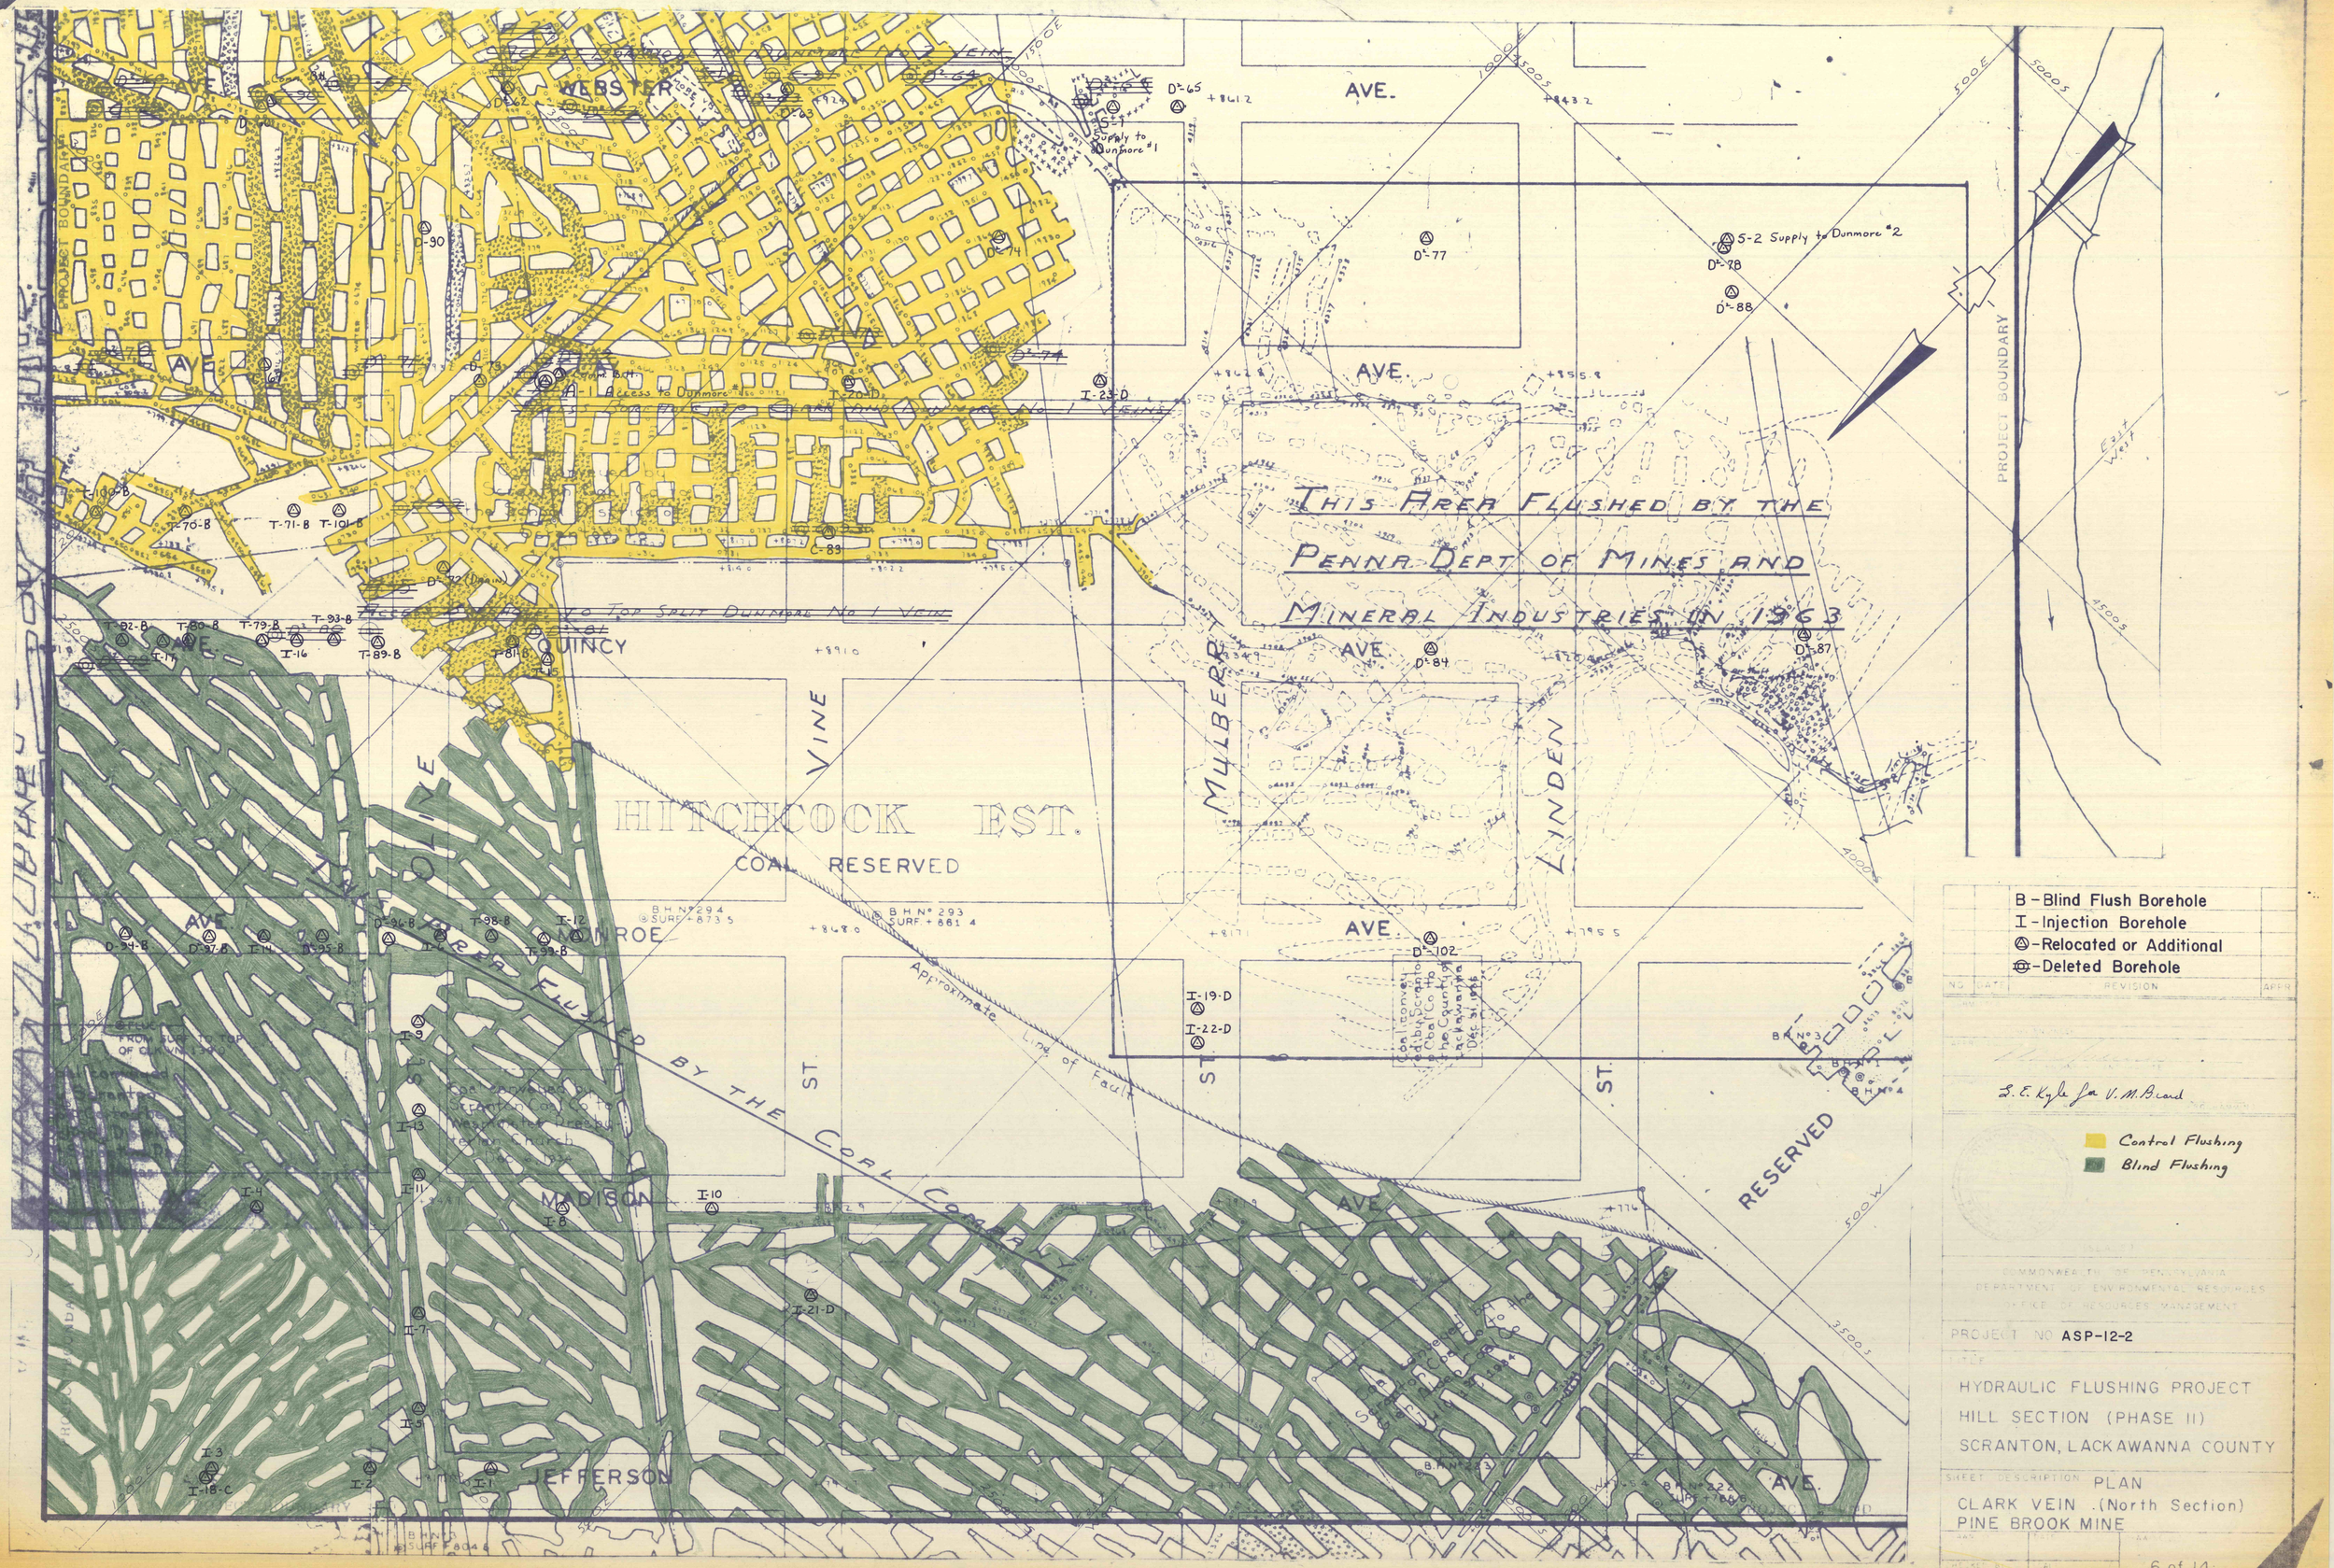

B – Blind Flush Borehole
I – Injection Borehole
⊘ – Relocated or Additional
⊜ – Deleted Borehole

NO.	DATE	REVISION	APP.

E. E. Kyle Jr. V. M. Brand

Control Flushing
Blind Flushing

COMMONWEALTH OF PENNSYLVANIA
DEPARTMENT OF ENVIRONMENTAL RESOURCES
OFFICE OF RESOURCES MANAGEMENT

PROJECT NO. ASP-12-2

TITLE
HYDRAULIC FLUSHING PROJECT
HILL SECTION (PHASE II)
SCRANTON, LACKAWANNA COUNTY

SHEET DESCRIPTION
PLAN
CLARK VEIN (North Section)
PINE BROOK MINE

SCALE 1" = 100'