


**THE DUNMORE NO-1
HILL SECTION
PINE BROOK
COLLIERY
SCRANTON COAL
CO.**

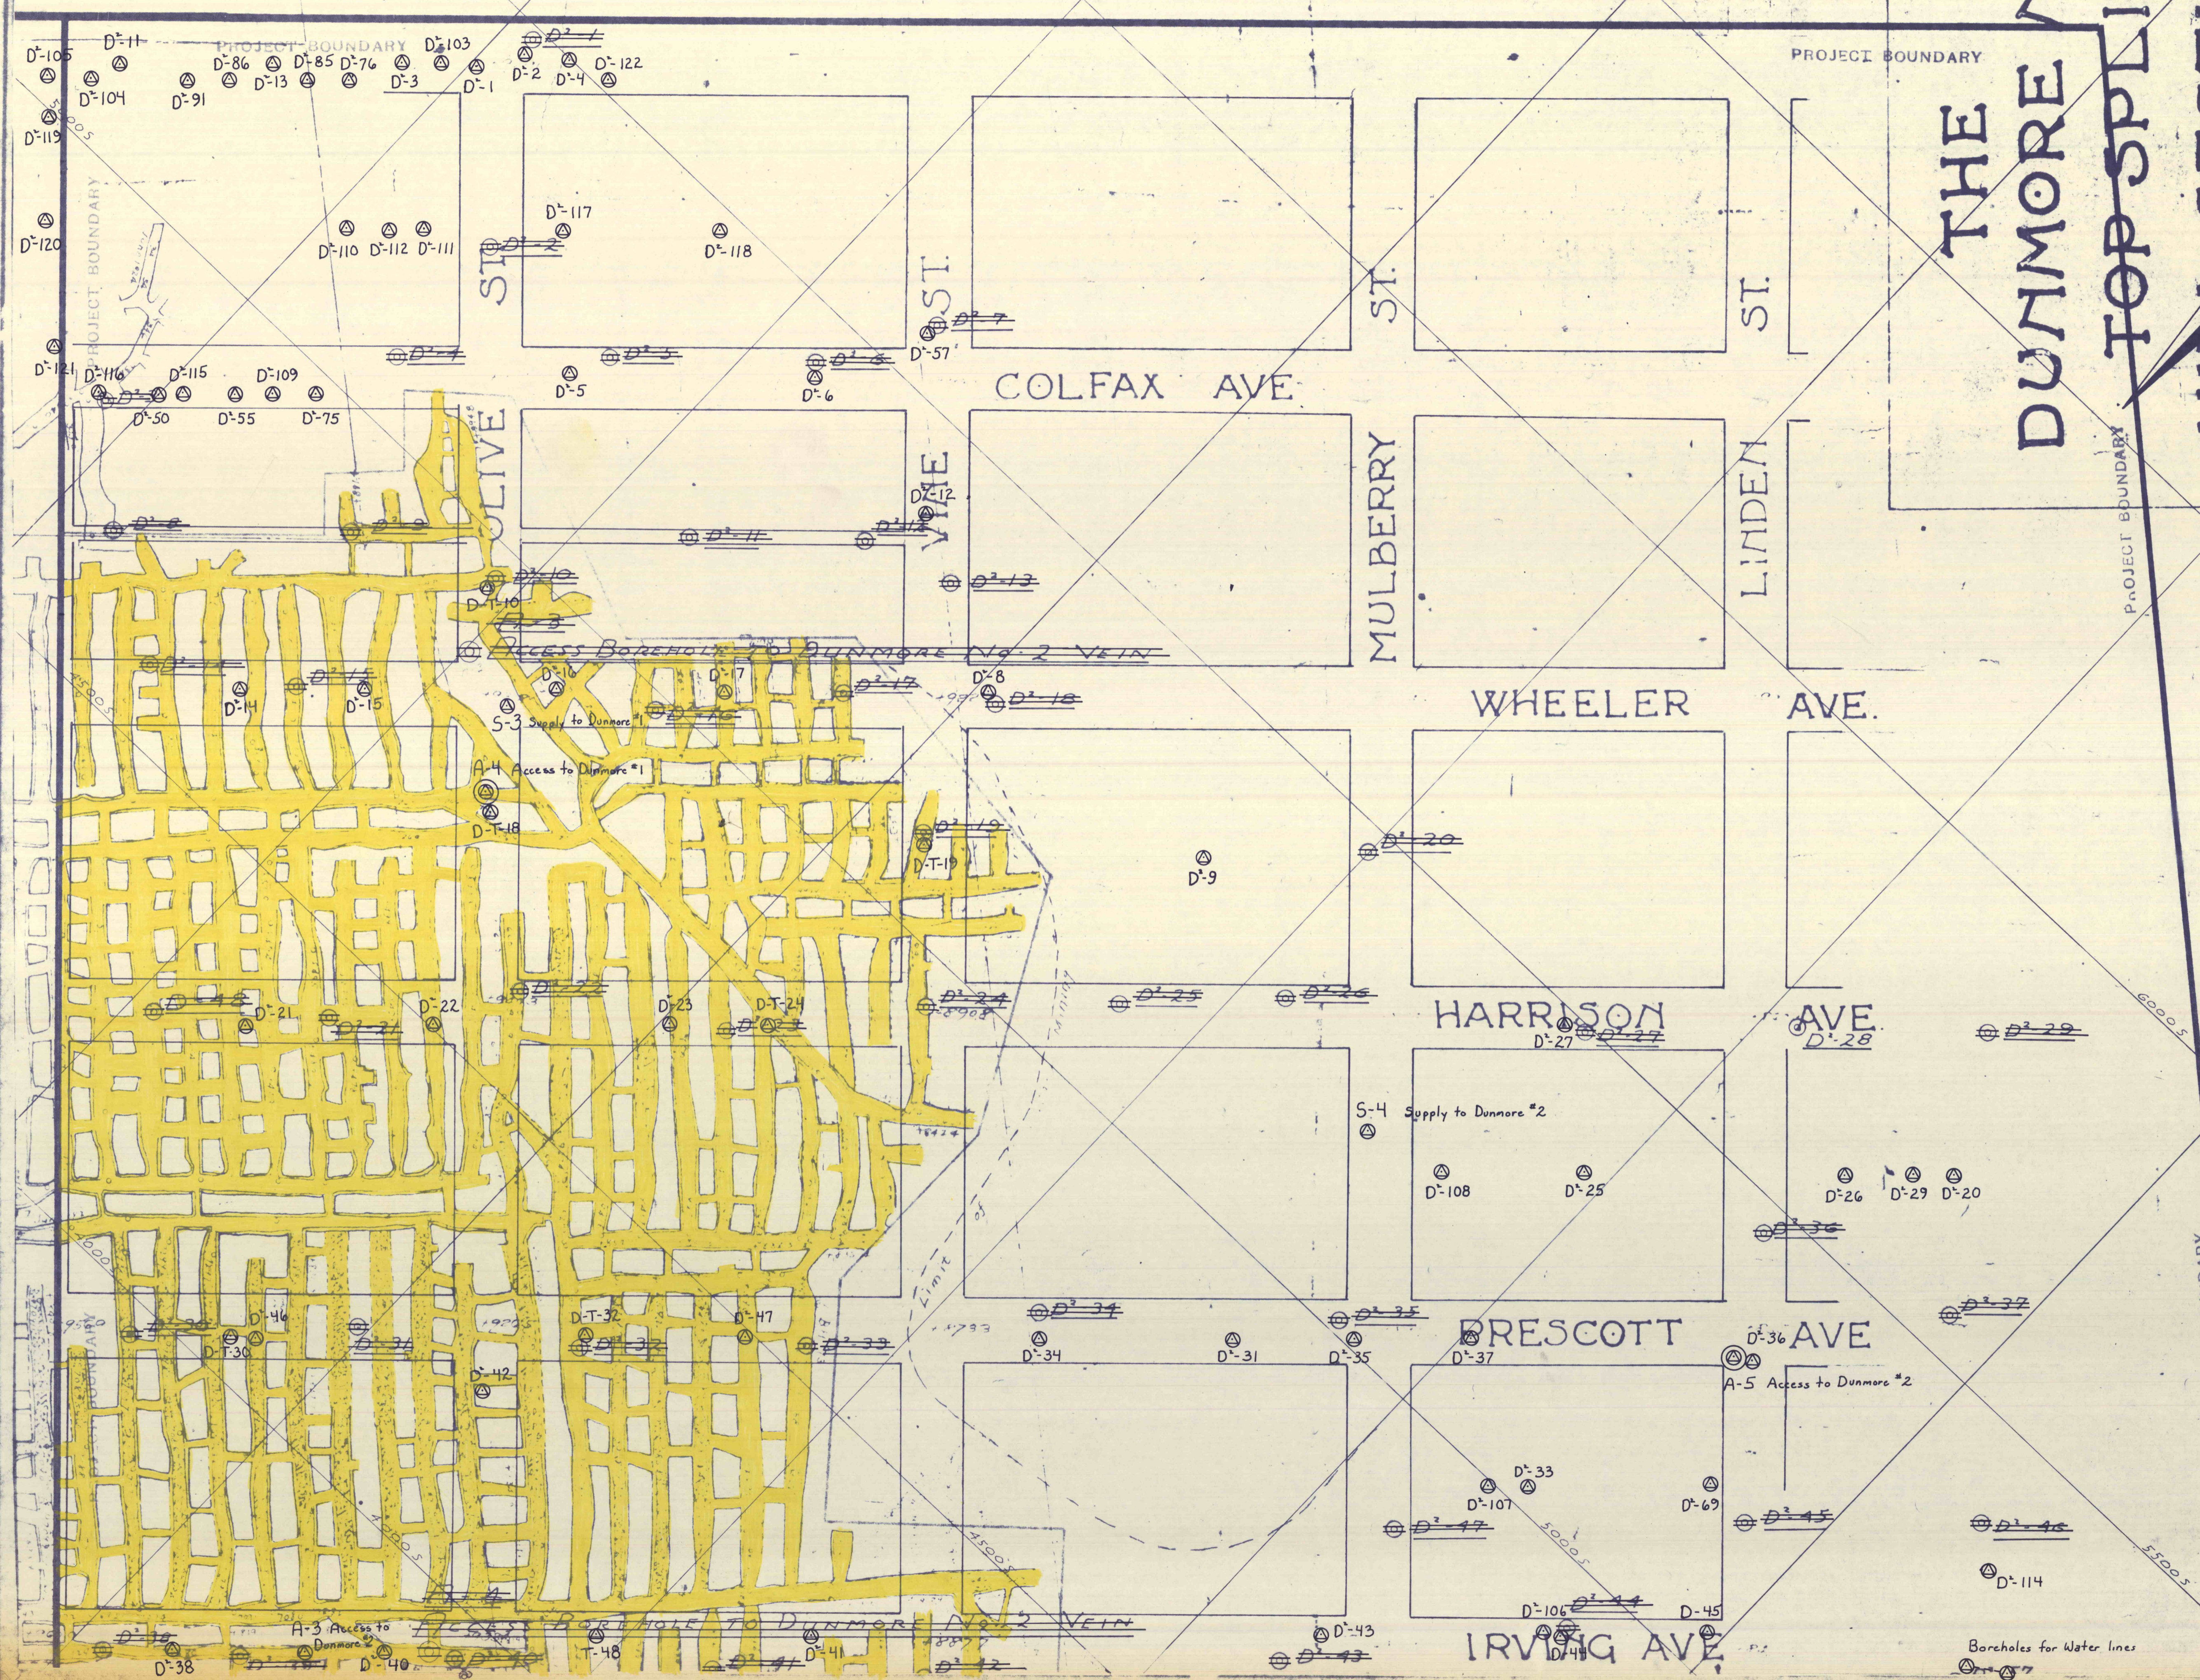

⊕ - Relocated or Additional ⊖ - Deleted Borehole			
NO.	DATE	REVISION	APPR.
SUBMITTED			
DESIGN ENGINEER			
APPROVED <i>M. J. ...</i>			
DISTRICT ENGINEER ANTIHACITE			
APPROVED <i>S. E. Kyle for U.M. Beard</i>			
TITLE: 4-B REVENUE RESOURCES PROGRAMMING			
		■ Control Flushing ■ Blind Flushing	
(SEALS)			
COMMONWEALTH OF PENNSYLVANIA DEPARTMENT OF ENVIRONMENTAL RESOURCES OFFICE OF RESOURCES MANAGEMENT			
PROJECT NO. ASP-12-2			
TITLE HYDRAULIC FLUSHING PROJECT HILL SECTION (PHASE II) SCRANTON, LACKAWANNA COUNTY			
SHEET DESCRIPTION PLAN NO. 1 DUNMORE VEIN (Top Split) PINE BROOK MINE (South Section)			
DRAWN BY	DATE	CHECKED BY	SCALE
			1" = 100'
			7 of 14