





NOTES:
 1. For Location Map, Vicinity Map and General Notes See Dwg. No. 2 of 5.

REFERENCES:
 1. Cross Sections-----Dwg. No. 4 of 5
 2. Profile and Details-----Dwg. No. 5 of 5

RED - DELETED WORK
GREEN - REVISED WORK
 DELETIONS AND REVISIONS ARE REQUIRED TO ELIMINATE WORK ON THE PROPERTY OF SILVERBROOK ANTHRACITE AS REQUIRED BY SILVERBROOK ANTHRACITE

BENCH MARK DATA

BM No.	ELEV	DESCRIPTION	N. COORDINATE	E. COORDINATE
3-1	1201.73	5/8" Rebar with Cap	4070.00	24952.00
3-2	1178.69	5/8" Rebar with Cap	5368.64	25011.50

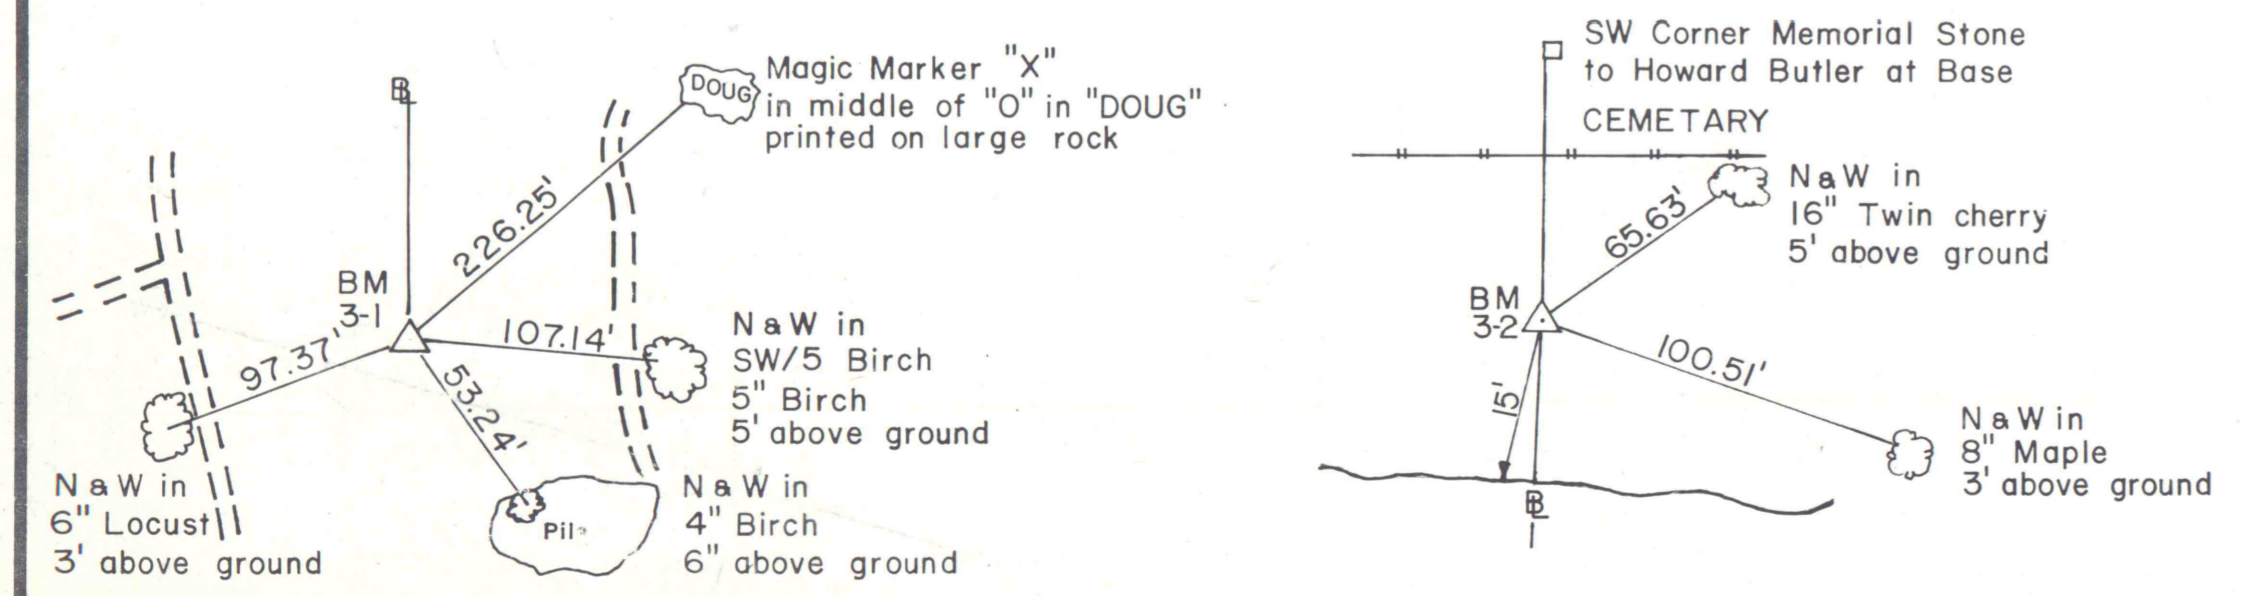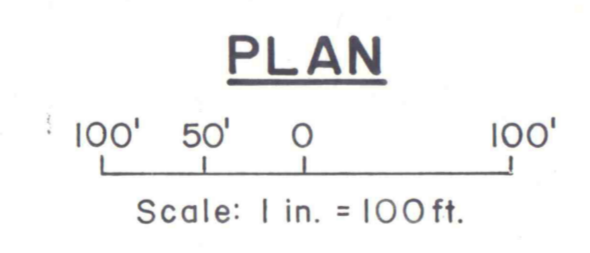

CONSTRUCTION BASELINE CONTROL DATA

NO.	DATE	REVISION	APPR.
SUBMITTED	B.P.R.		
PROJECT CO-ORDINATOR			
APPROVED	C. C. Rainey		
CHIEF-DIVISION OF ACID MINE DRAINAGE ABATEMENT			
APPROVED	Robert J. [Signature]		
DIRECTOR-BUREAU OF ABANDONED MINE RECLAMATION			
COMMONWEALTH OF PENNSYLVANIA DEPARTMENT OF ENVIRONMENTAL RESOURCES OFFICE OF RESOURCES MANAGEMENT			
CONTRACT NO. BF 81-101.1			
BOND FORFEITURE RECLAMATION PROJECT NORTHWEST MINING COMPANY INC. MINING PERMIT NO. AN 81-7(C)			
CITY OF CARBONDALE		LACKAWANNA CO., PA.	
PLAN			
DRAWN BY	L.W.G.	DATE	8-15-86
CHECKED BY	D.A.K.	SCALE	As shown
		DRAWING NO.	3 of 5

ALL DIMENSIONS AND EXISTING CONDITIONS SHALL BE CHECKED AND VERIFIED BY CONTRACTOR AT THE SITE.