



CUT LT = 215 x 20 = 4300 SF  
 150 x 20 = 3000 SF (Estimate #1)  
 (400) 1,300 remaining

FLL = 5 x 20 = 100 SF

175 x 20 = 3500 SF (Estimate #2)  
 500 remaining

CUT LT = 170 x 20 = 3400 SF  
 99 x 20 = 1980 SF (Estimate #1)  
 (105) 1,420 remaining

125 x 24 = 3000 SF (Estimate #2)  
 900 remaining

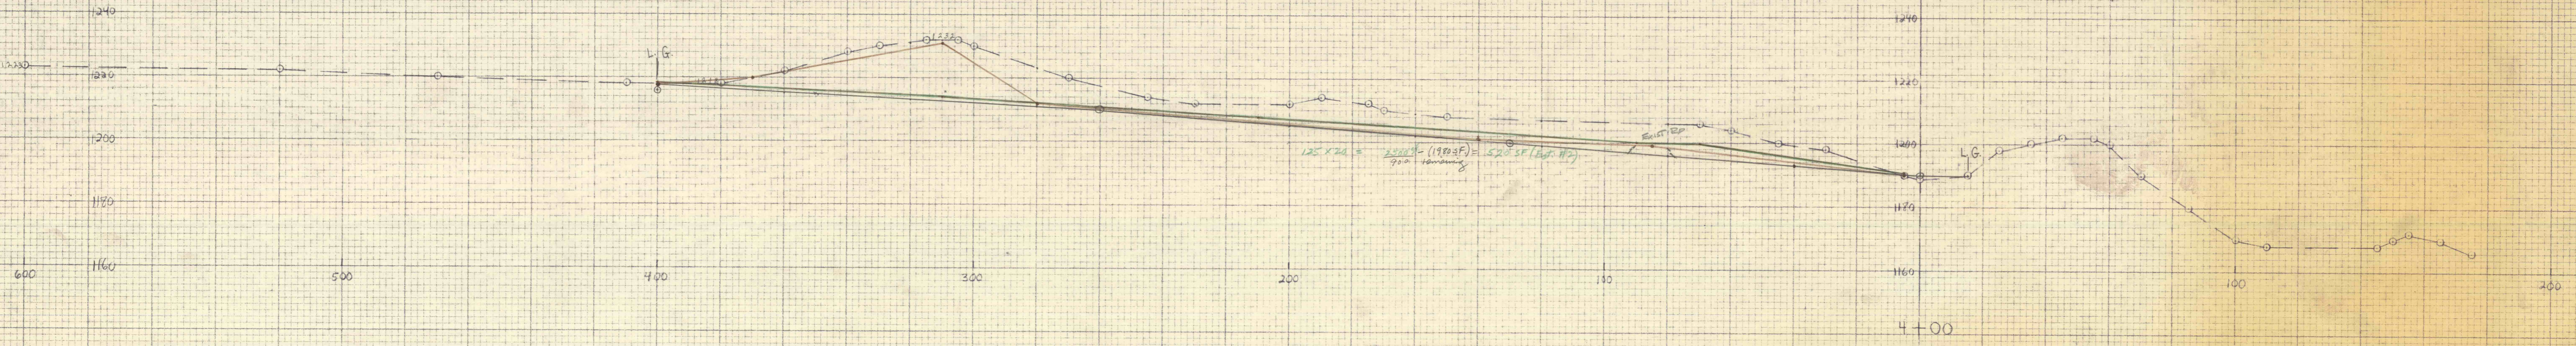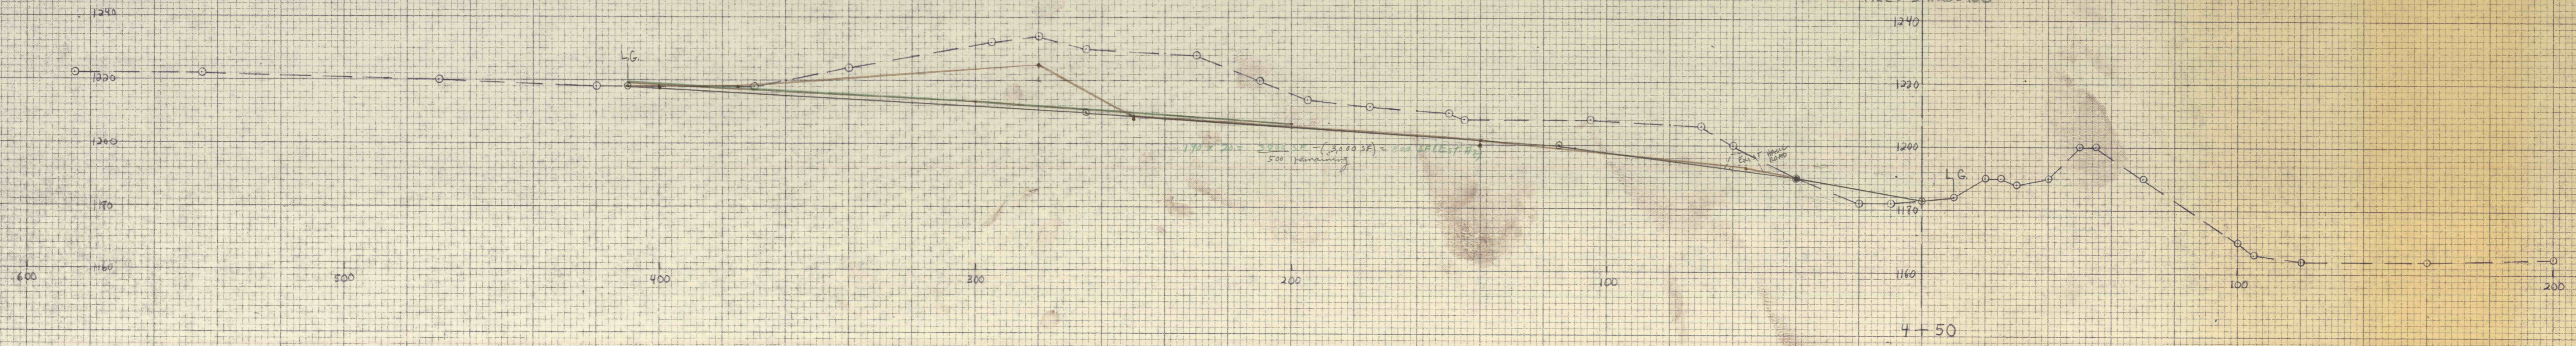

11531-1E  
 0044  
 0044  
 0044

PRINTED IN U.S.A.

EUGENE OETZGEN CO.  
 10 x 15 - ONE INCH  
 PERFECT - CROSS SECTION

PRINTED IN U.S.A.

EUGENE OETZGEN CO.  
 10 x 15 - ONE INCH  
 PERFECT - CROSS SECTION

11531-1E  
 0044  
 0044  
 0044