


3-50

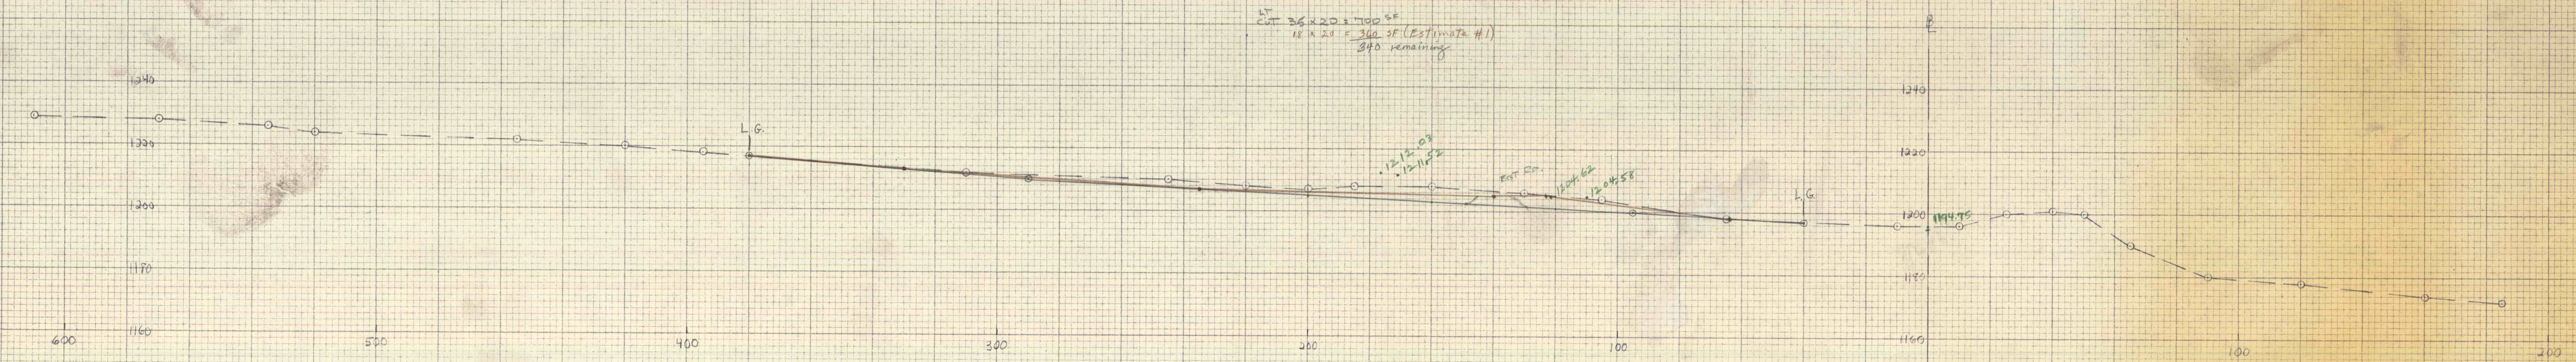

3-00