



CUT LT = 215 x 20 = 4300 SF  
 150 x 20 = 3000 SF (Estimate #1)  
 (160) 1,300 remaining

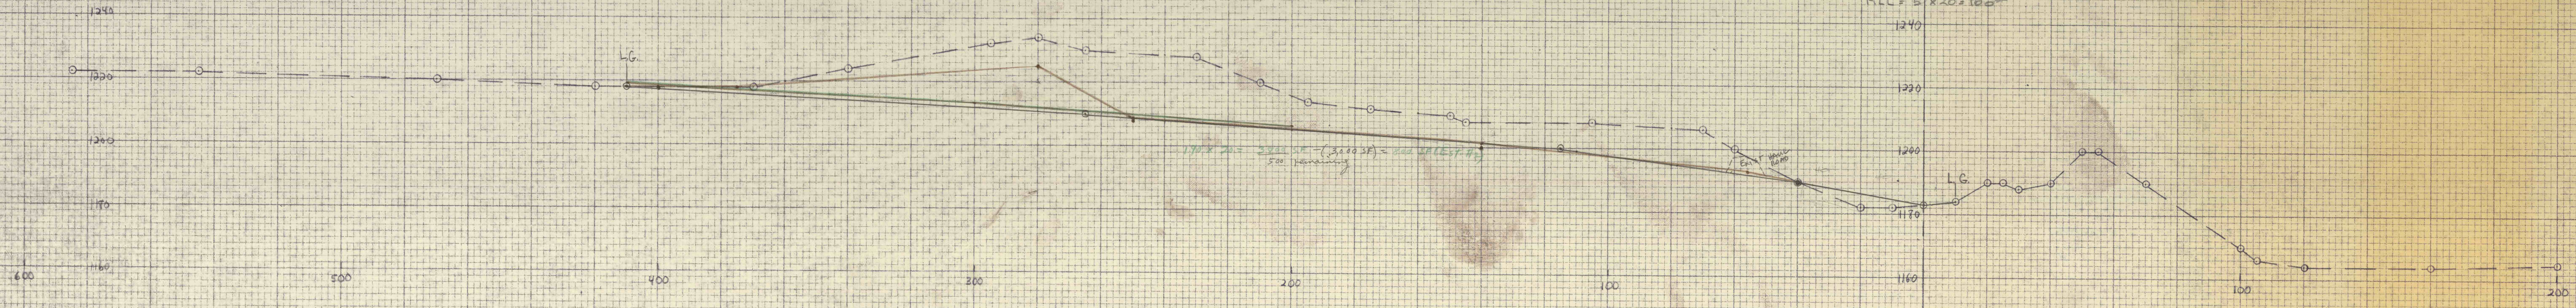

FULL = 5 x 20 = 100 SF

4+50

CUT LT = 170 x 20 = 3400 SF  
 99 x 20 = 1980 SF (Estimate #1)  
 (105) 1,420 remaining

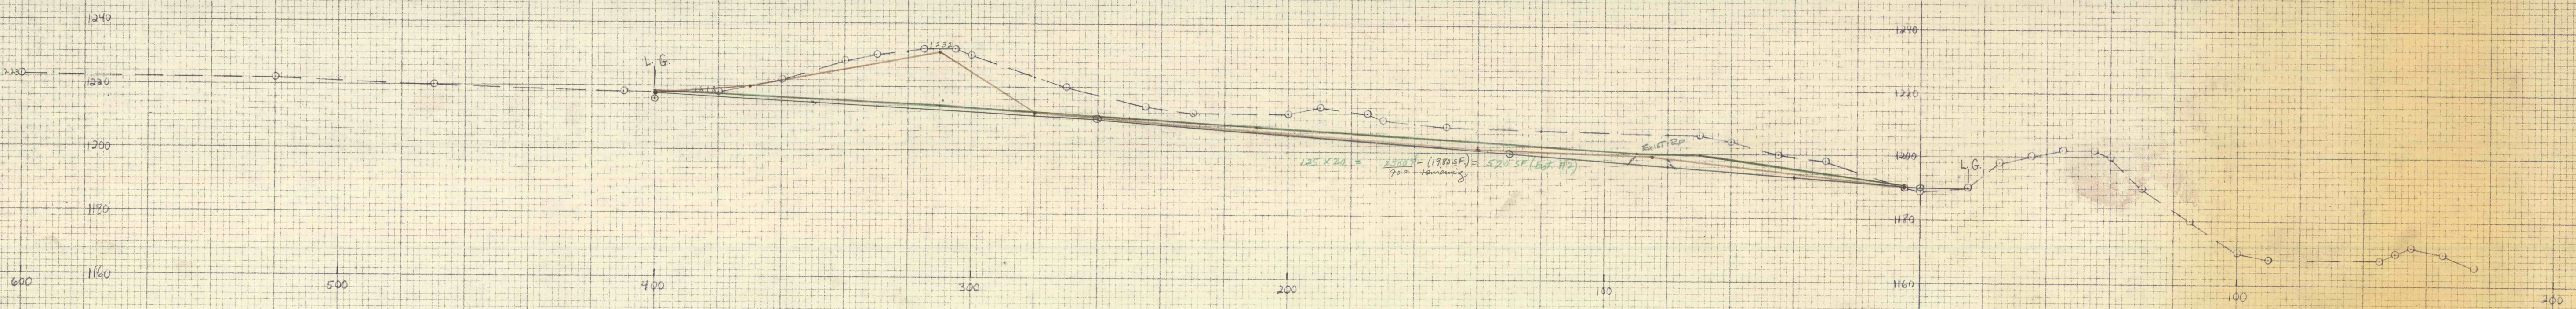

4+00

11851-156

PRINTED IN U.S.A.

ENGINEER-DIETZEN CO.  
 1010 - ONE BLOCK  
 "PERFECT" CROSS SECTION

PRINTED IN U.S.A.

ENGINEER-DIETZEN CO.  
 1010 - ONE BLOCK  
 "PERFECT" CROSS SECTION

11851-156